


H 787

A. A. 1 class

Midship Section
of
Screw Steam Vessel

N^o 20
Rev 5/1/66 & 72/66

Scale 1/2 In. = 1 Foot.

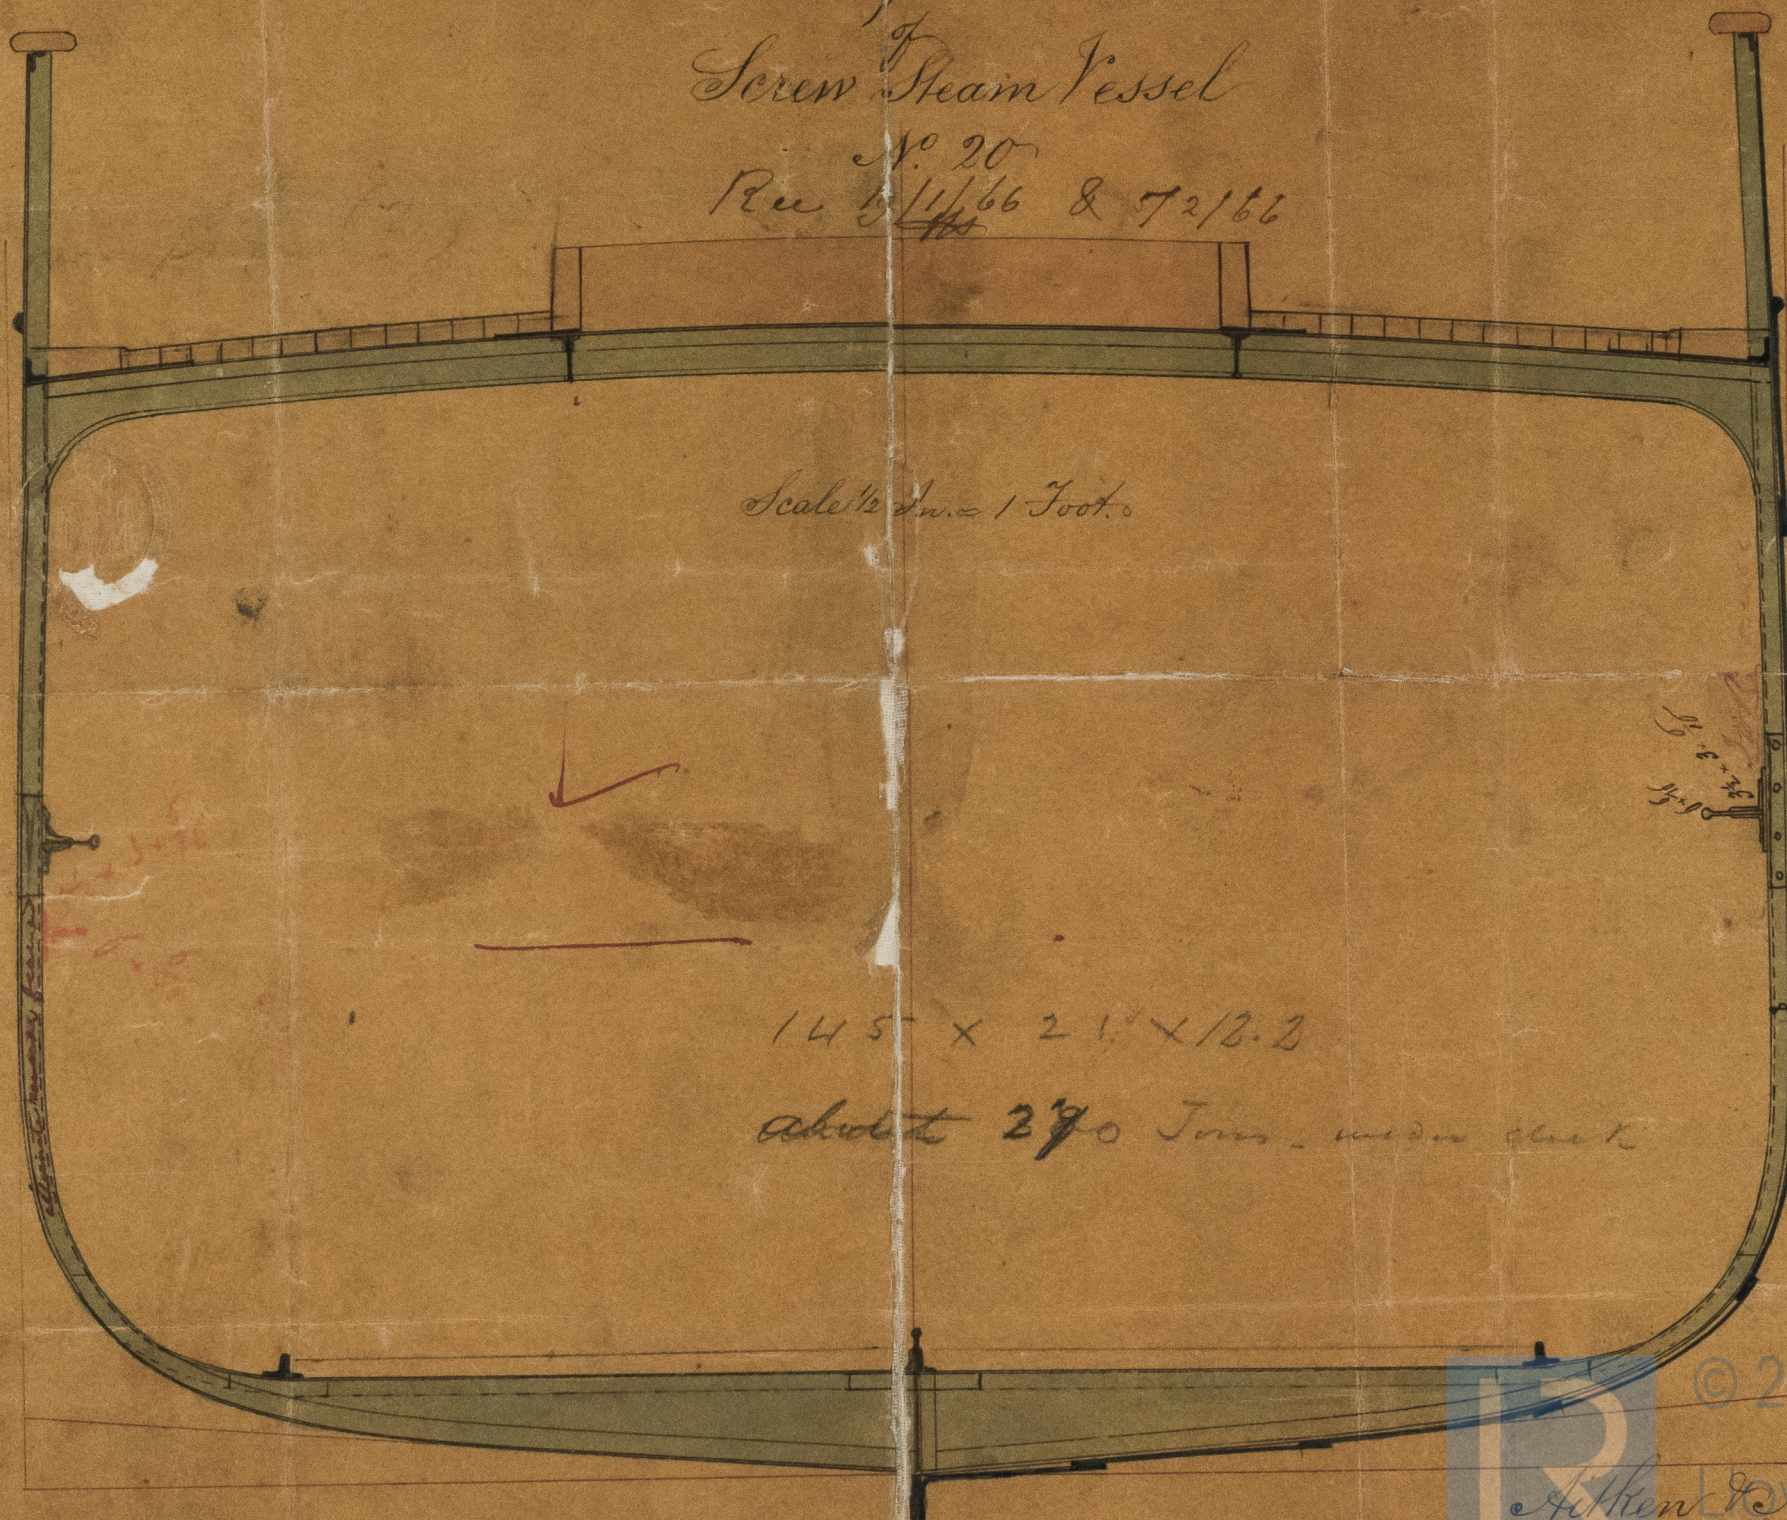

145' x 21' x 12.2

about 270 Tons - iron class

Plate 10. 76
1/2 x 9

Height of Reverse
Bars on alternate
frames

© 2021
Lloyd's Register
Whiteinch 11/1/66.
Letter C/2/66

IRON 500-0006

IRON 500-0007