


N^o. 101.

Length on Load Line $17\frac{1}{5}$ " 0
 Breadth Moulded 25 " 0
 Depth of Hold 14 " 0
 Length Covered in Aft $7\frac{1}{2}$ " 6
 Tonnage under Beams about - 441
 Tonnage - Gross about - 531
 Scale $\frac{1}{2}$ " = 1 FOOT.

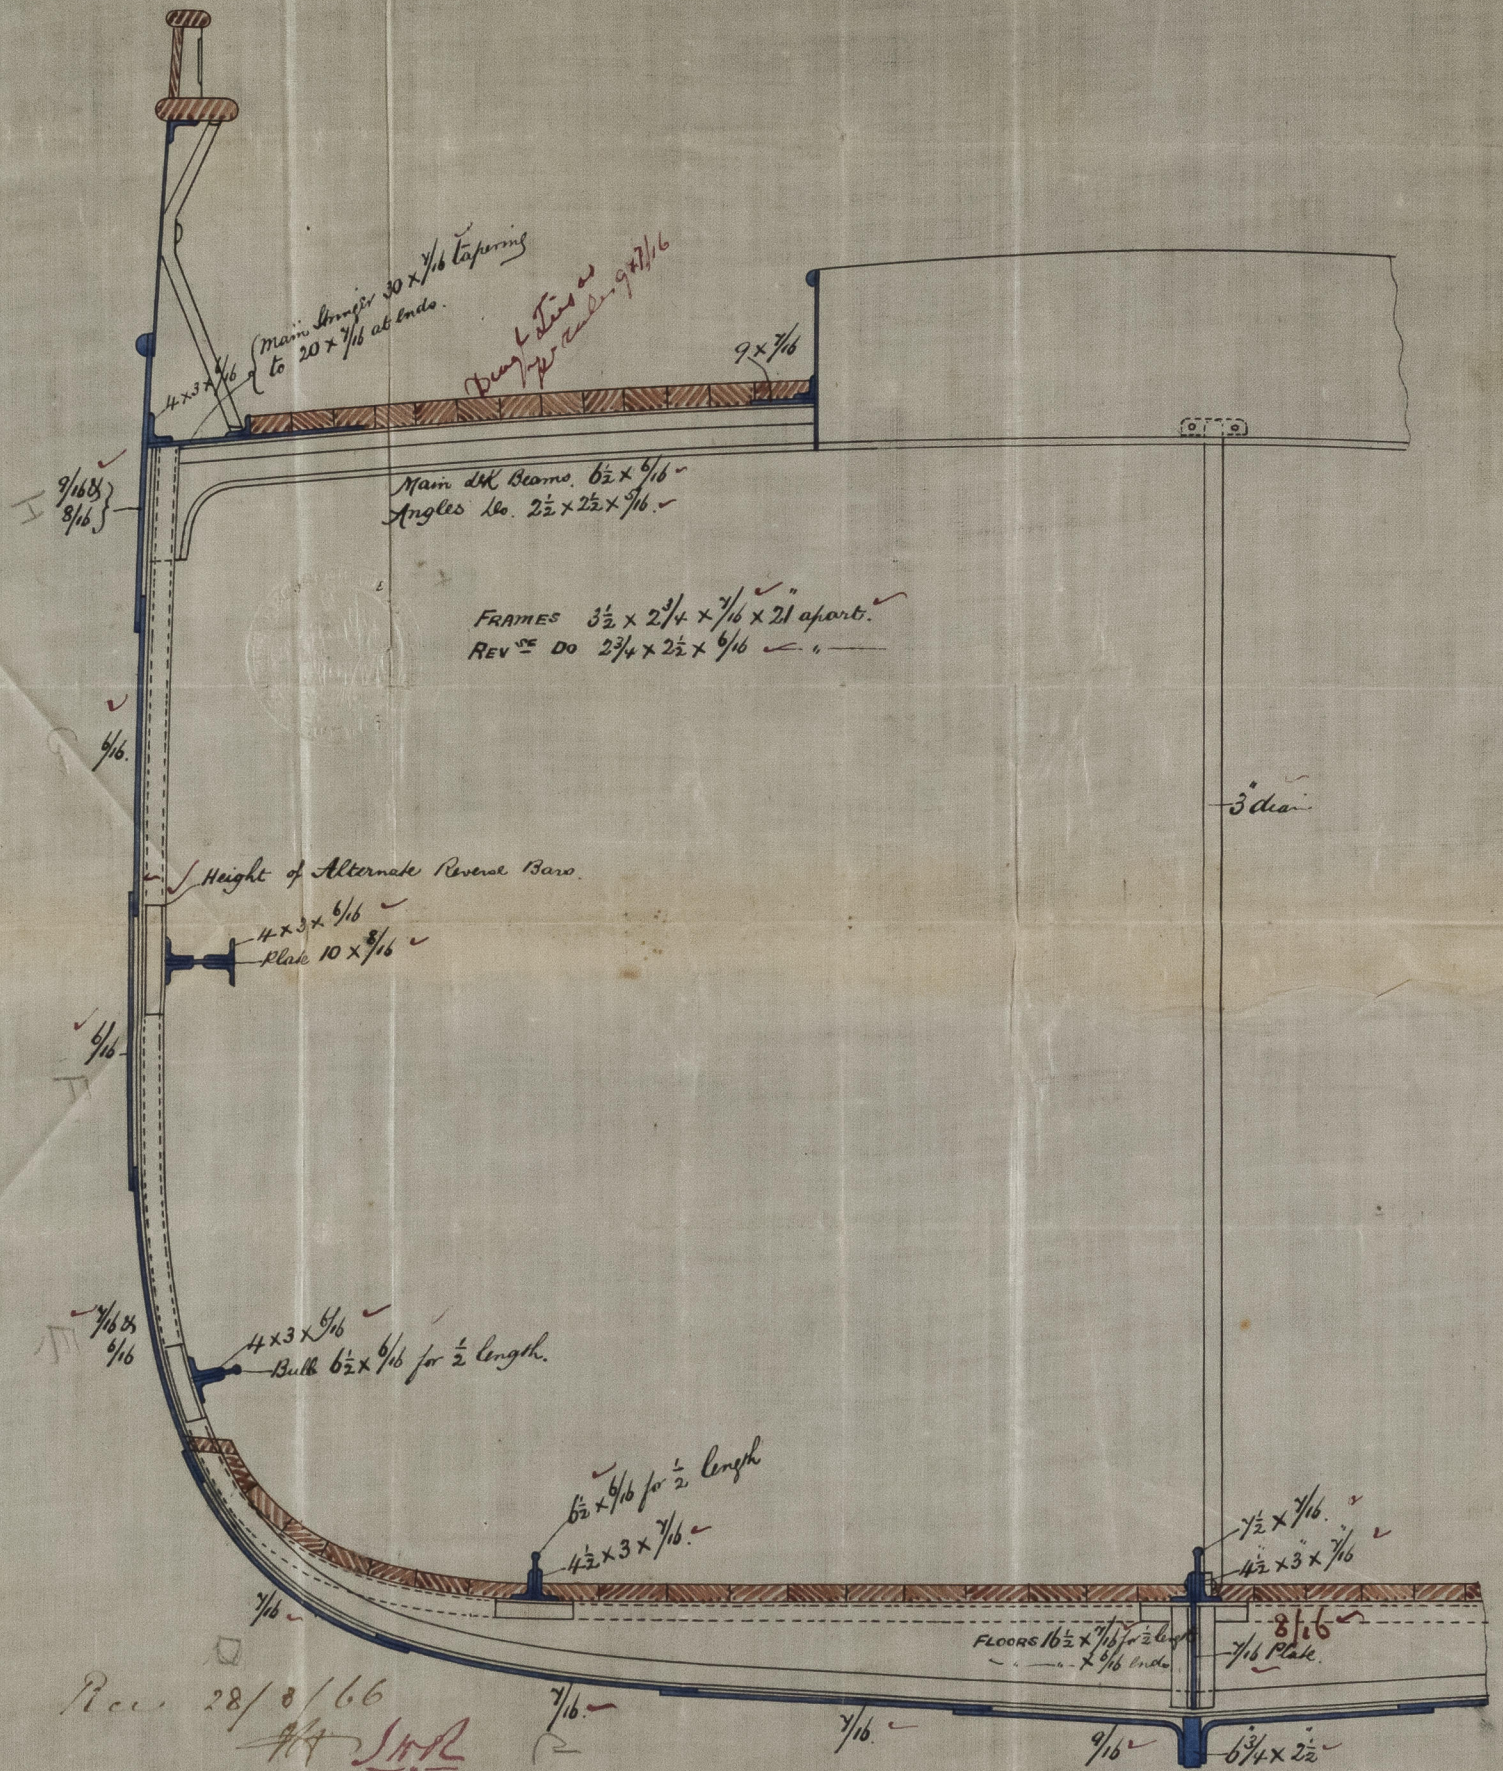

Rev 28/8/66
 J. H. L.
 25.3.66



© 2021

Lloyd's Register
 Foundation


11010500-0022

9

4894

Iron

IRONSDO-0022

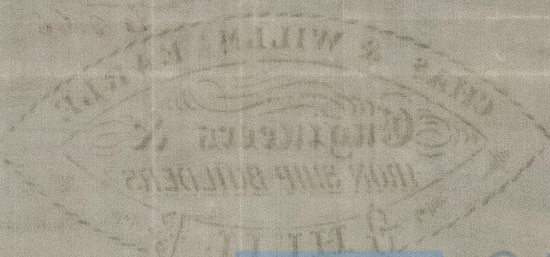

© 2021

Lloyd's Register
Foundation