

Length 220

Beam 28. = $7\frac{7}{8}$ to length

Scale 2 inch to foot

Depth 15.6 = $14\frac{1}{4}$ - nearly

Formage
under deck
Deck house

620


60

680

Gross.

B. ✓

S. S. Order No. 542

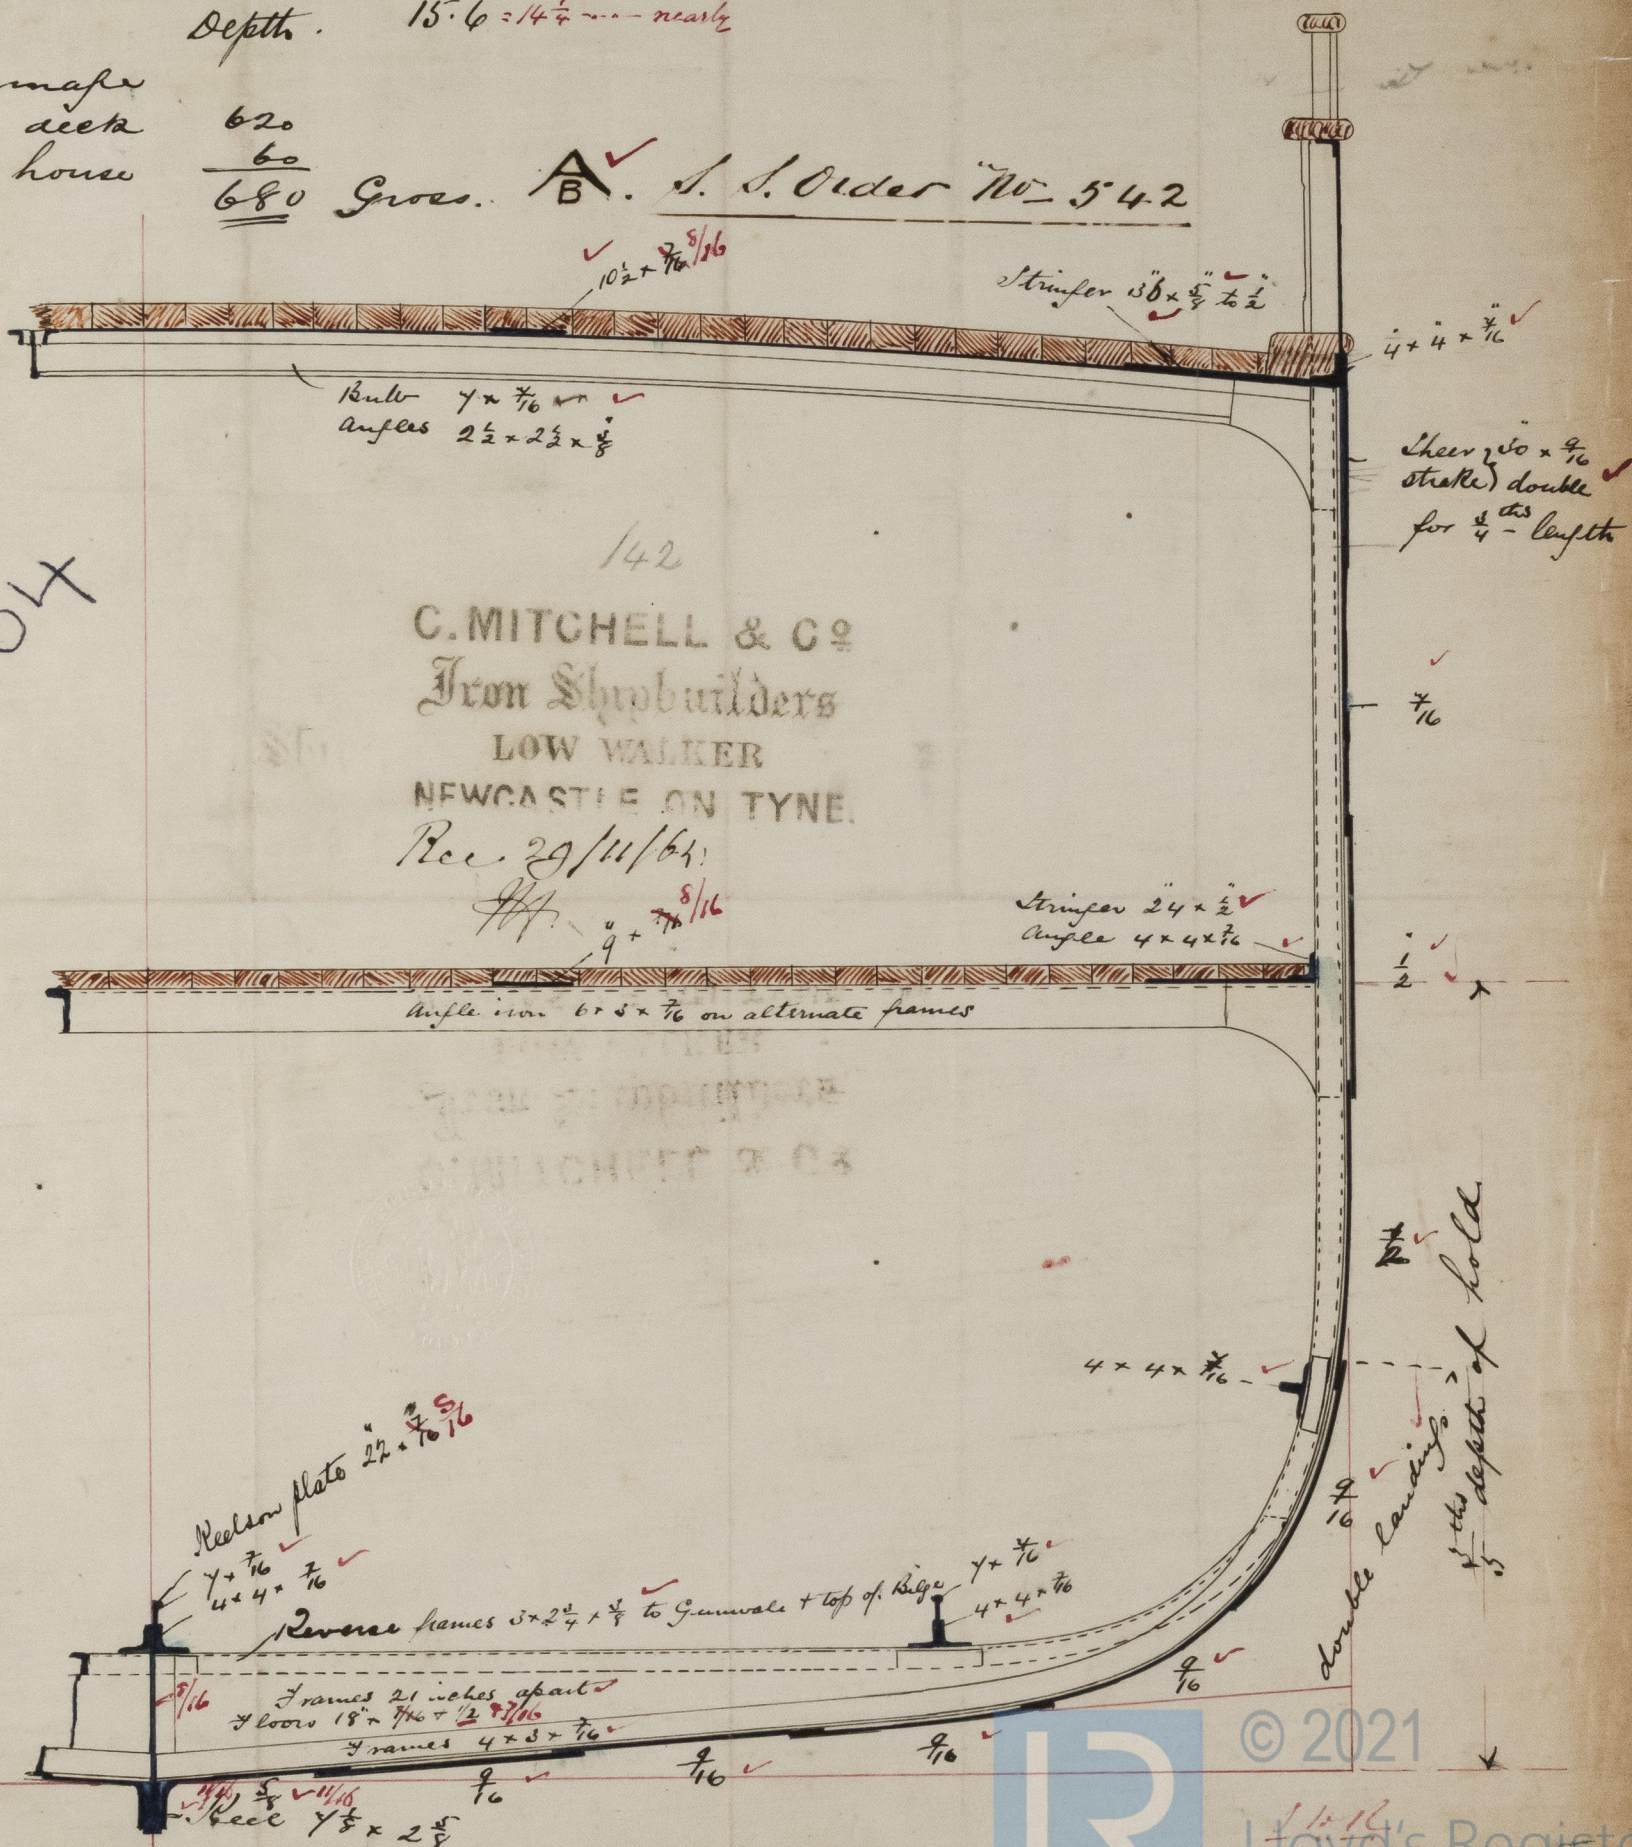

C. MITCHELL & CO
Iron Shipbuilders
LOW WALKER
NEWCASTLE ON TYNE.

Rec. 29/11/64

H. 8/16

Angle iron 6 x 5 x 7/16 on alternate frames

Reelion plate 22 x 7/16

Reverse frames 3 x 2 1/4 x 1/4 to Gunwale + top of Ridge

Frames 21 inches apart
Floors 18 x 7/16 + 1/2

Frames 4 x 3 x 7/16

Reel 7 x 5 x 2 5/8

IRONS00-0030

© 2021

Lloyd's Register
Foundation