


Half Midship Section  
Thracian (No 19)

Scale  $\frac{1}{2}$  inch = 1 foot

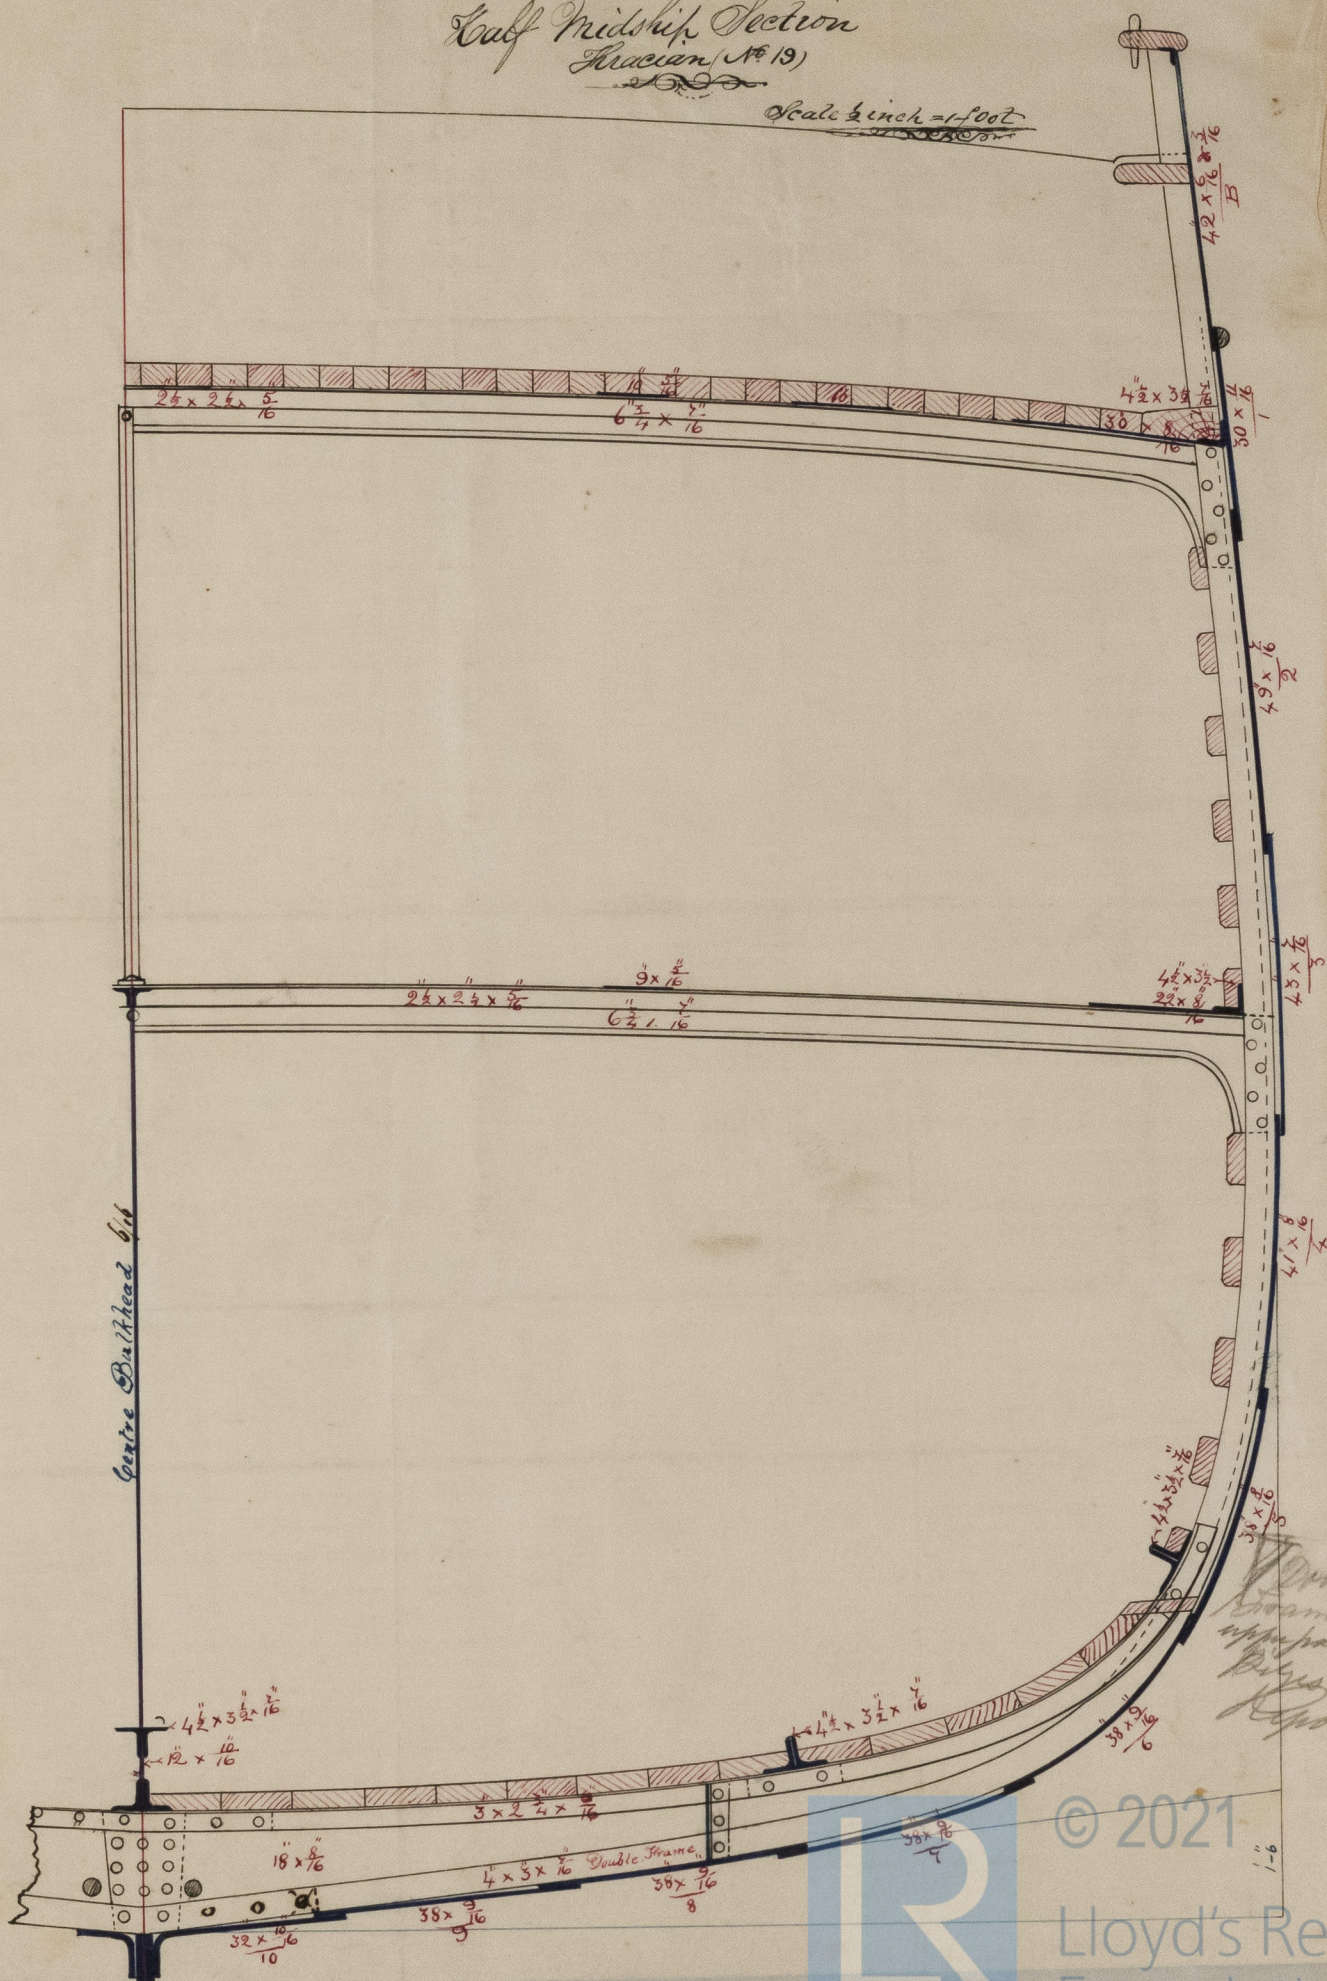

✓ Order  
Exames  
upprance  
Report

© 2021

Lloyd's Register  
Foundation

IRONS00-0048