


S.S. $h=30$ 5119 Iron

J. P. Swan
23rd May/00

Length 65 ft
B.H. 18
Depth 4.4

Gunnwale Bars $3 \times 2\frac{1}{2} \times \frac{5}{16}$
Stringer Plates $12 \times \frac{5}{16}$
Belt Bars $2\frac{1}{4} \times 2\frac{1}{4} \times \frac{1}{16}$
Belts Elm $5 \times 3\frac{1}{2}$
with Cape Iron $2\frac{1}{2} \times \frac{1}{8}$

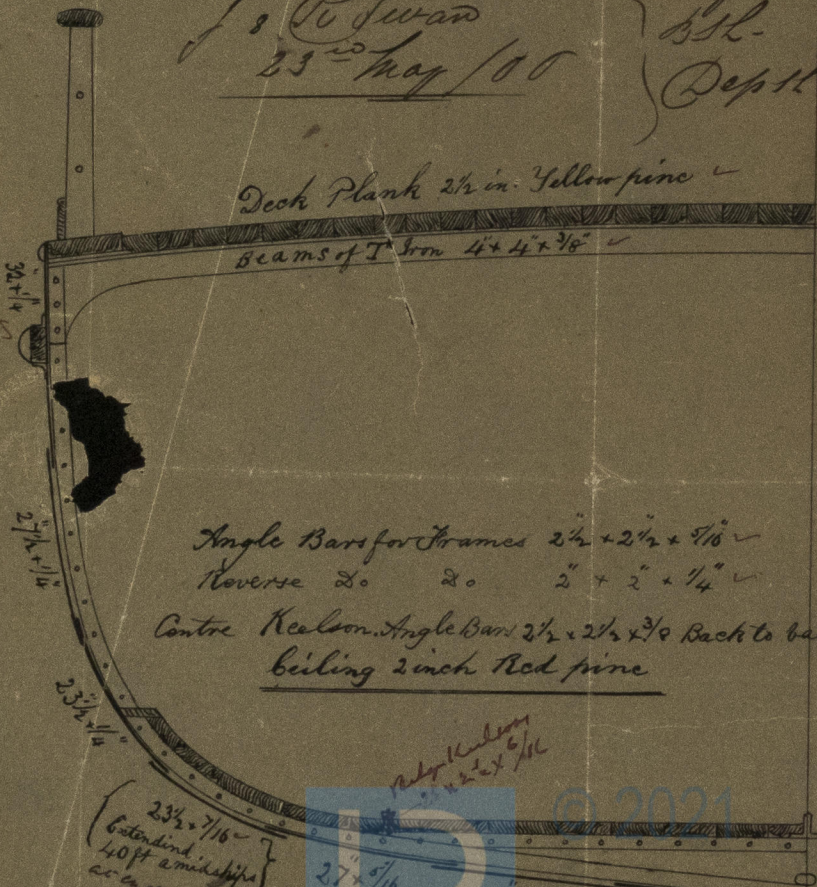

$23\frac{3}{4} \times \frac{7}{16}$
(Extending
40 ft a midships)
at end $\frac{1}{16}$

$27 \times \frac{5}{16}$

$28\frac{1}{2} \times \frac{5}{16}$

$33\frac{3}{4} \times \frac{7}{16}$
(Extending
40 ft a midships)

4×11 L

Keel 6 in

scale $\frac{1}{2}$ inch = one foot

IRON 500-0069