


5231 Iron Ship

Length keel & Fore Rake 128' 0" No. 158 Ship-
 Breadth ————— 21' 0" = 6 breadths to length
 Depth moulded 12' 0" Scale 1/2 inch = 1 foot
 Depth ————— 11' 5" = 11 1/2 depths to length


Größe - 199

Class $\frac{1}{2}$ S.S. order no. 579.

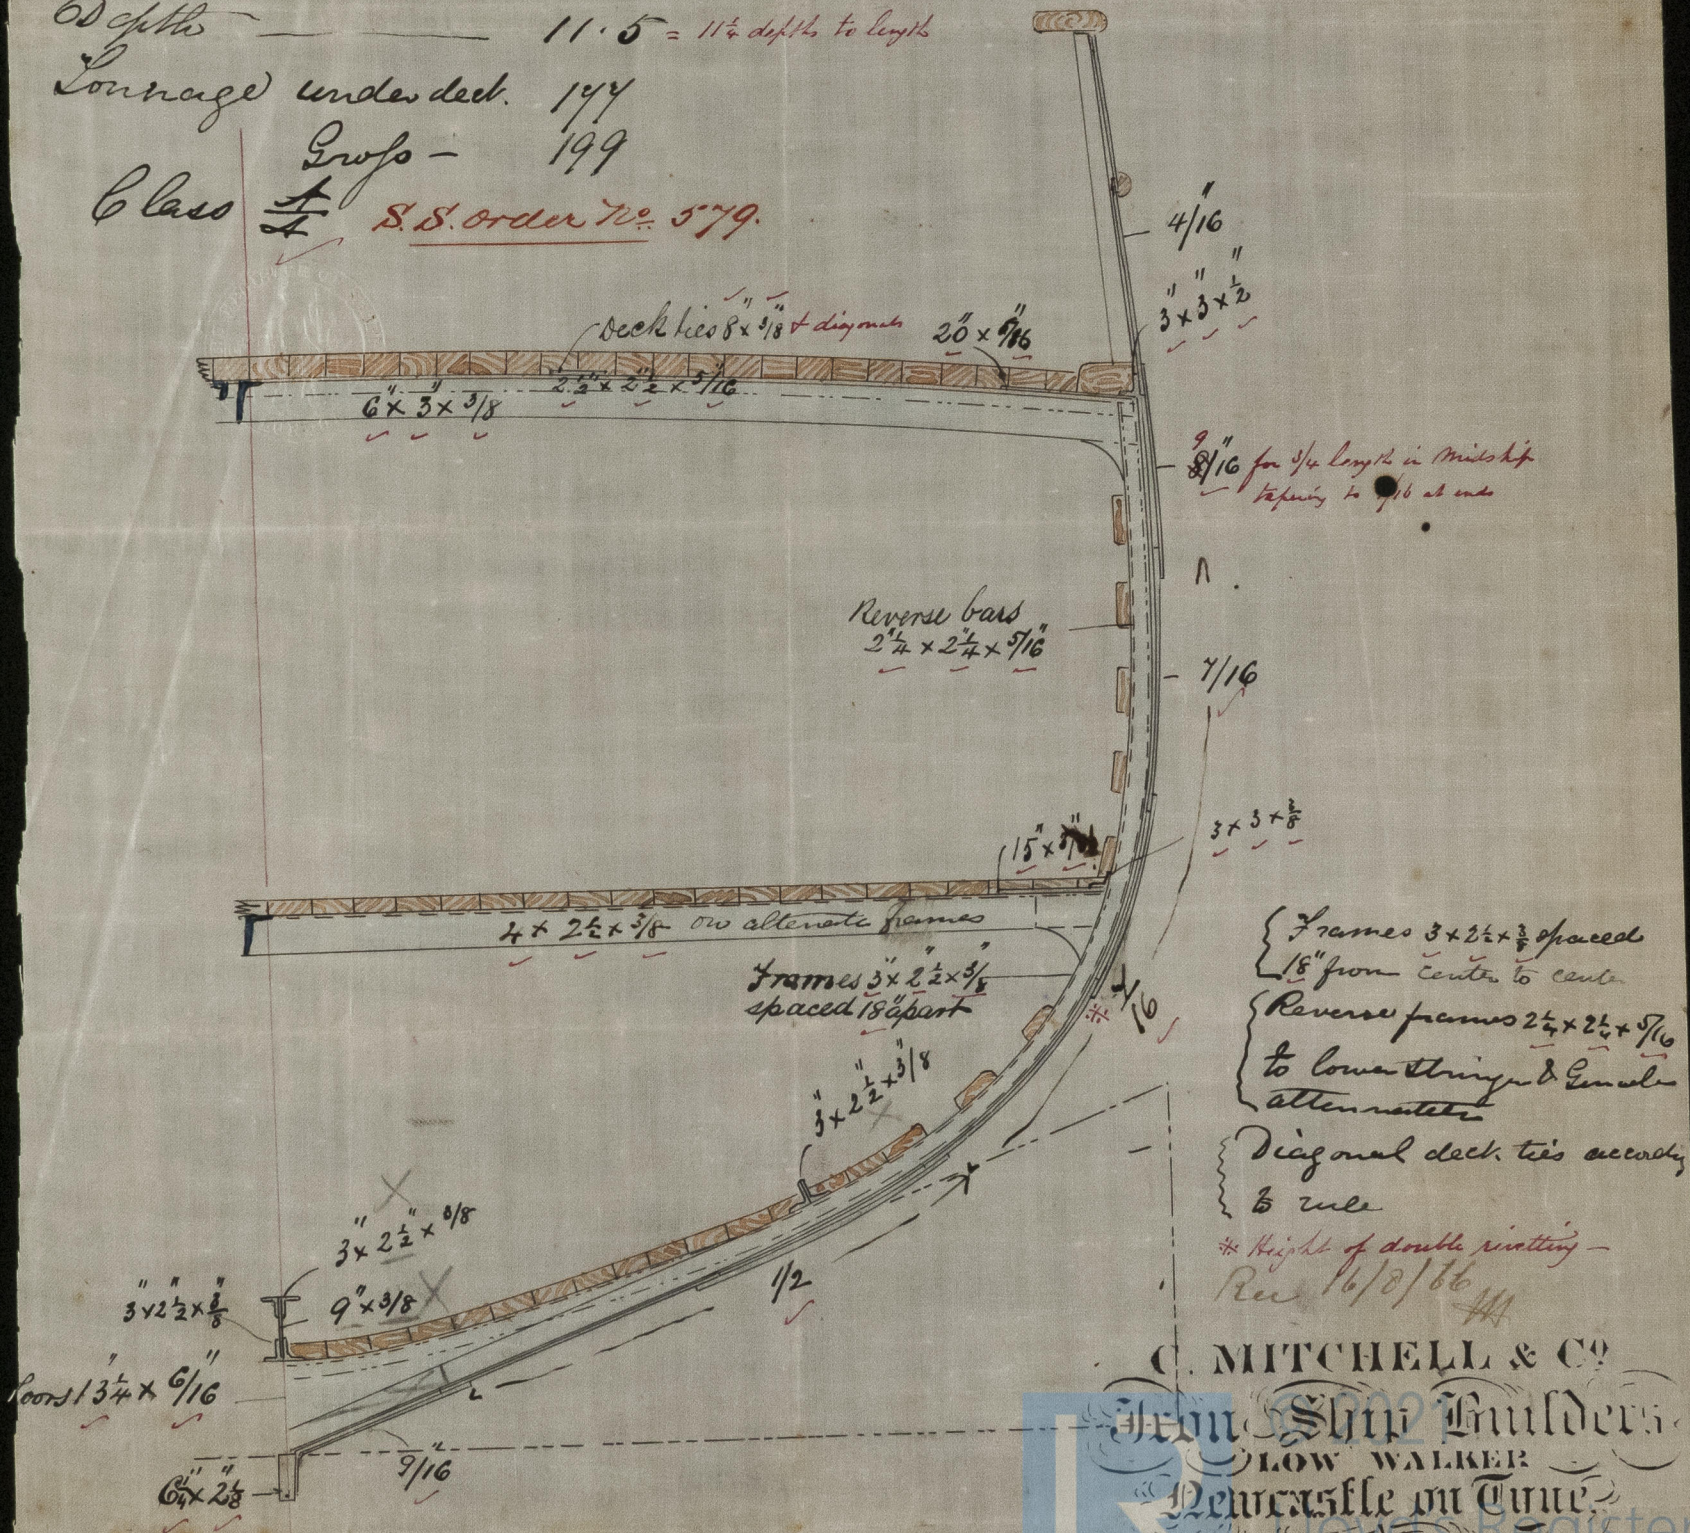

Rec^d
J.H.

IRON 500-0089