

2500

H Murray Ho

Port Glasgow

Rec 21/6/66

W

For lengthening
21 feet

$\frac{1}{2}B$ 9-	
$\frac{1}{2}B$ 16.66	
$\frac{1}{2}B$ 10.66	
<u>36.32</u>	36.32
63 + 21 = 84	
<u>10896</u>	<u>14850</u>
21792	29056
<u>320916</u>	<u>305000</u>

Frames $2\frac{1}{2} \times 2\frac{1}{2} \times \frac{3}{8}$ ✓ $2\frac{1}{2} \times 2\frac{1}{2} \times \frac{3}{8}$
 Reverse Bars on the Frames extend
 to upper part of Bilge & every alternate
 one to Gunwale $2\frac{1}{4} \times 2\frac{1}{4} \times \frac{3}{4}$ ✓ $2\frac{1}{4} \times 2\frac{1}{4} \times \frac{3}{4}$
 Wash Plates between every Frame
 $14\frac{1}{2} \times \frac{3}{16}$
 Lower Stern Post $6 \times 2\frac{1}{2}$ outer ✓ = 11-
 Stern Post $4\frac{1}{2} \times 2\frac{1}{2}$ ✓ = 11.25
 Keel = 12.25
 Bottom & lower edge of Sheer
 strake double riveted with $\frac{3}{8}$
 rivets, the rest single, Keel $\frac{3}{8}$ rivets

Length 66 feet
 Breadth 18 "
 Depth of Hold 9' 6"

About 75 Tons Gross


clap to

For lengthening 42 feet

36.32×108	
<u>108</u>	
18160	
<u>36320</u>	
381360	
<u>38136</u>	
419496	

Under 10 Depths.
 " 6 Breadths

Scale $\frac{1}{2}$ " = one foot

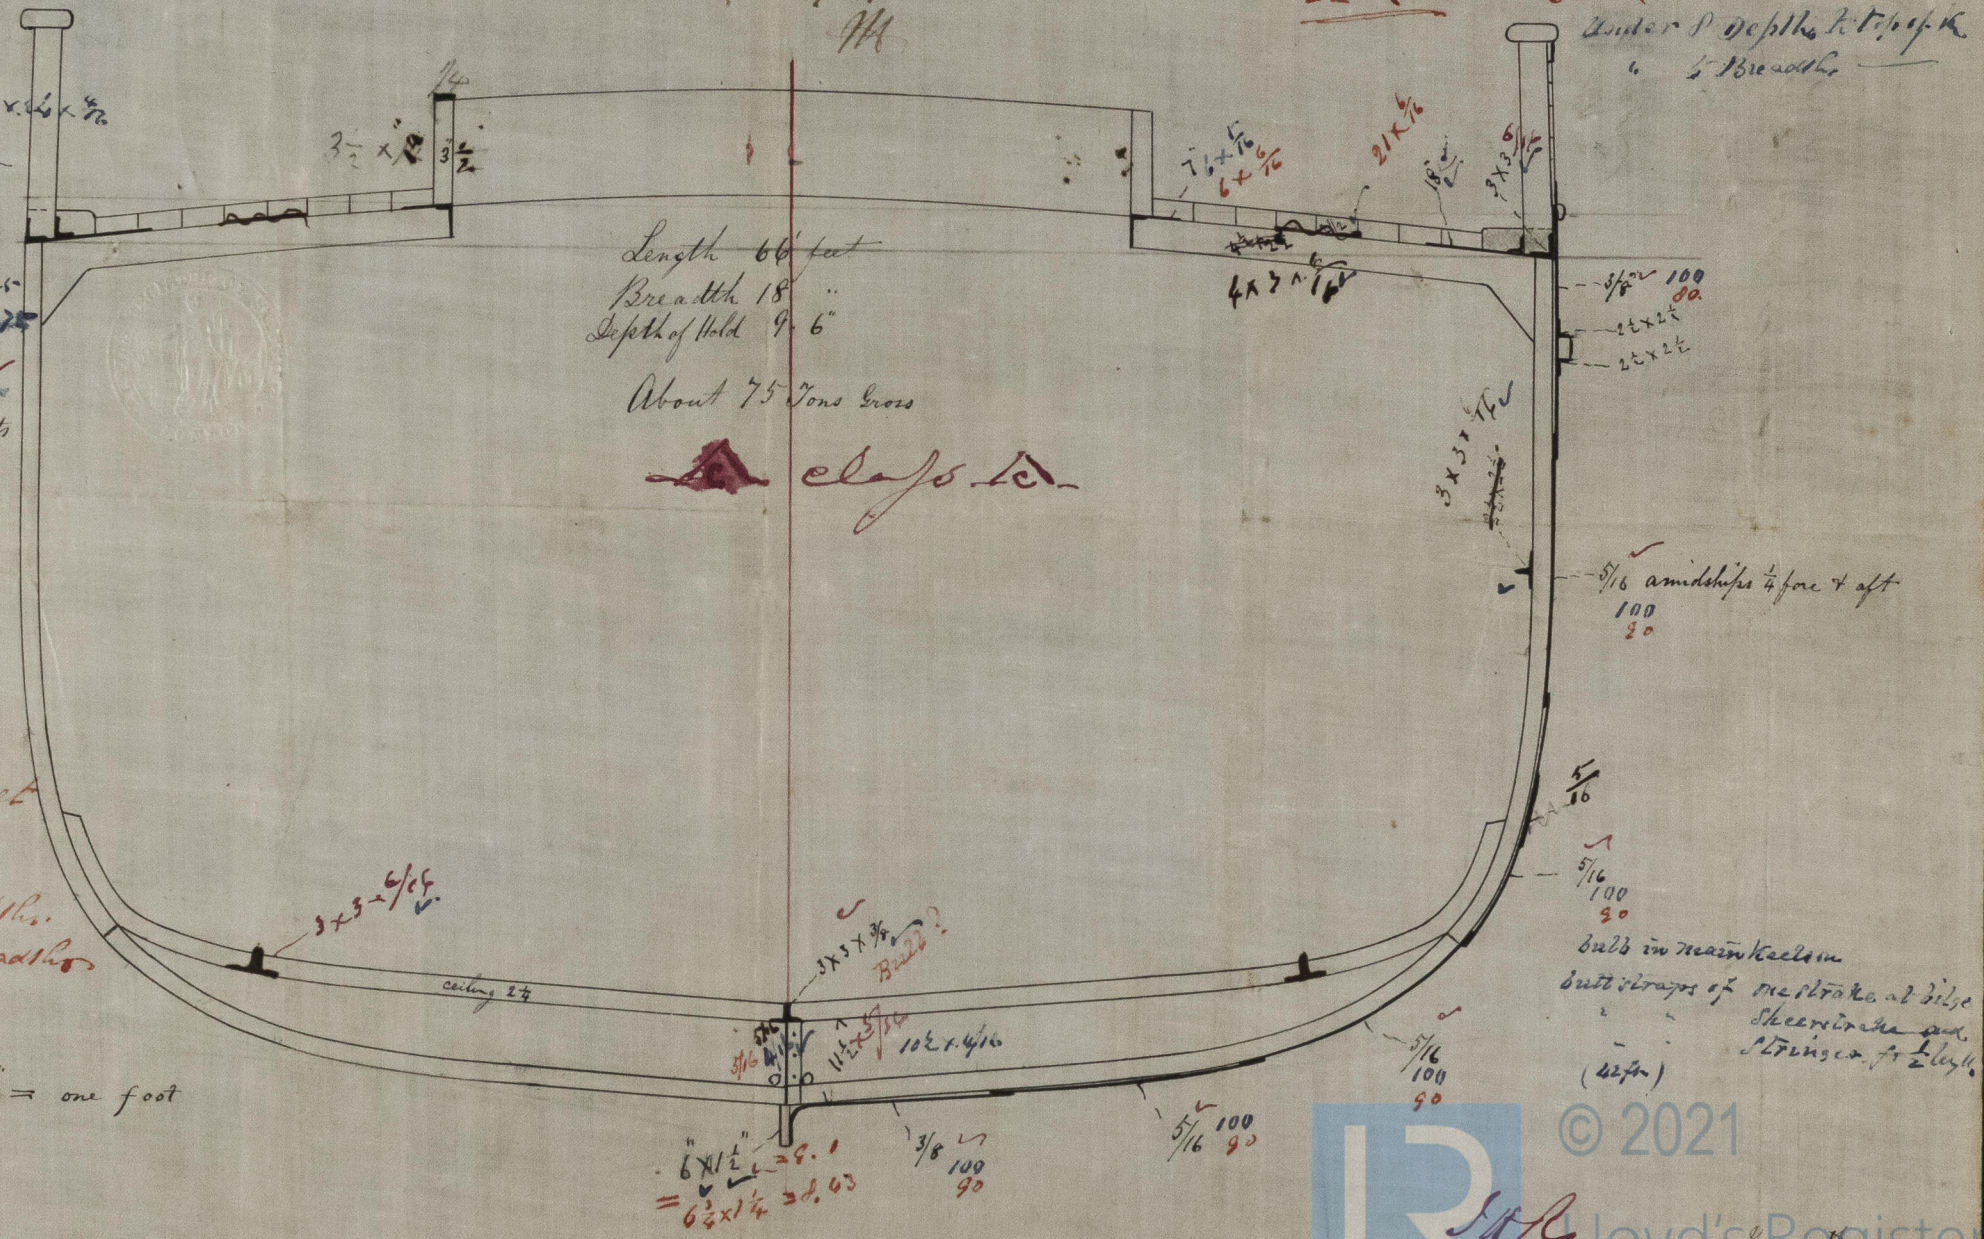

© 2021 Lloyd's Register Foundation

IRON 500-0090

5255 Son

IRON 500 0090



© 2021

Lloyd's Register
Foundation