


*Now being lengthened amidships forty five feet making
the length between perpendiculars about 247 feet*

**MIDSHIP SECTION
OF
S. S. DON ANTONIA.**

SCALE $\frac{1}{2}$ IN TO A FOOT.

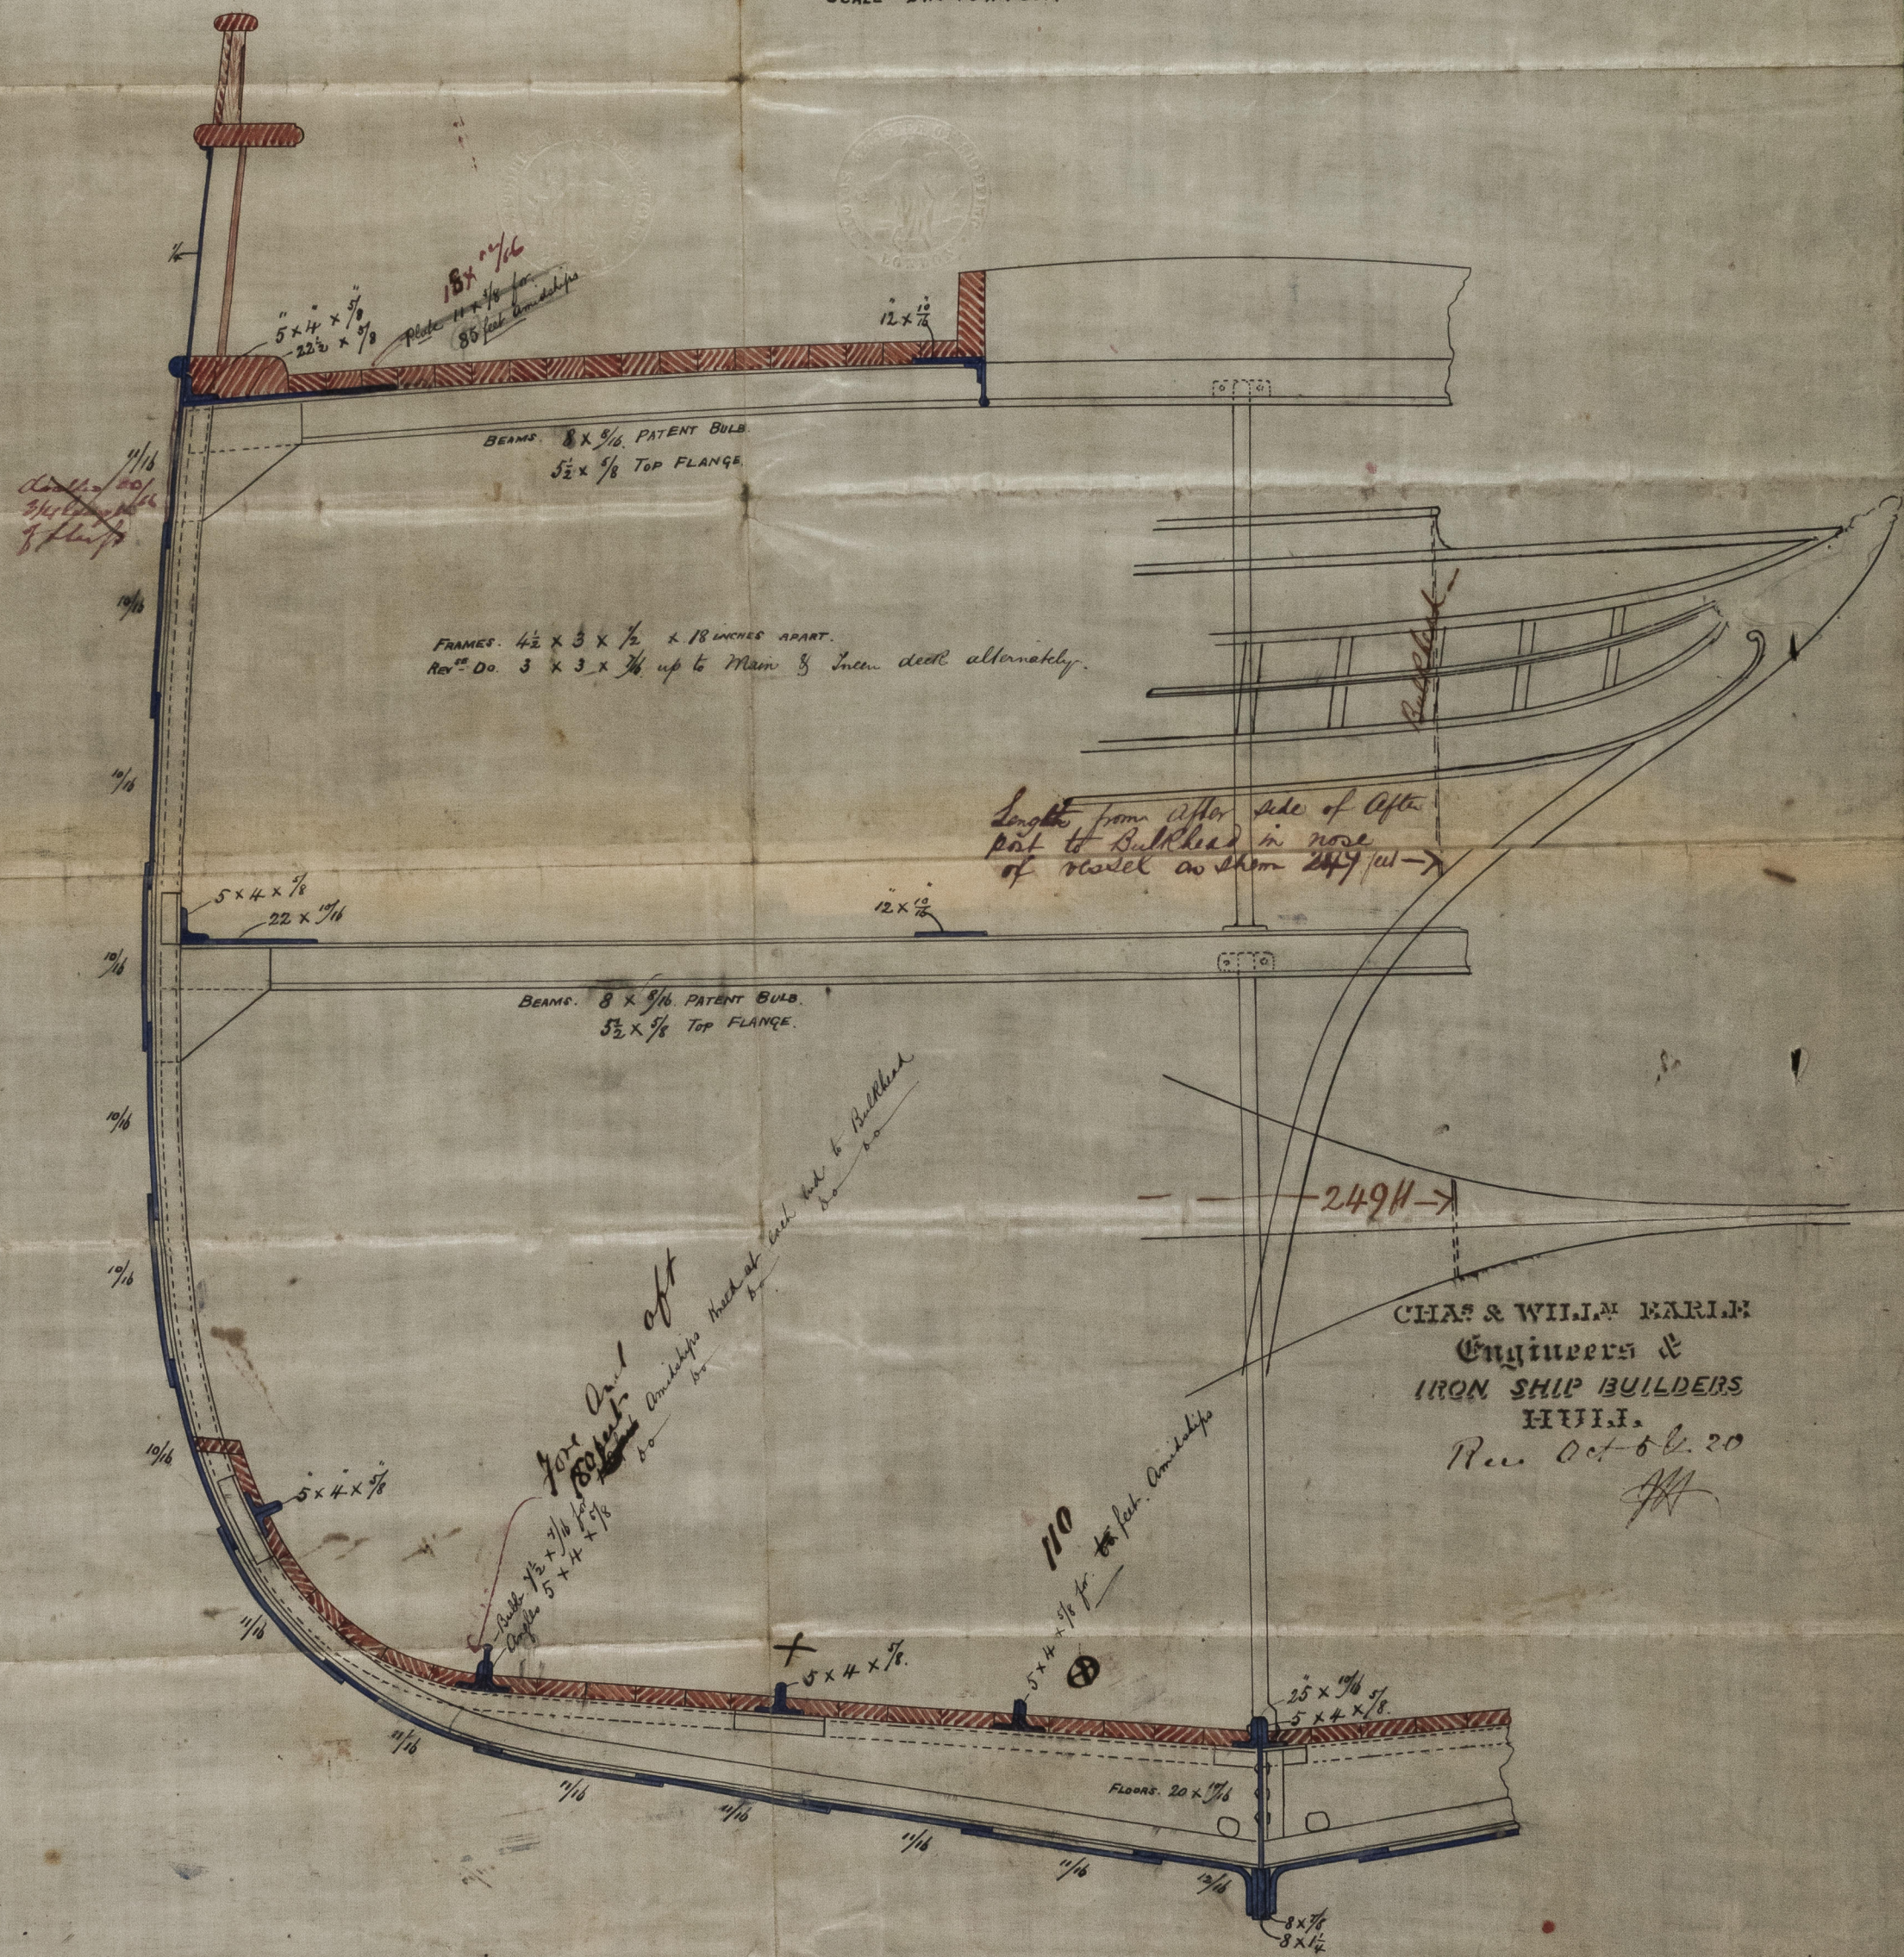

CHAS & WILLIAM KARL
Engineers &
IRON SHIP BUILDERS
HULL.
Rev. Oct 6. 20

11.9.66
24.10.66
2.11.66



© 2021
Lloyd's Register
Foundation

IRON500-0093