


8655C

N^o 17 I.S. MIDSHIP SECTION.

SCALE $\frac{1}{2}$ IN. = 1 FT.

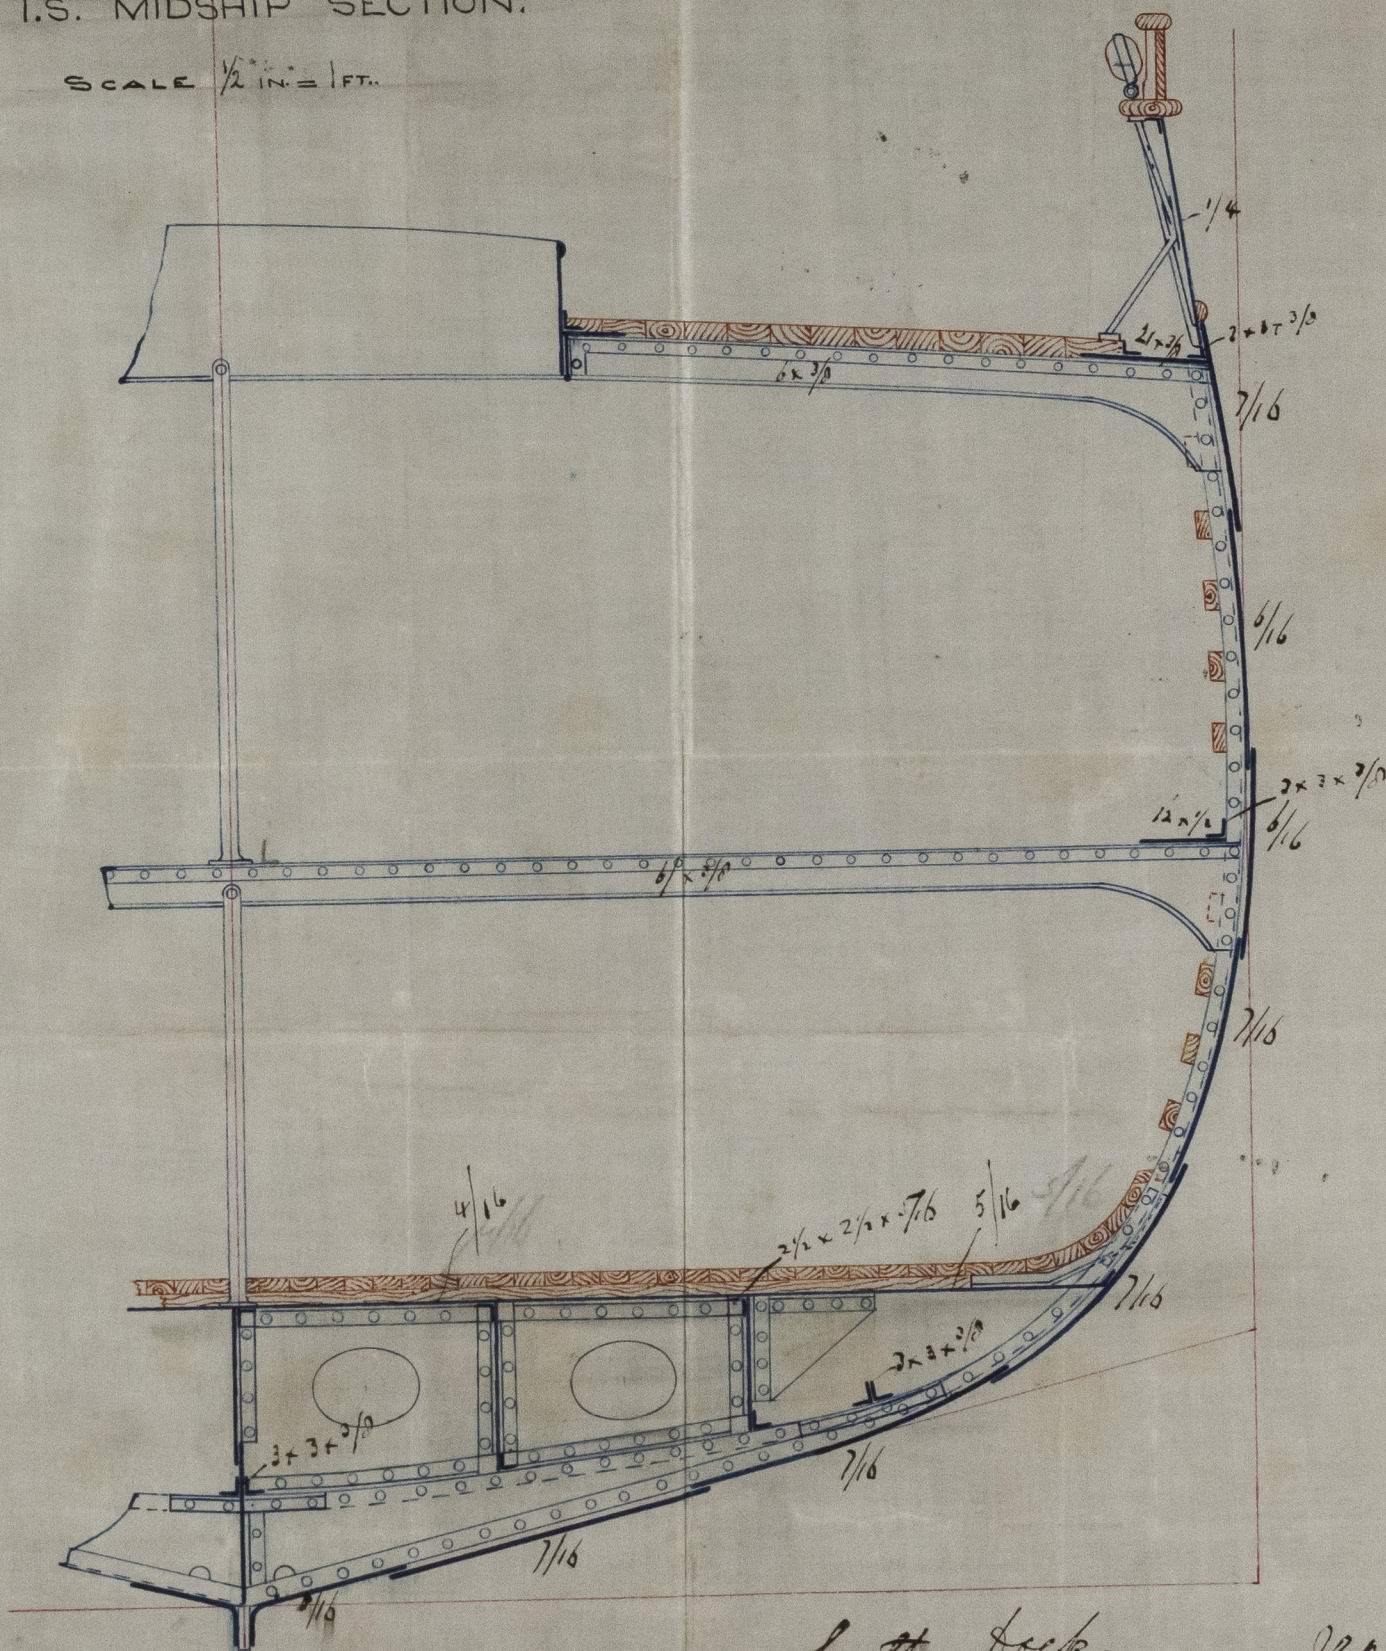

South Dock

London

April 2nd 1867

Wm. M. H. H. H.

IRONSIDE 0137

Lloyd's Register Foundation

