

4

577

Handwritten: 46




ROBERTSON & CO.
IRON SHIP BUILDERS
AND
ENGINEERS
GREENOCK

Greenock 17th May 1867.

© 2021
Lloyd's Register
Foundation

1202500-0198³/₁₃

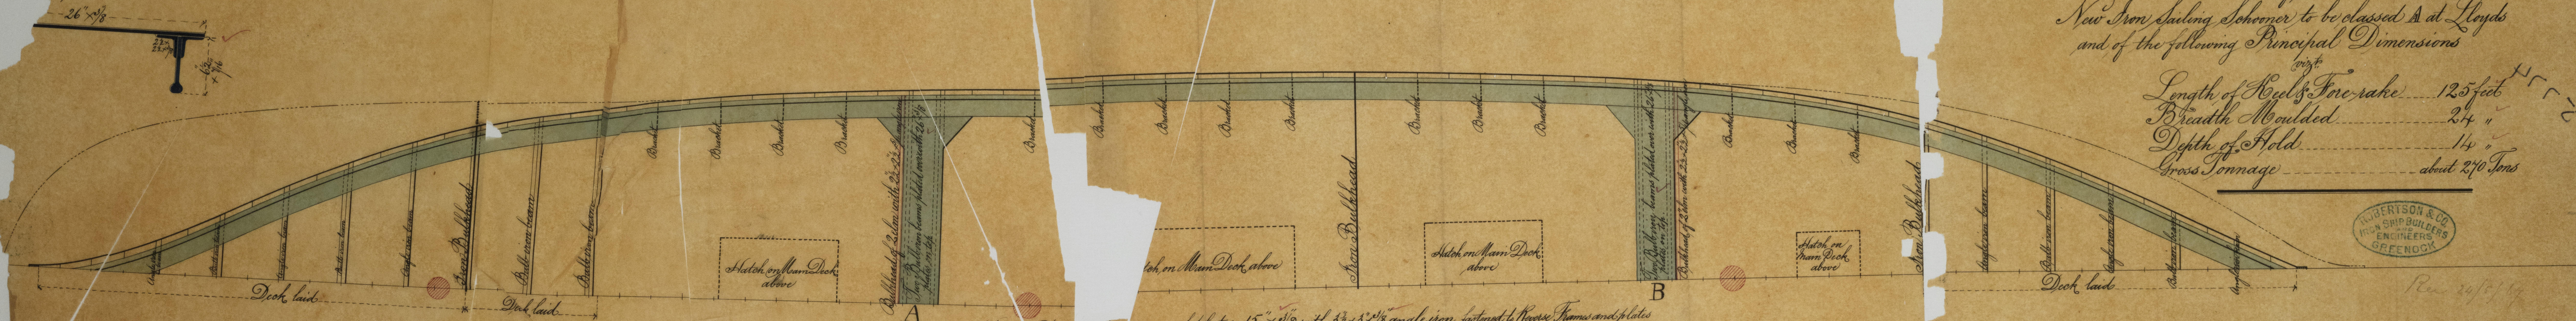

Lower Deck
Do.
Lower Deck
Do.

Stringer of plates $15 \times 3/8$ with $3 1/2 \times 3 \times 3/8$ angle iron fastened to Reverse frames and plates
do. required by rules " $13 1/2 \times 3/8$ " $3 \times 3 \times 3/8$ " " " " " " "
Beams of bulb iron $6 1/2 \times 1/4$ with two angle irons each $2 1/2 \times 2 1/2 \times 3/8$ rivetted on upper edge
do. required by rules " " $6 \times 3/8$ " " " " $2 1/4 \times 2 1/4 \times 1/16$ " " " "

IRONSDON 0198²/3

IRON 500-0198 1/3