No. 45

Paddle Steam Tug.

MIDSHIP. SECTION.

1/2". Scale.

10'-6" x 18'-6" x 10" Will Register about 120 Tons

C S.S. Order No. 588.

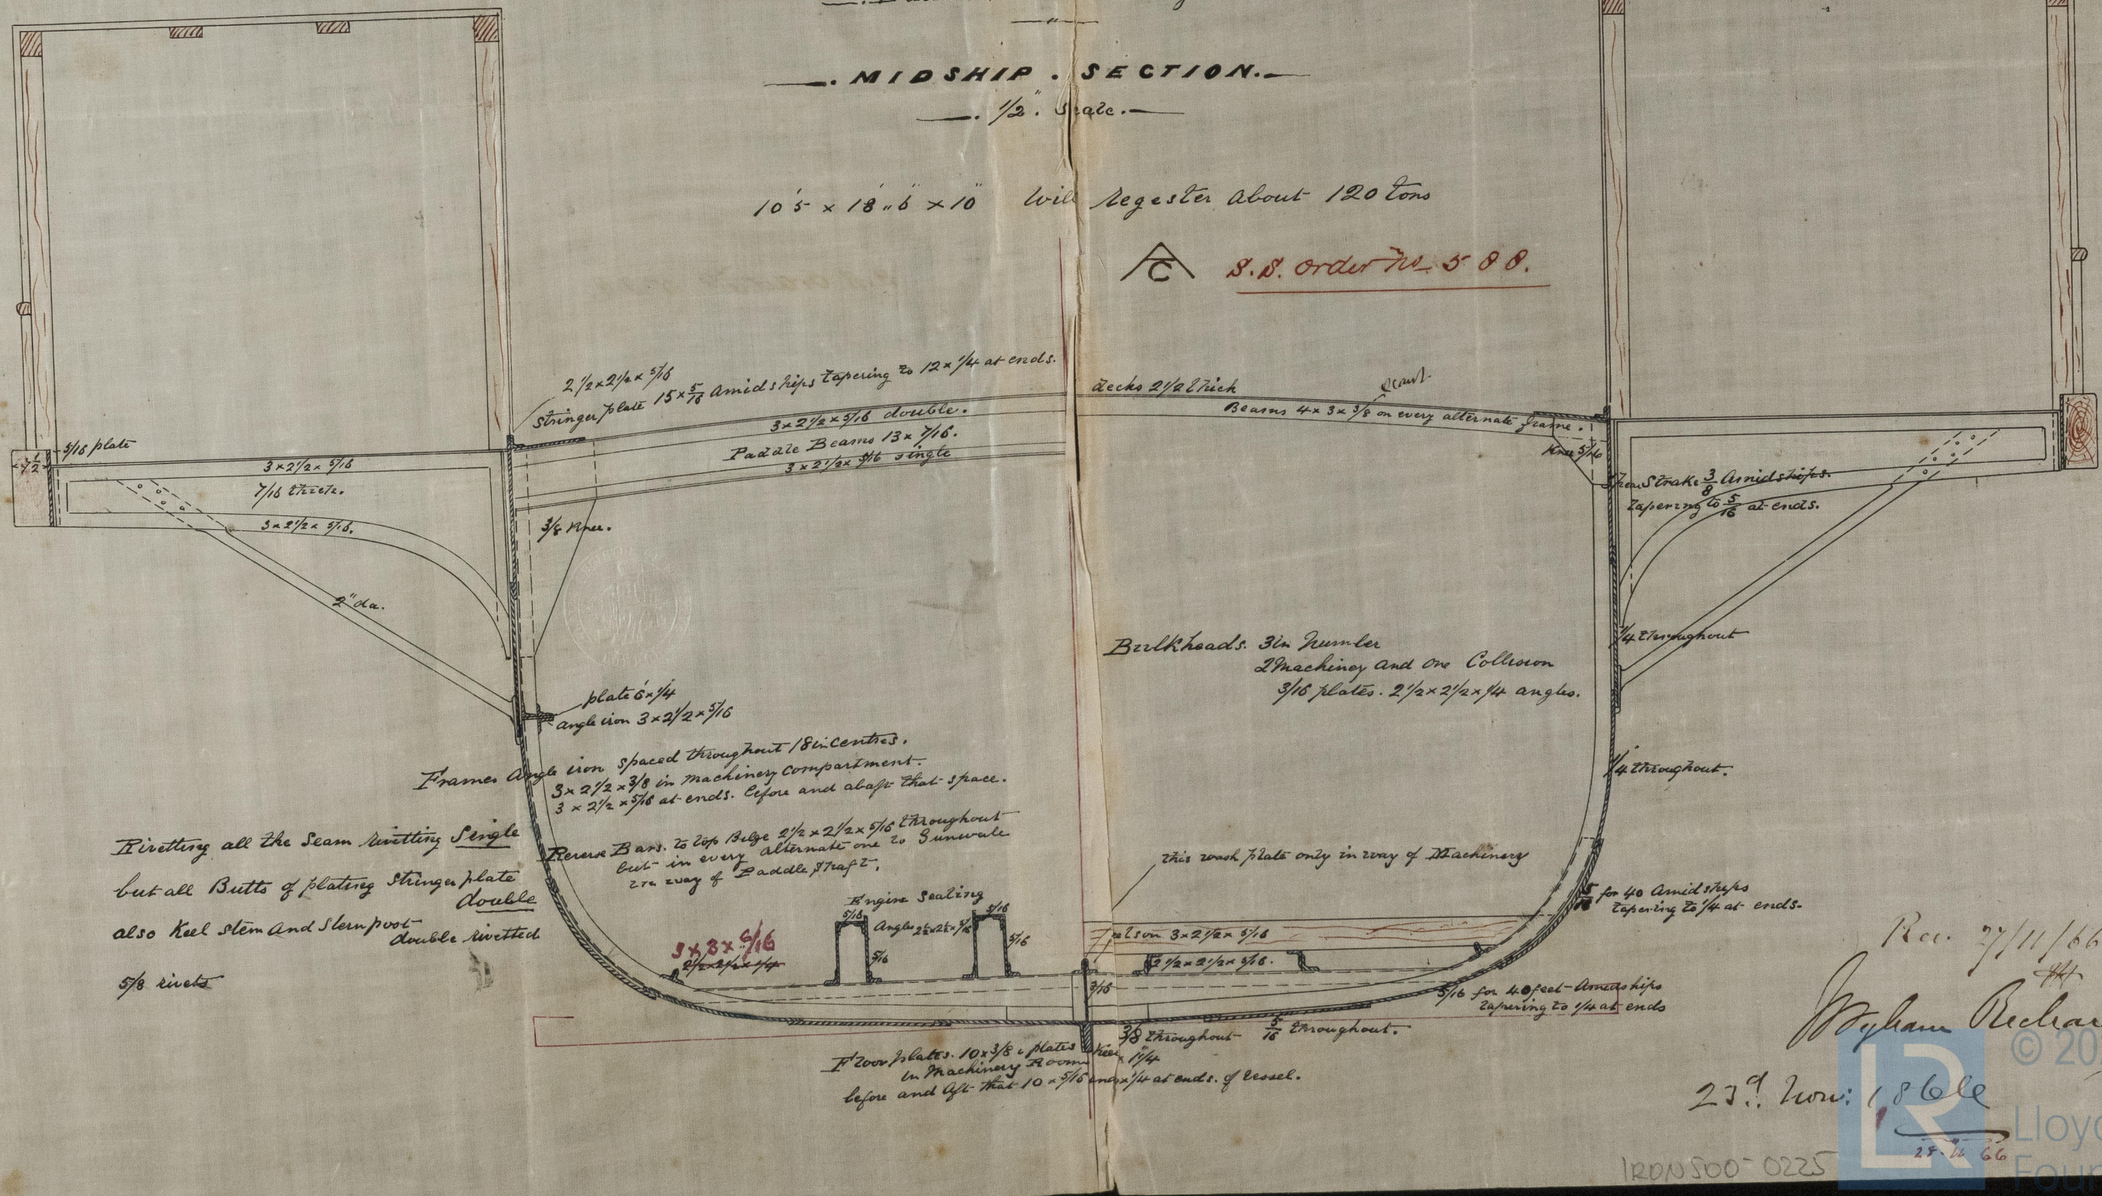

Rec. 27/11/66 & 5/12/66

William Richardson & Co

27th Nov: 1866

25. 12. 66

IRDN500-0225

© 2022 Lloyd's Register Foundation