

Scale $\frac{3}{4}$ inch = 1 foot


Gross Section of Cargo Hatch

Island off

Rev 4/12/64


RA

Main Deck

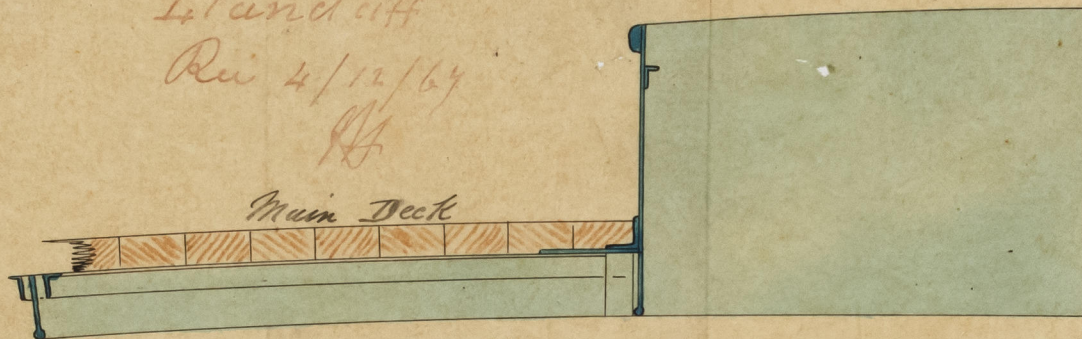

Gross Section of Boiler Hatch

Pop Deck

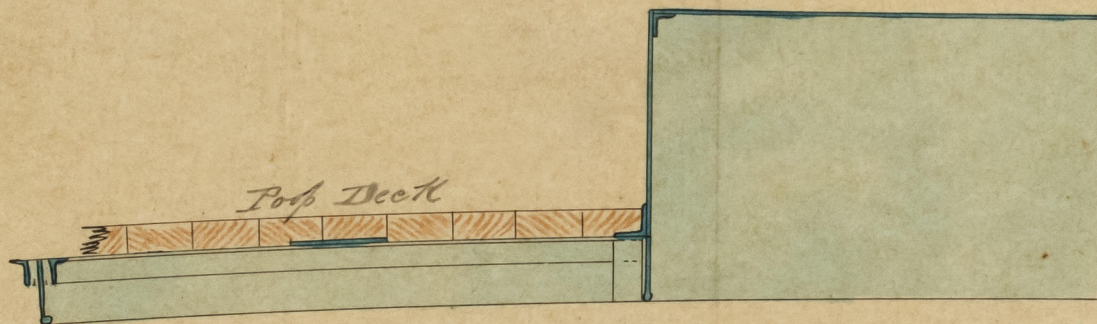

SCHLESINGER, DAVIS

Iron Ship Build

WALLSEND

NEWCASTLE ON T

IRON 500-0253