


Zara - Mve. N. 8856 now La Plata  
 Iron No 5988

Sketch shewing Doubling Plate N<sup>o</sup> 112.  
 which we propose carrying  $\frac{3}{4}$  the length of ship

5988 Iron

Scale 1 inch = One foot.

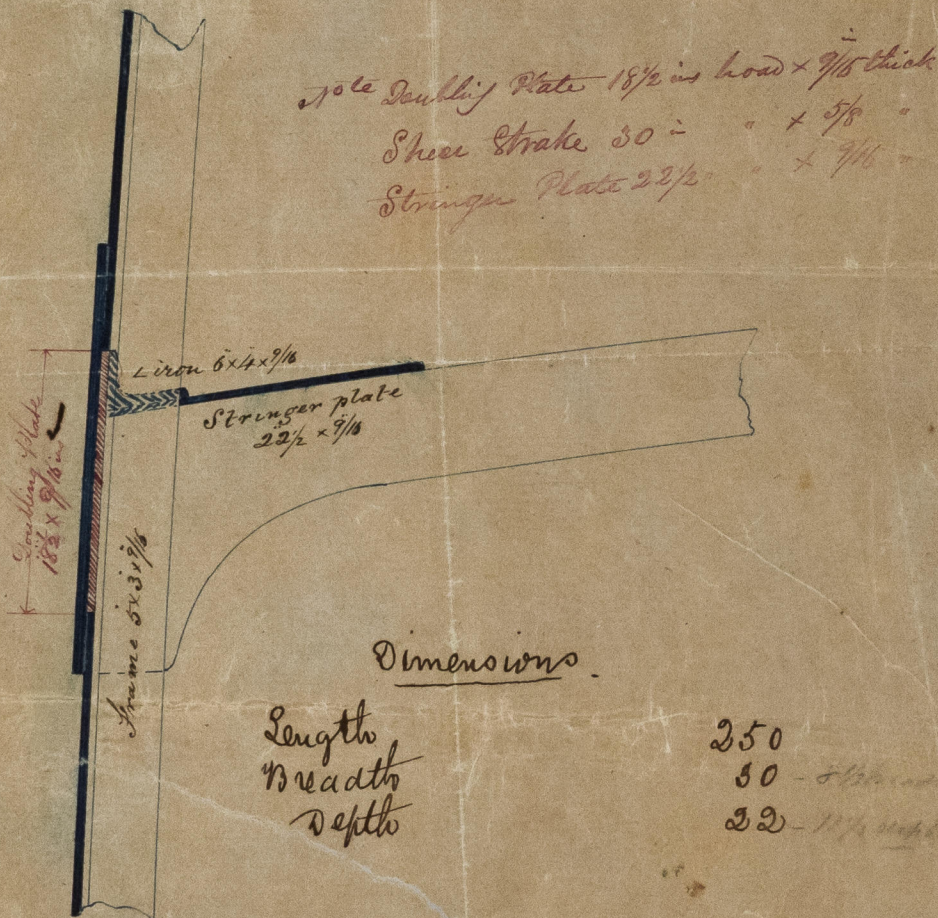

See Secretariat  
 Letter 5<sup>th</sup> April 1862.

IRON 500-025 5



© 2021

Lloyd's Register  
 Foundation