


MIDSHIP SECTION OF BARQUE N^o 97

Length 146.5
 Breadth 28.0 = 5.23 Breadths in Length
 Depth 16.5 = 8.88 Depths in Length

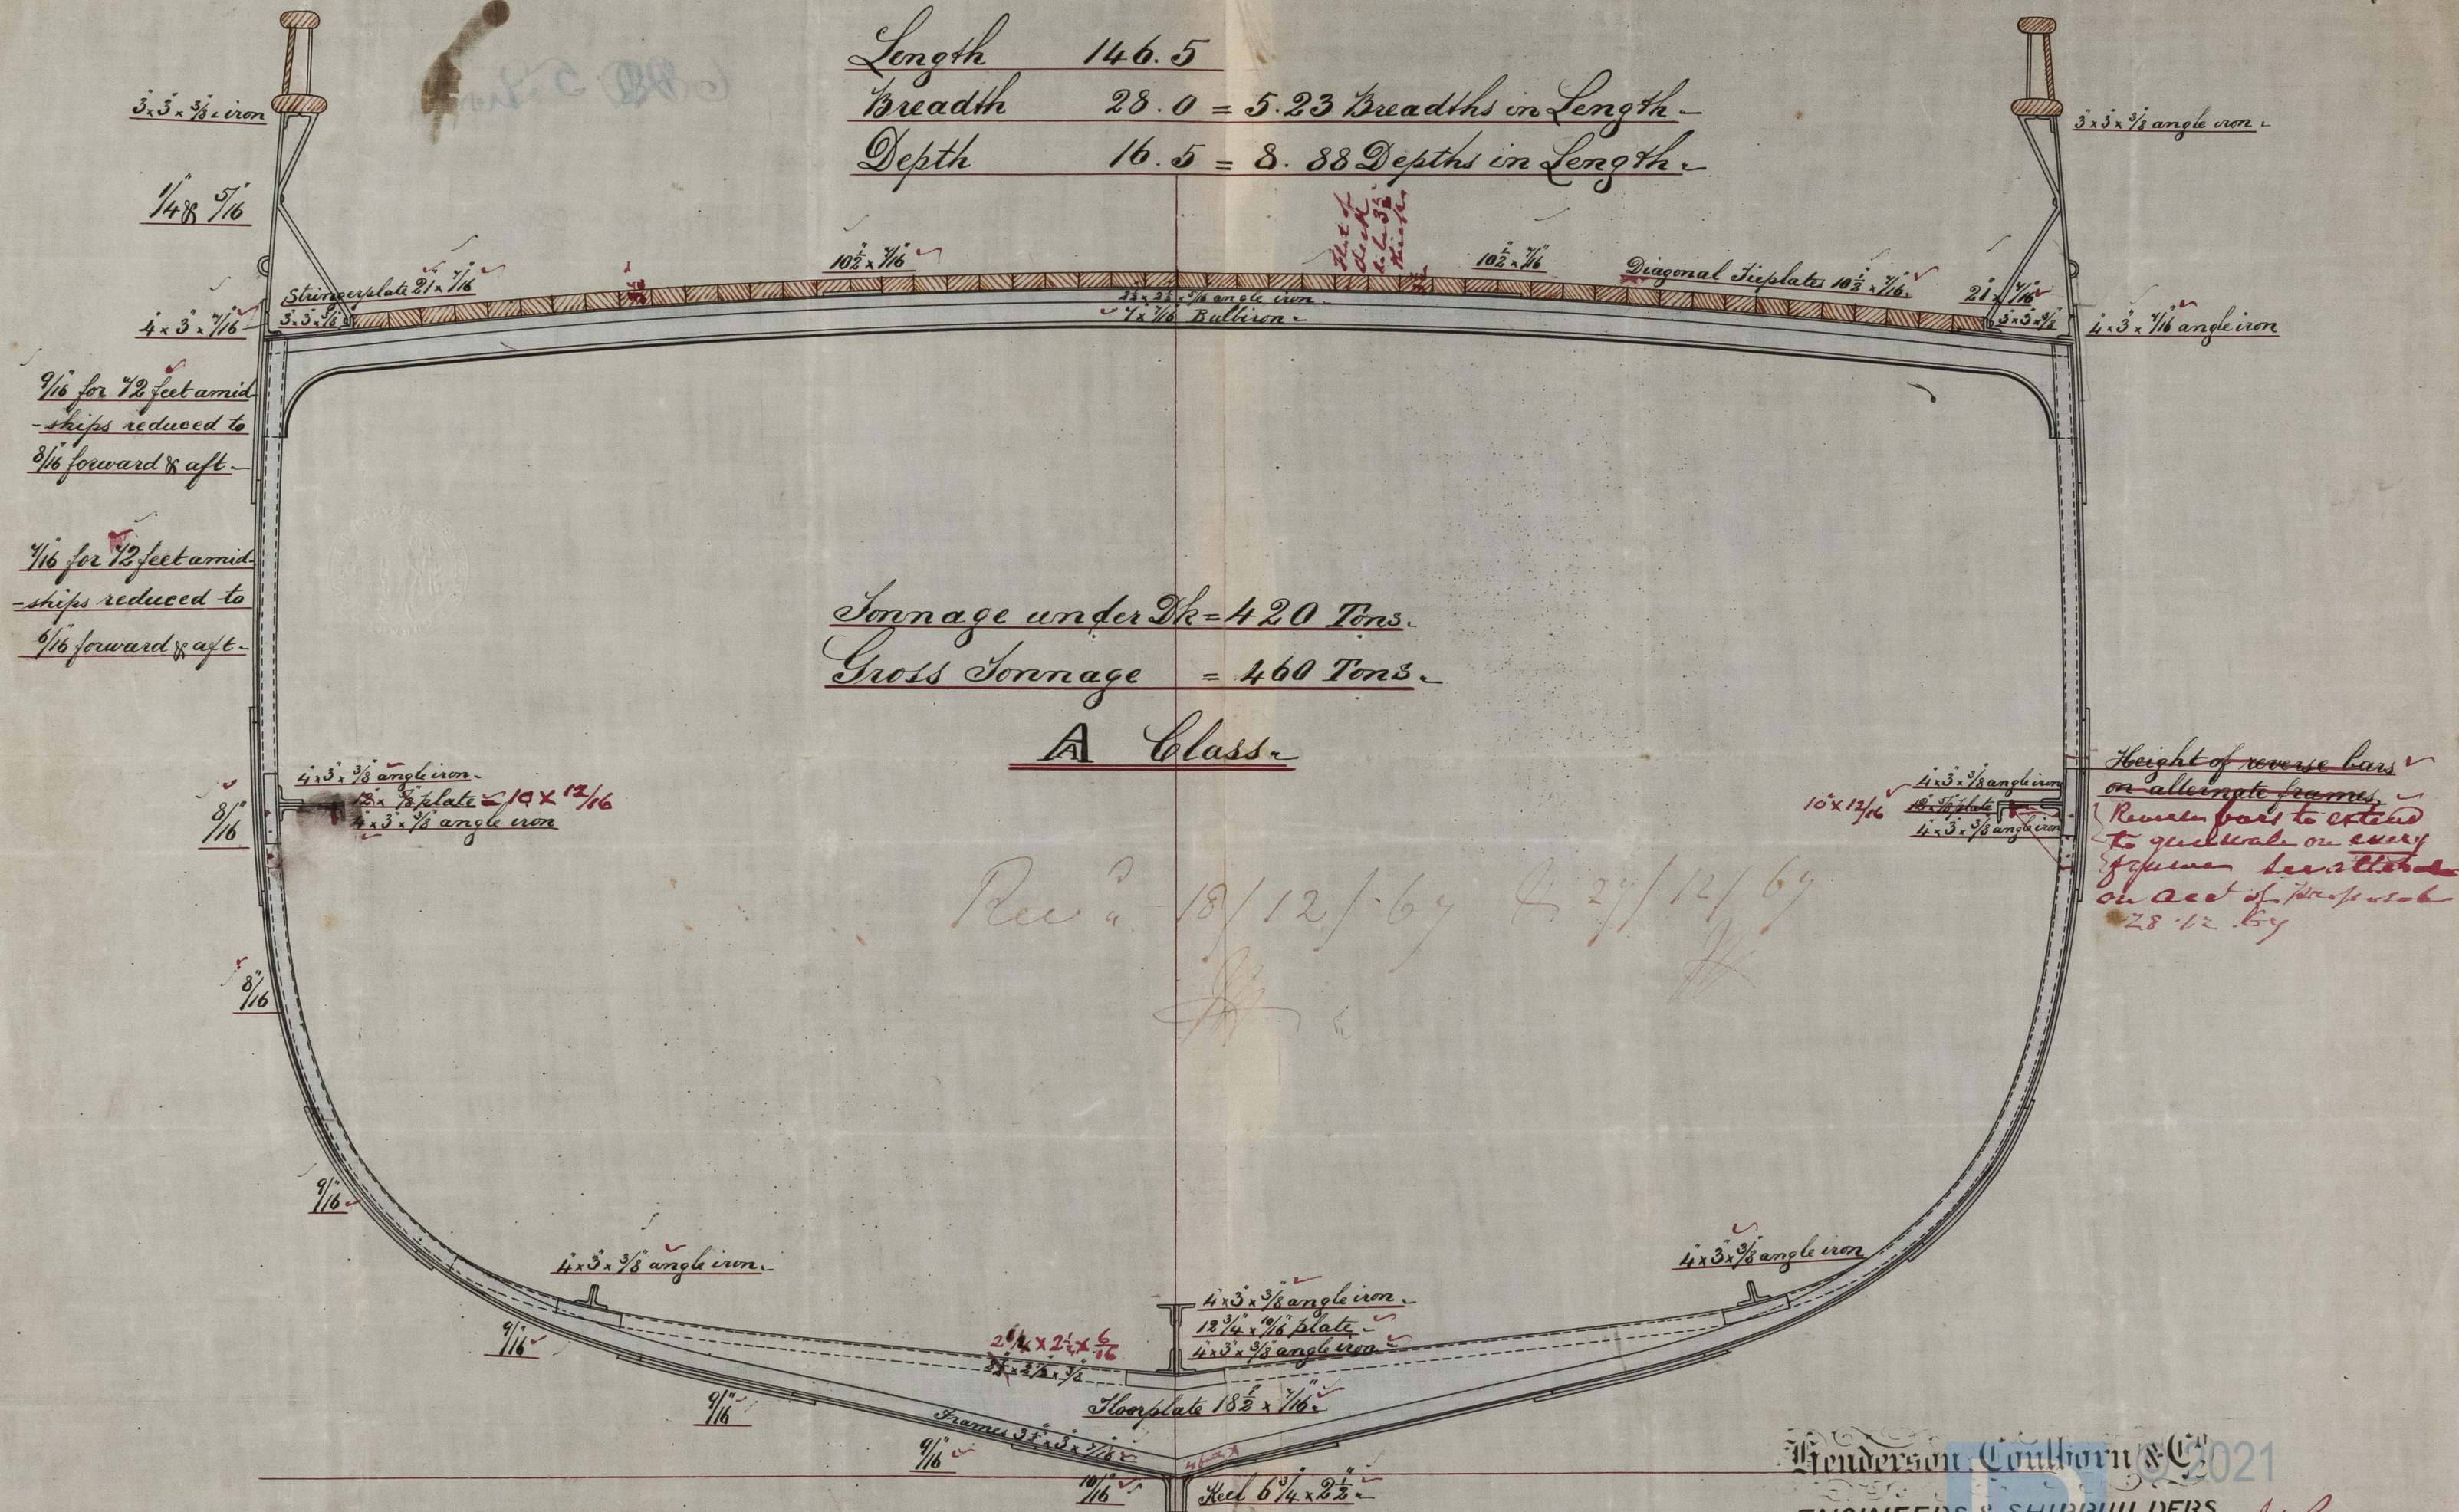

Tonnage under Deck = 420 Tons.
 Gross Tonnage = 460 Tons.

A Class

Rec'd 18/12/67 & 27/12/67
 J.H.R.

HENDERSON, COULBORN & CO. 2021
 ENGINEERS & SHIPBUILDERS
 Dock
 RENFREW
 14/12 1867

IRON500 0286

IRON 500 - 0286

