
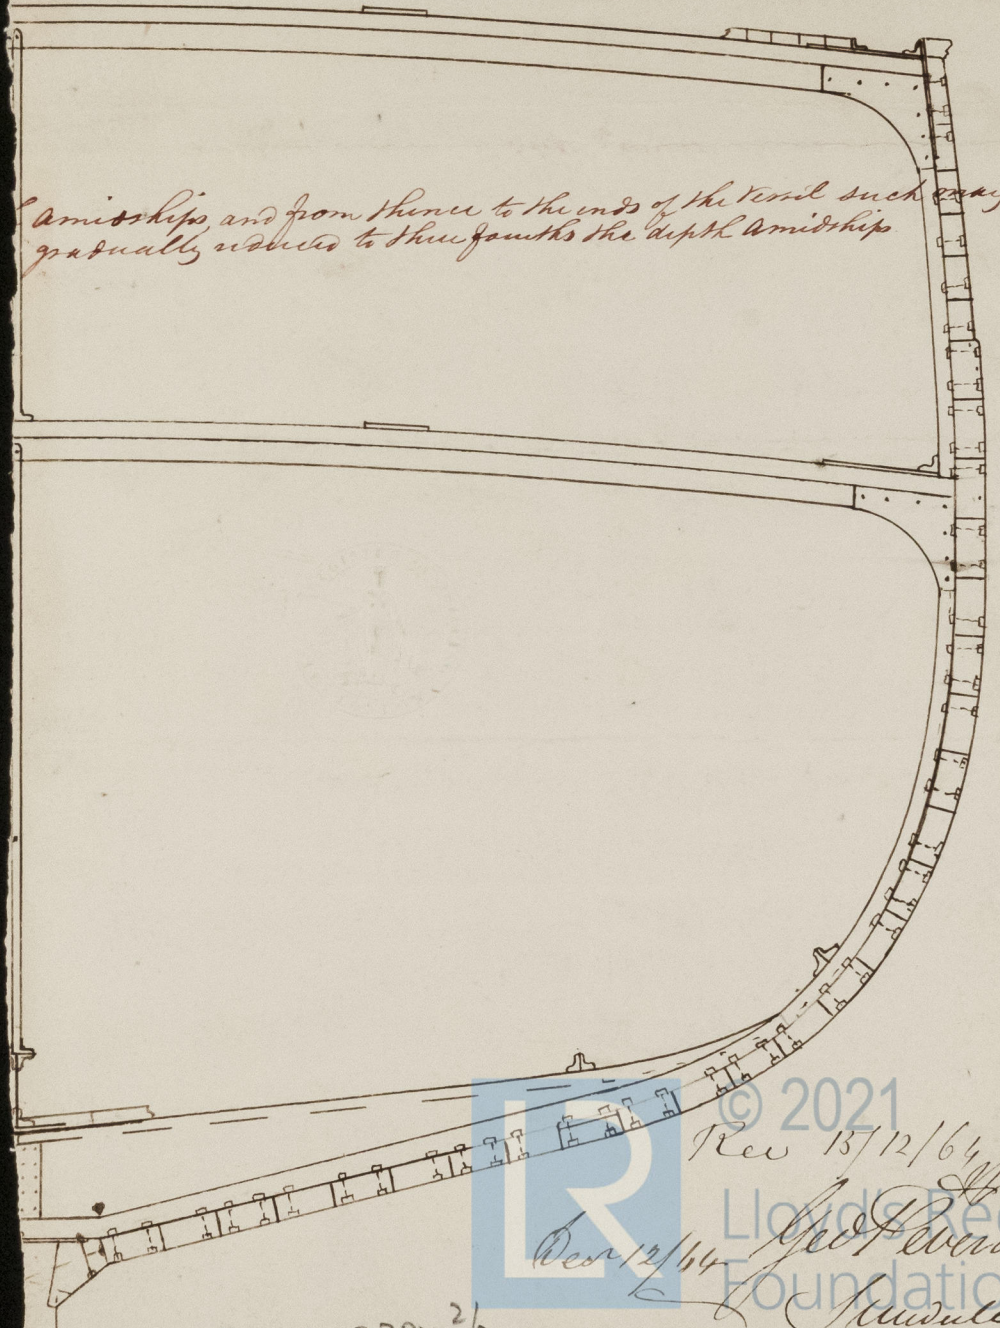


6/14/16  
 2 1/4 x 5 1/2  
 Sheer Struts 24 1/2 x 7/16  
 Deck Beam Struts 22 x 7/16  
 Hold Beam 22 x 7/16  
 Floors (Double Braced) 20 x 7/16  
 Bridge Plates 12 x 7/16  
 X Keel Plates 24 1/2 x 7/16  
 Keelson 3 1/2 x 7/16  
 Foundation Plates 18 x 7/16  
 Top of Floor 25 x 7/16  
 Girders 25 x 7/16  
 Tie Plates (Deck) 11 x 7/16  
 Hold Beams also 11 x 7/16

Sheer 10"  
 Diagonals Outside 22 each side  
 Frames 3 1/2 x 7/16  
 Reverse 2 3/4 x 2 3/4 x 7/16  
 Beams 7 1/2 x 7/16  
 Angles for 2 3/4 x 2 3/4 x 7/16  
 Waterway 4 x 3 7/16  
 Bilge Struts 4 x 3 7/16  
 H. B. 4 x 3 7/16  
 Keelson Angles 4 1/2 x 3 7/16  
 Pillar under each beam

14 7/8  
 2 1/2 x 7/2  
 Plank 1/3 of Depth Am Elm 5", Keel 13 1/2"  
 " Light Plank to Gop 12"  
 " Teak 1/2" from Gop to Keel 3"  
 " Thick Plank 1/2" from Gop to Keel 3"  
 " Gop 4"  
 Bolts Galv Iron (Screw) 1 1/8"  
 Deck 4 Pine 3"  
 Span Name 10" center

Specification as submitted approved  
 on 24/12/64  
 Keelson to be according to girth form

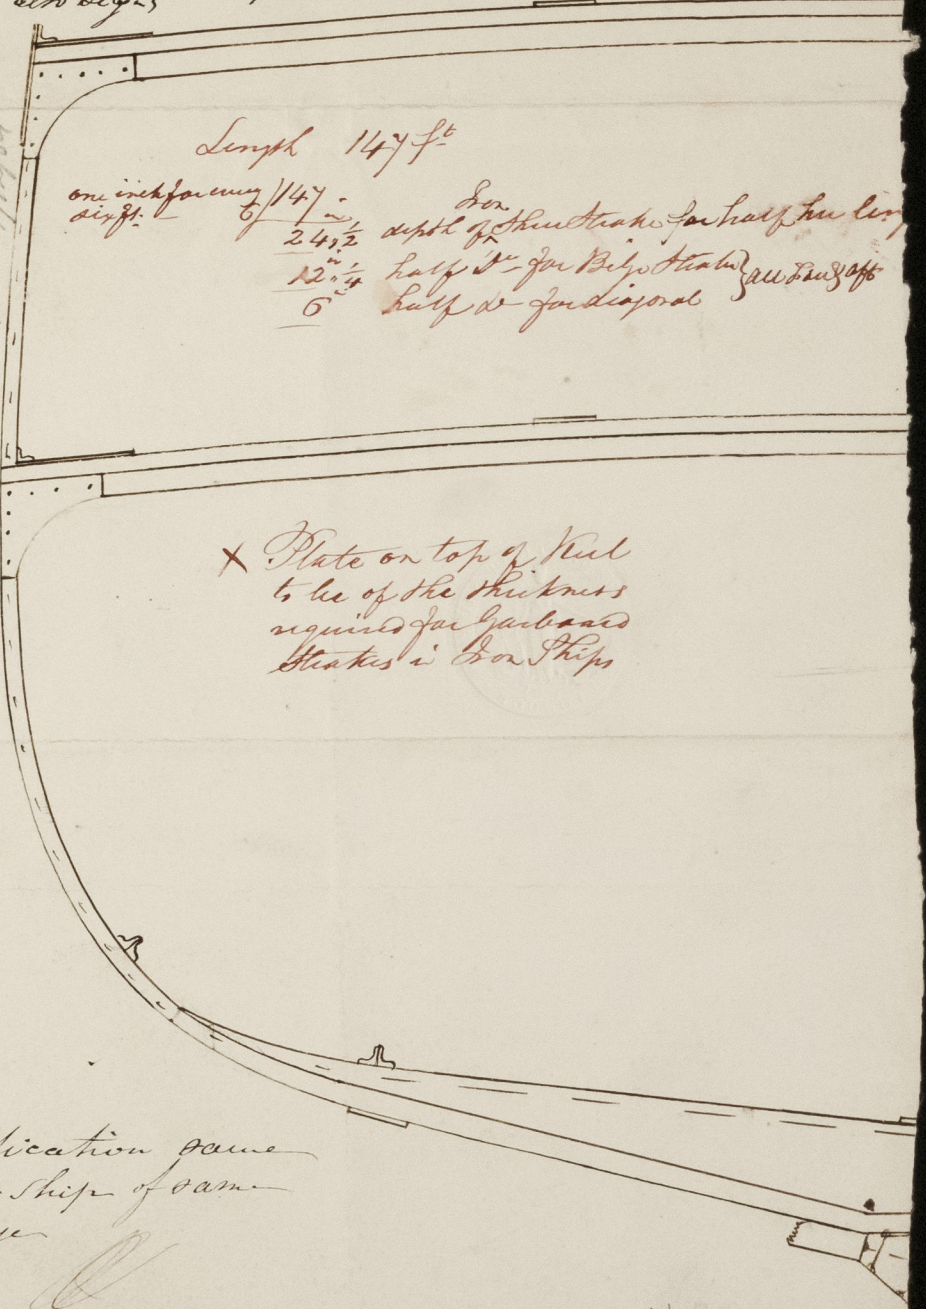

Specification same as last ship of same form

IRON 500-0287 1/2

IRON 500-0287 2/2

© 2021  
 Rev 13/12/64  
 Lloyd's Register  
 Foundation  
 Mudulain



6206 Iron

6206 Iron



IRON500-0287

0287



© 2021

Lloyd's Register  
Foundation