

S.S. No 69 longitudinal Section of Water ball  
in fore & after Holds. — Rev.

Engine Space  
no water ball

Keelson Plating  
14 x 12/16

29 1/2 height of Keelson  
8/16 thick  
236

The Keelson Angle Iron are also 5 1/2 x 4 1/2 instances  
of 5 x 4 1/4 x 9/16 this is all fore and aft

Scale 1/4 inch = 1 foot.

IRON 500 0289 12



at Tanks

24/10/67  
H

at Tanks


End of Tank B.H.

C "Marmora"

Keelson Water  
2 3/4 x 9/16

Length of Water Tanks 78' 9"

Iron

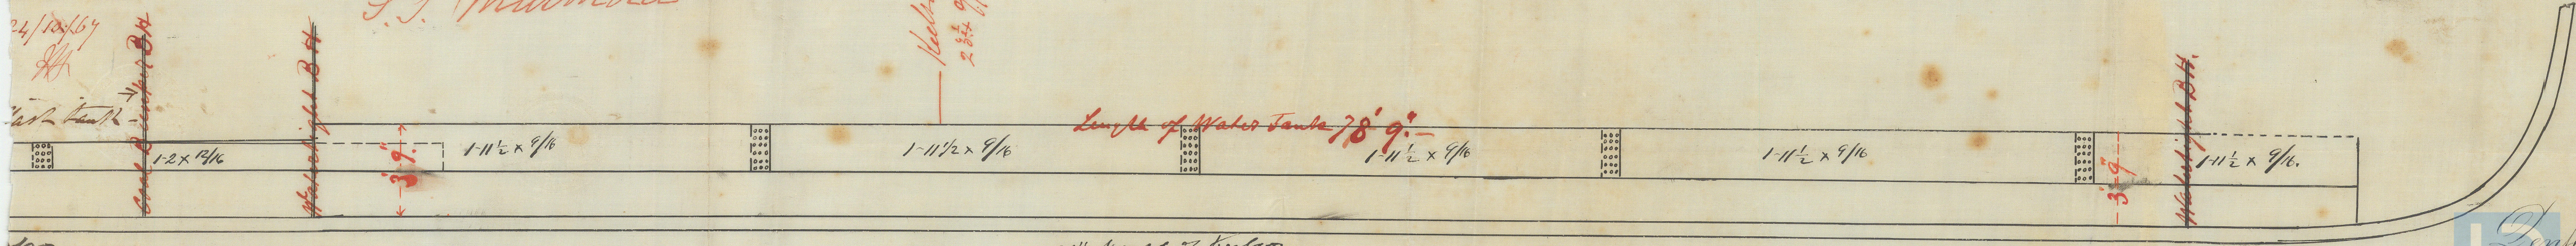

Iron

20 1/2 thickness of keelson  
9/16 thick  
21 1/2

© 2021  
Lendon Gray & Co  
Iron Ship Builders  
Foundation  
Barkpool  
(No 691)

IRON 500-0289 2 1/2