


S.S. "Marmora"

A

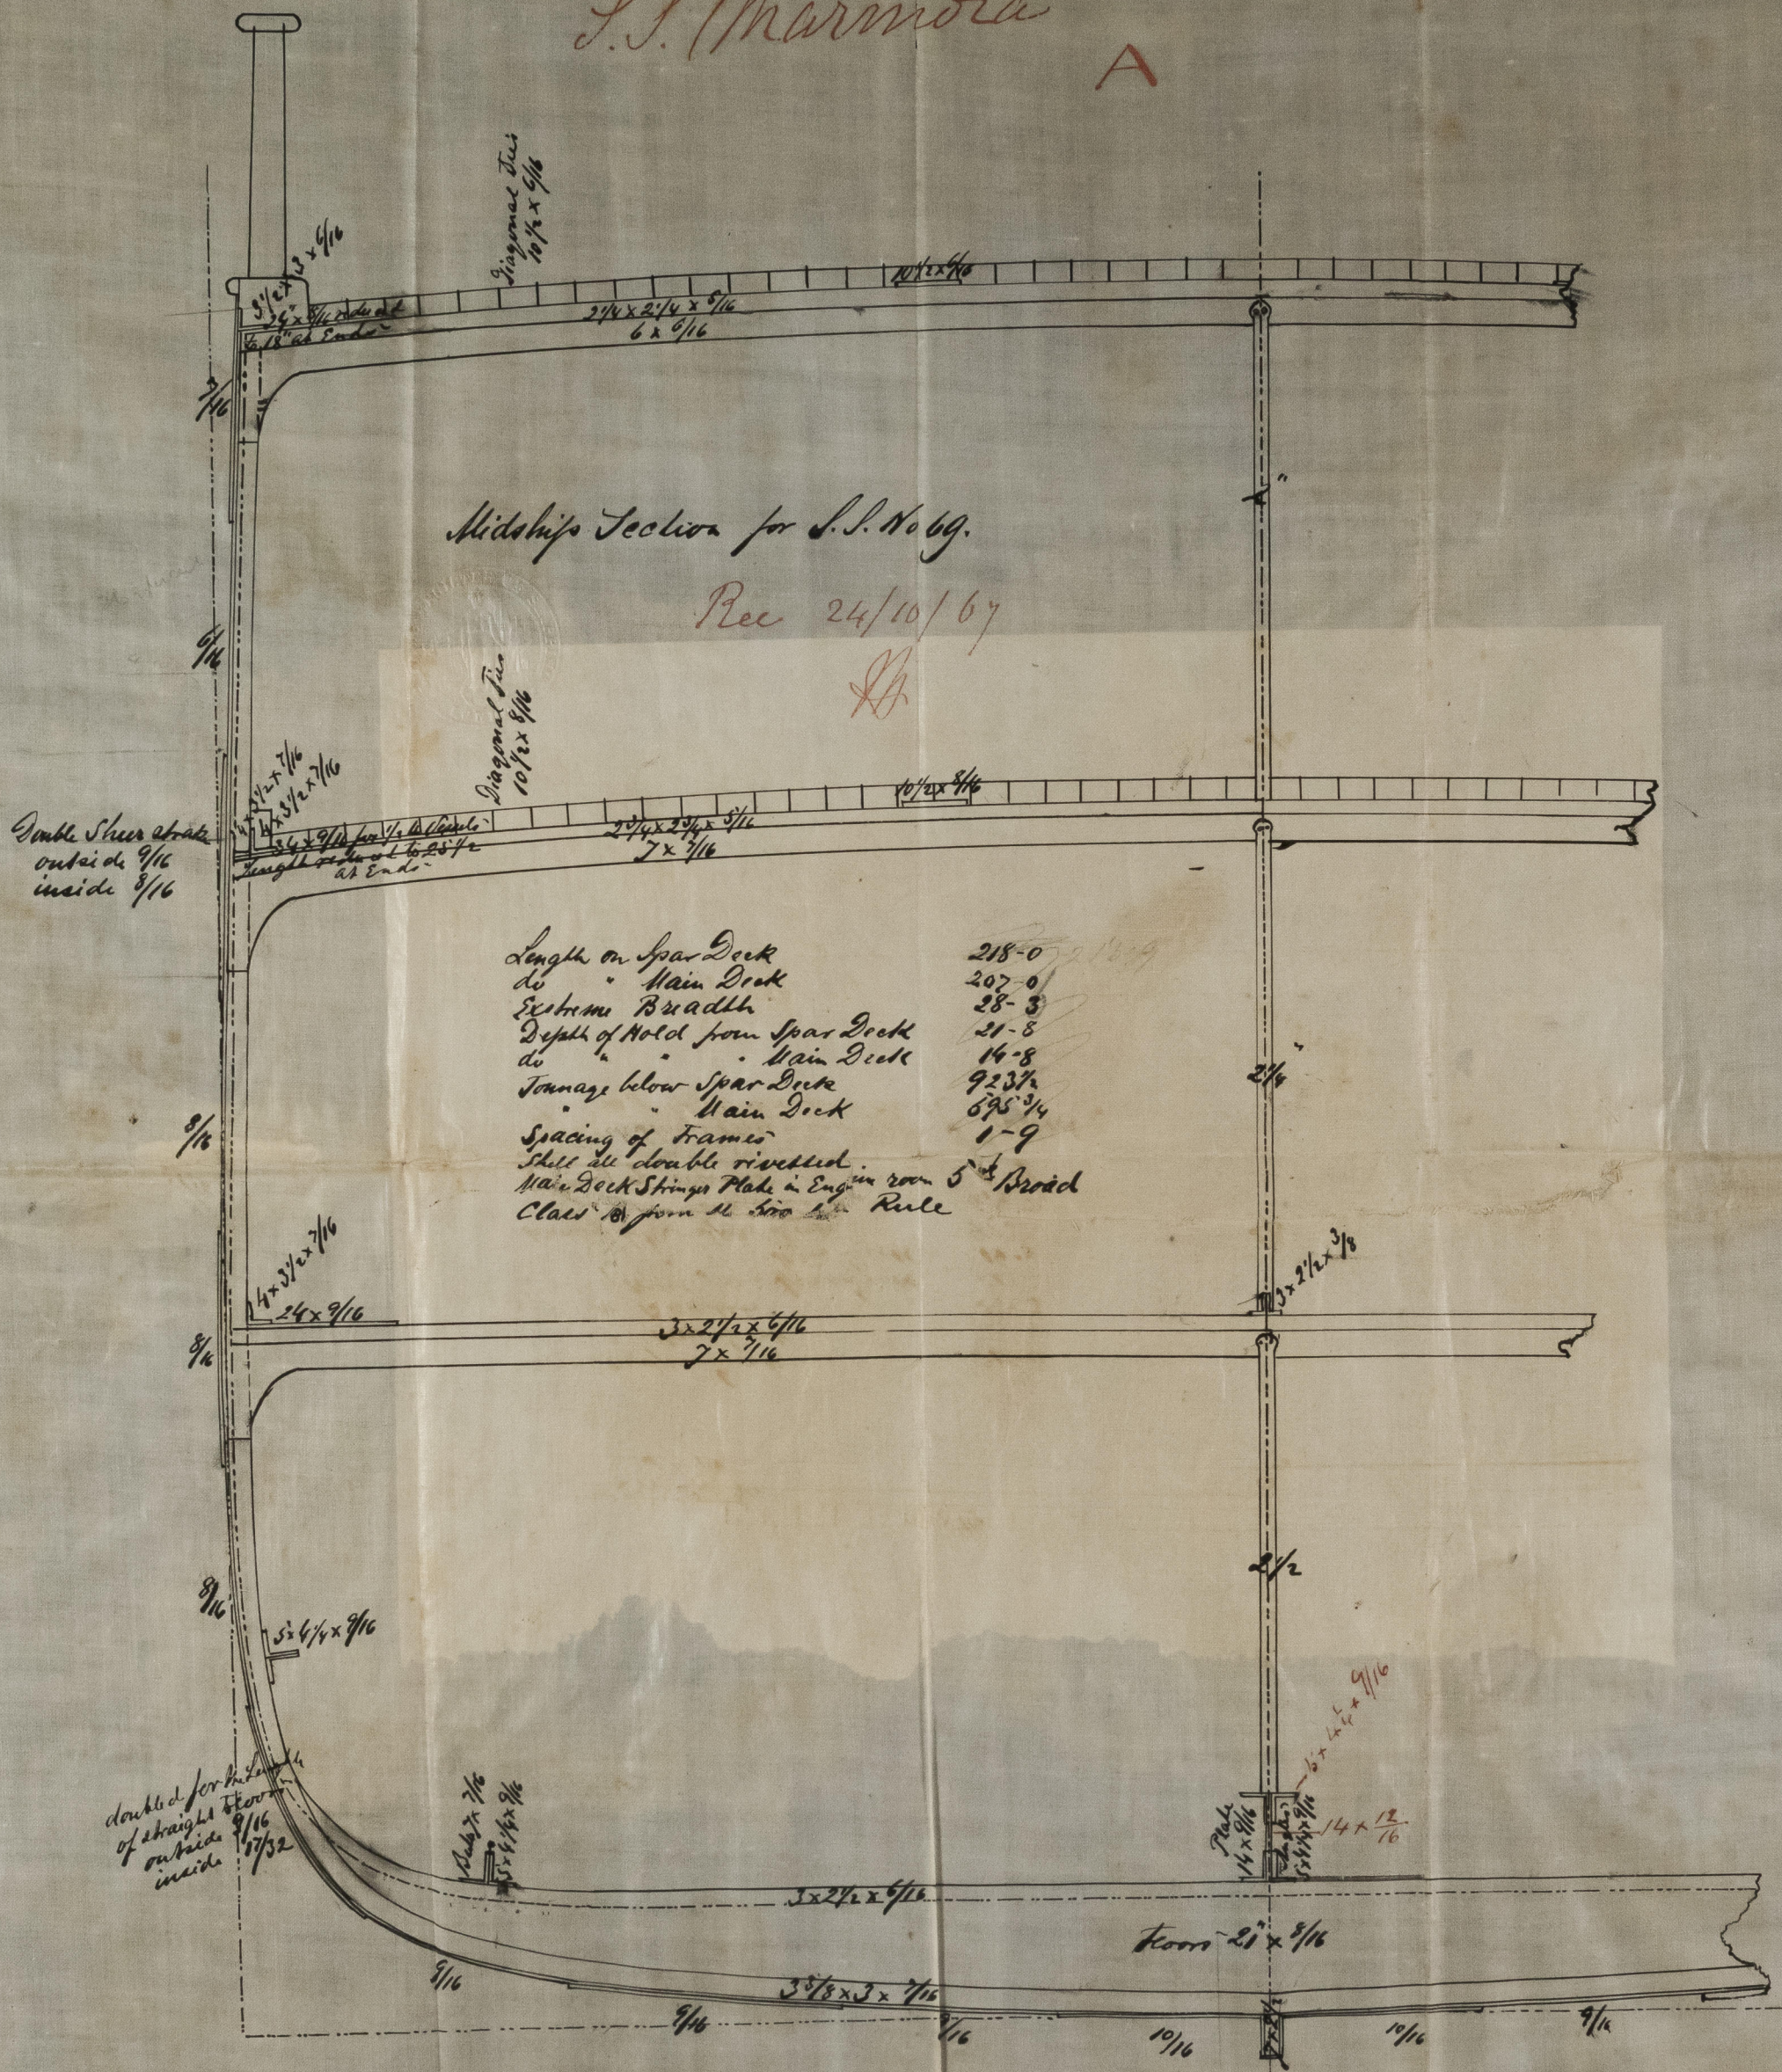

SCALE 1/2 INCH TO FOOT

Denton, Gray & Co. (No 69.)

IRON SHIP BUILDERS

Middleton Ship Building Yard
HARTLEPOOL.

Lloyd's Register
Foundation

W. H. H.
Recd 31/10/67 m.c.

IRONSD00-0292