

Dec 20<sup>th</sup> 1867


# MIDSHIP SECTION

No<sup>s</sup> 230 & 231

Scale 1/2 inch = One foot

Rec 28/12/67

Diagonal Tie plate  
and required over  
Beams as per Rule

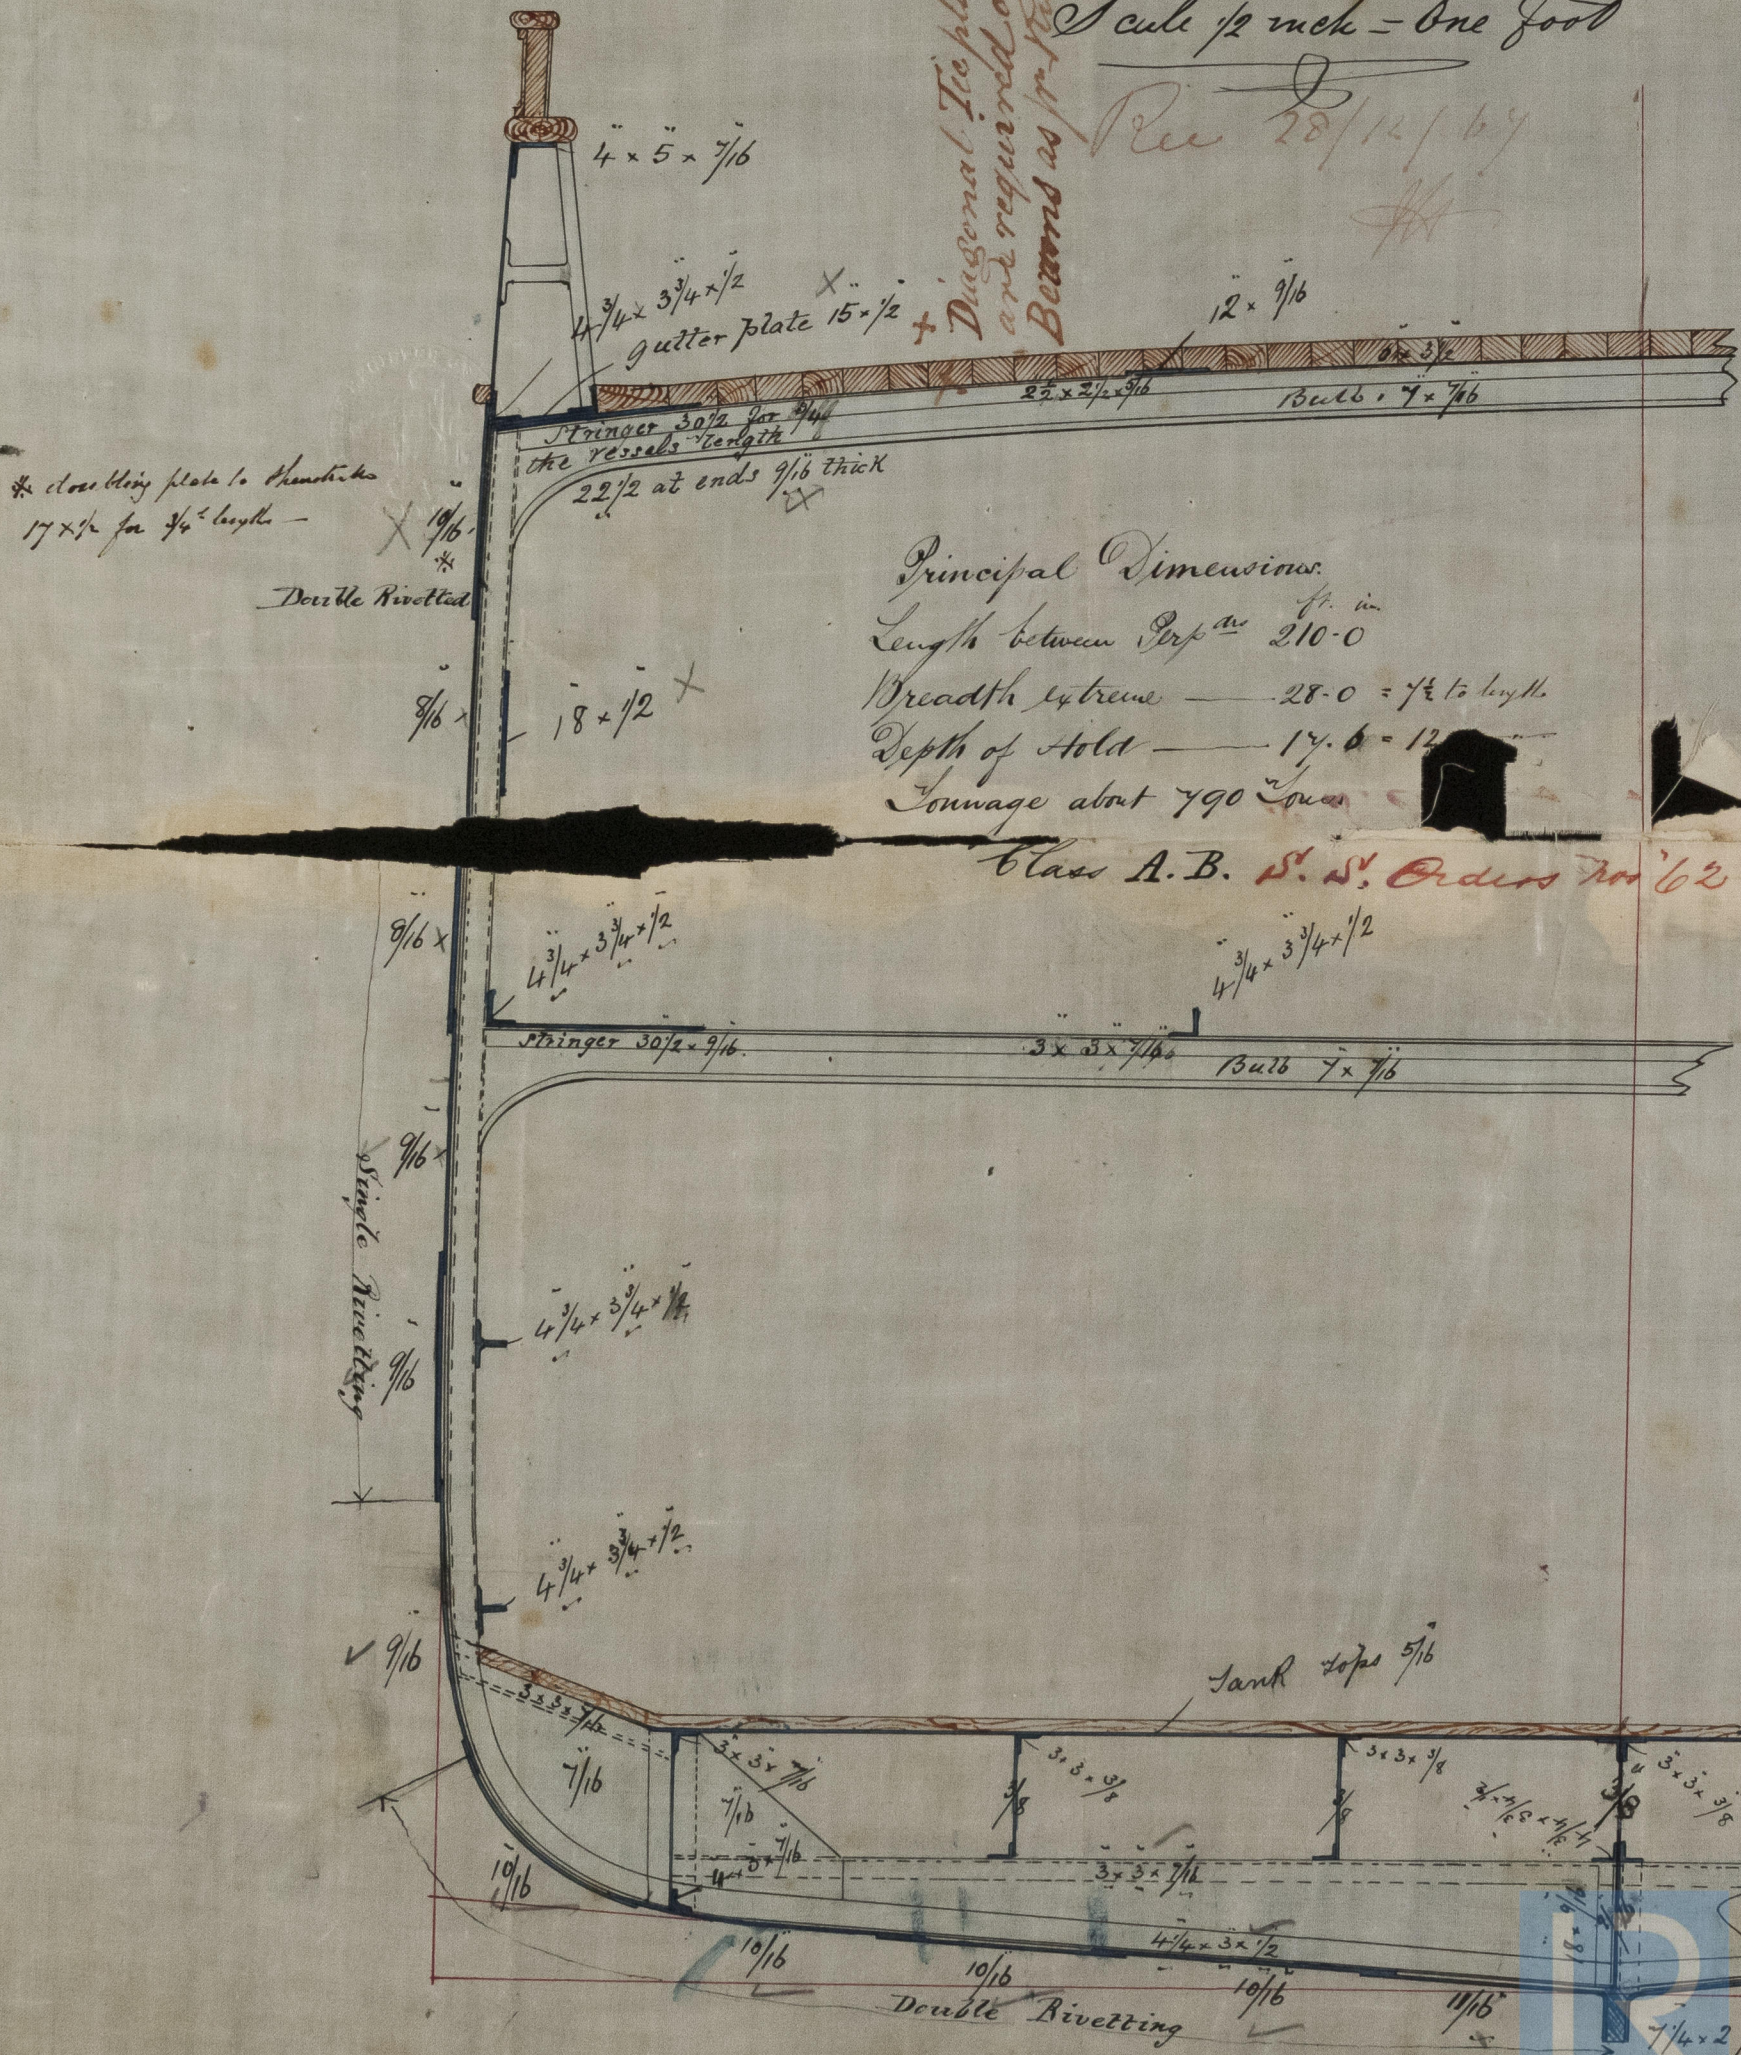

Principal Dimensions:  
Length between Perps <sup>ft. in.</sup> 210-0  
Breadth extreme — 28-0 =  $7 \frac{1}{2}$  to length  
Depth of Hold — 14-6 = 12  
Tonnage about 790 Tons

Class A.B. S.S. Orders No<sup>s</sup> 624 & 625.

© 2021

Lloyd's Register  
Foundation

IRON 500 - 0316