


6369 Lm

Star of Persia



MIDSHIP SECTION
"STAR OF PERSIA"

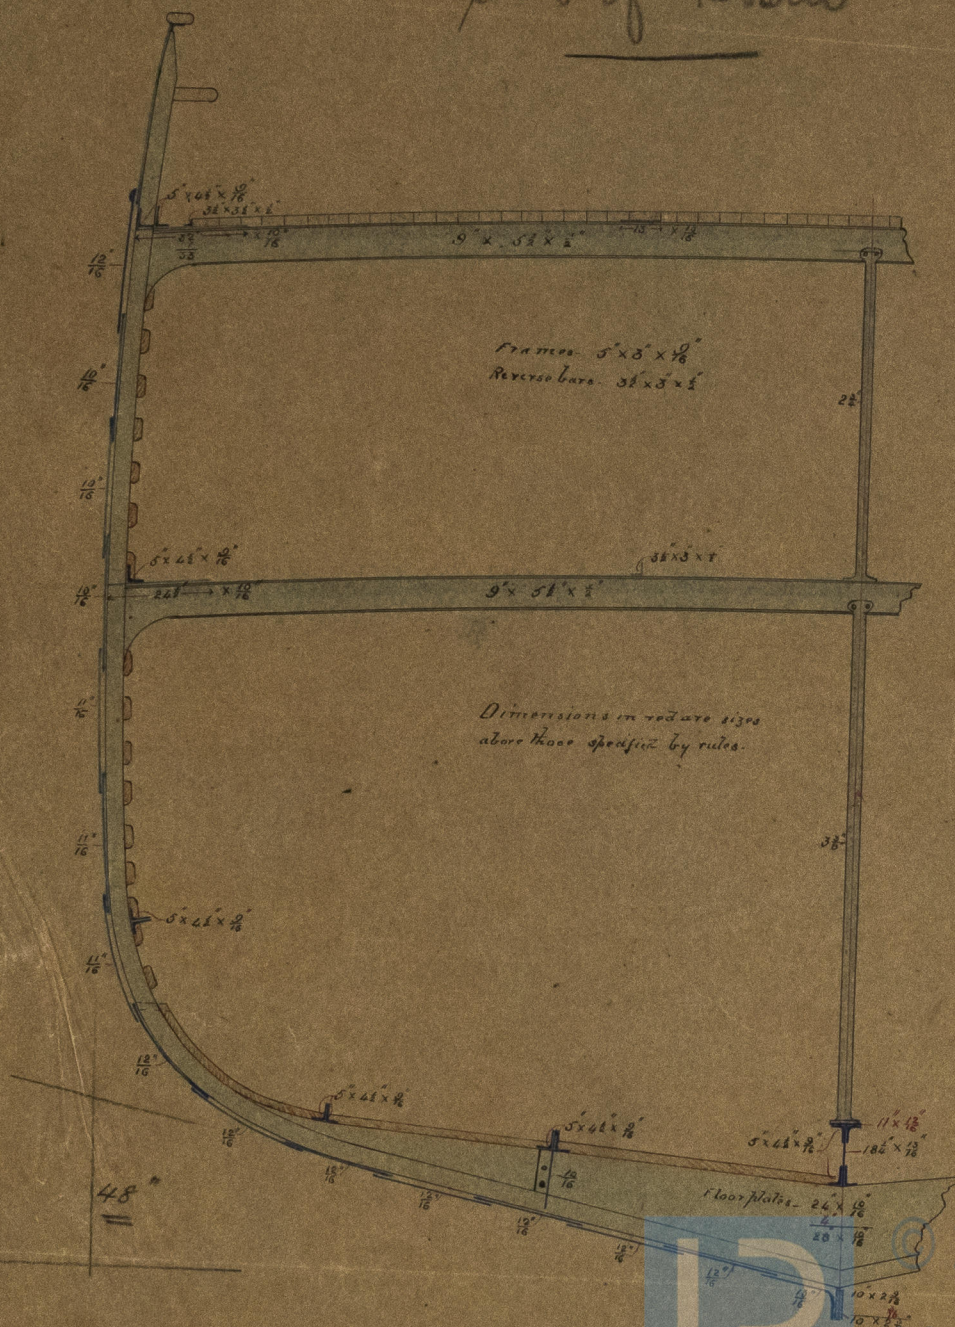

© 2021

Lloyd's Register
Foundation

Scale 1/2" = 1 foot

IRONSOIL 0005