

6478 Lm

MIDSHIP SECTION

OF
S. S. NO 99.

*D. Horse
Hanna*

Length from afterside of Sternpost to foreside of Stem -- 160 feet 0"

Breadth extreme 24 x 6" = 6.52 Bm L

Depth in Hold 14 x 2" = 11.29 Bm L


Tonnage under Deck = 360 Tons.

Gross Tonnage = 400 Tons.

A Class.

Rec 14/3/68 & 29/4/68

LL

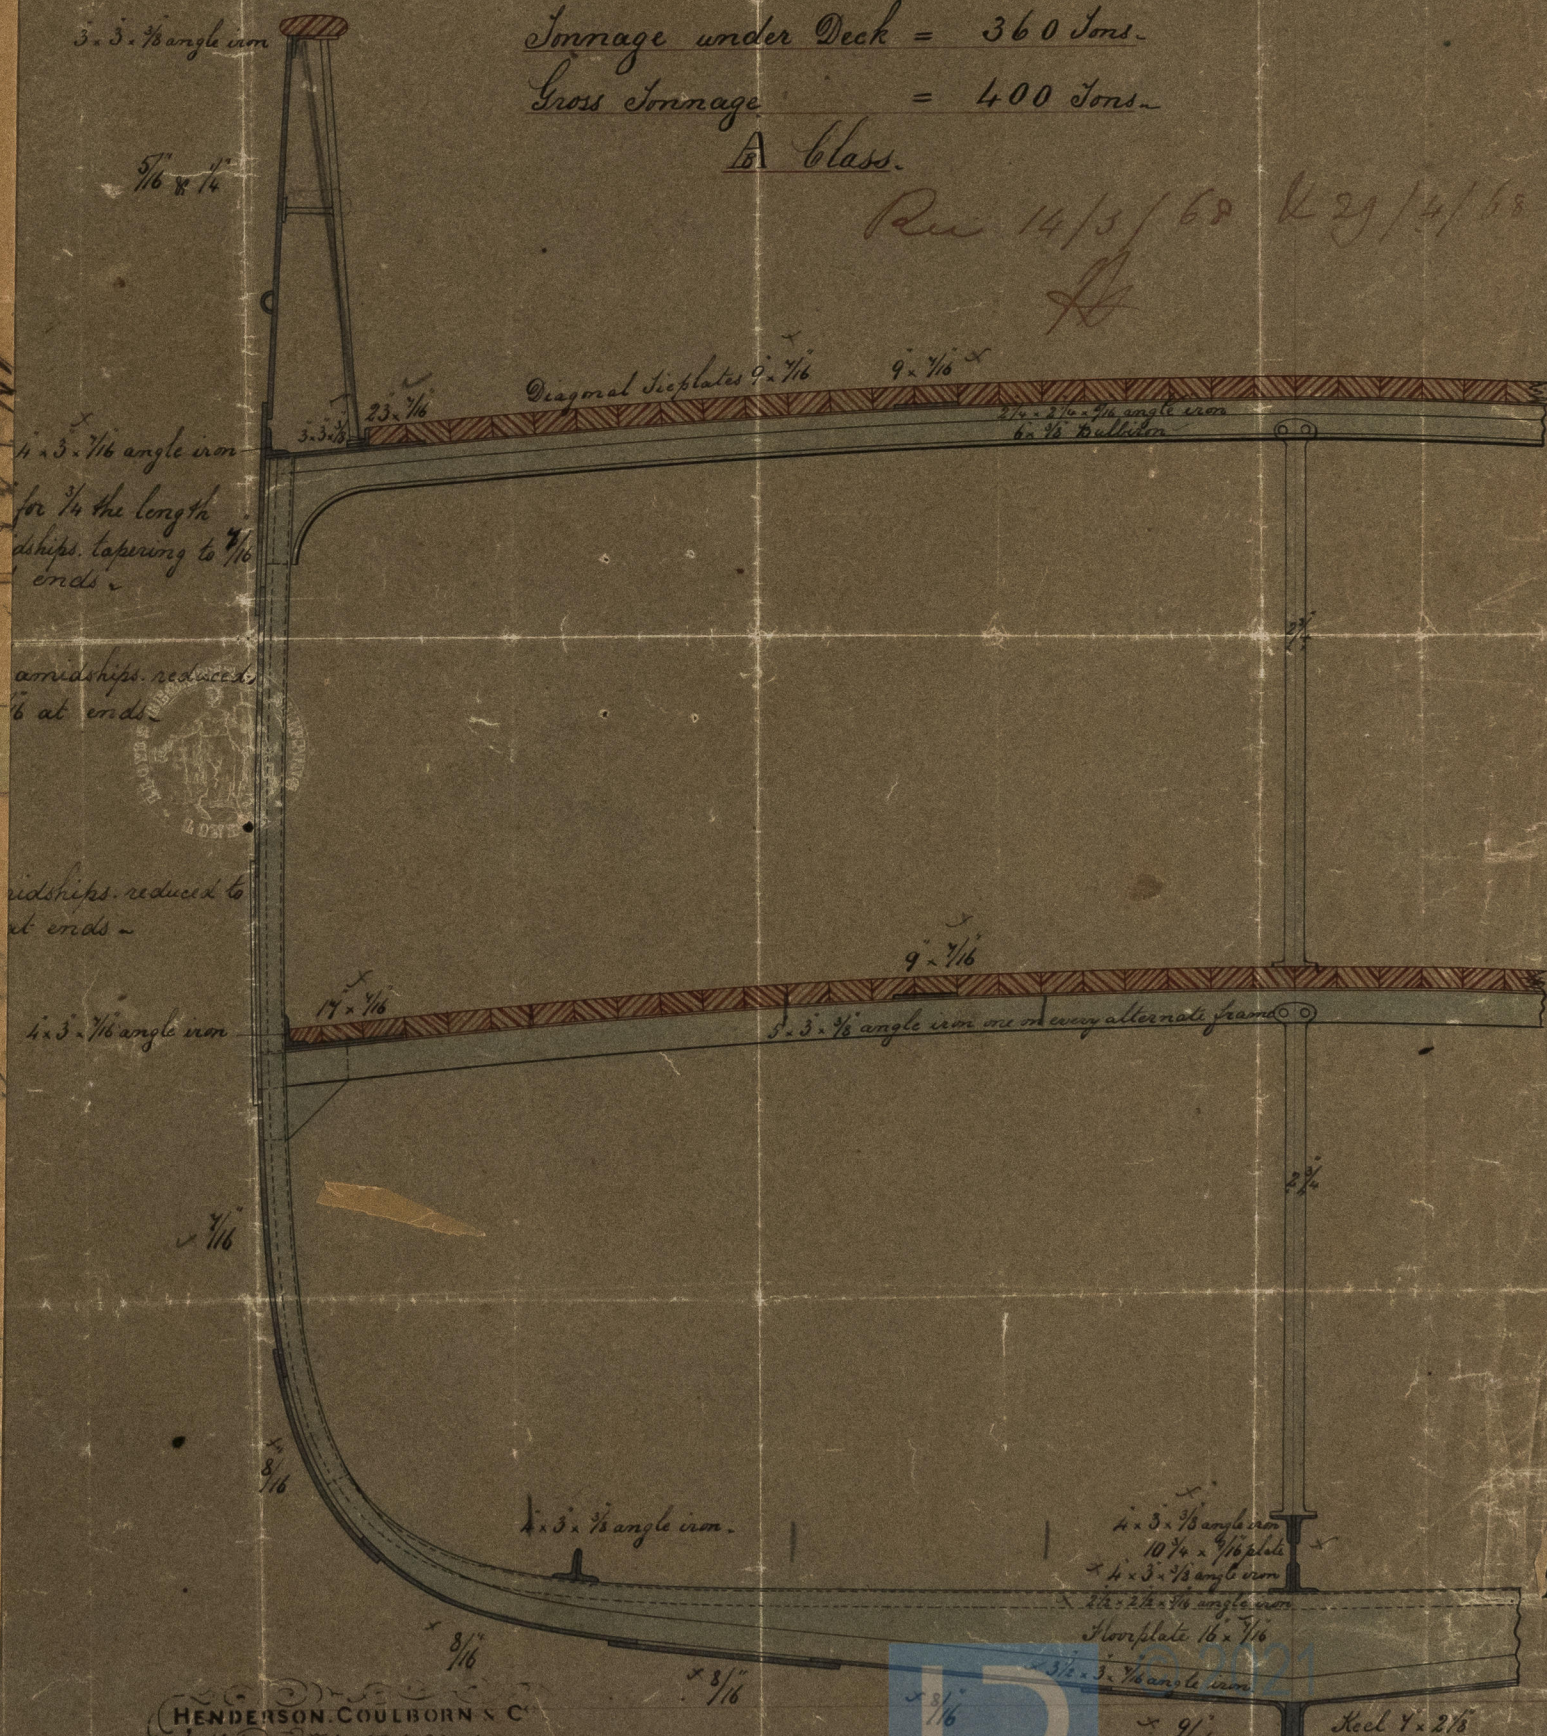

HENDERSON, COULBORN & C^o
Engineers & Ship Builders
SLIP DOCK
Kentish

SCALE 1/2 INCH TO A FOOT

Lloyd's Register
Foundation

IRON-501-0036