

MACNAB & CO
Shipbuilders, Engineers & Founders
GREENOCK

Scale 1/4 Inch to one Foot

Rev 19/6/67

From here to
Stern beams
to be of angle
iron 5x4x9

48x 6/16

48x 6/16

From here to Bow
beams to be of
angle iron
5x4x9


10 1/2 x 7/16

10 1/2 x 6/16

5/16

Principal Dimensions

Length of Keel and Fore Rake 160 feet
Breadth of Beam 22
Depth in Hold to Top of Floors 12 ft 8 in
Tonnage Gross under 300 tons.

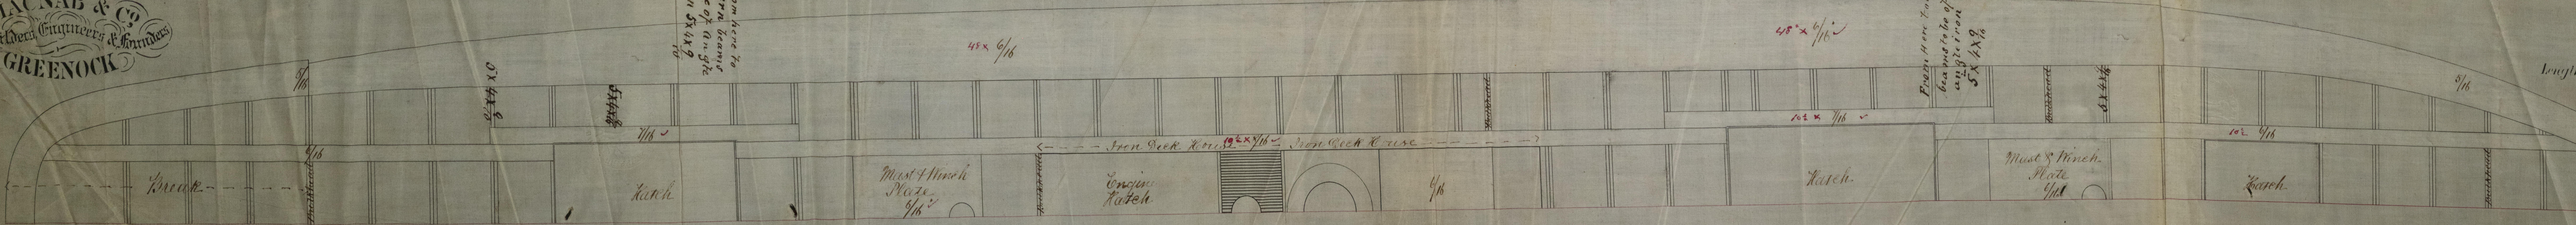

© 2021
Lloyd's Register
Foundation
IRONSD1-0067

211
212
Lloyd's Register
Foundation

No. per minute of Engines

and Boilers