

Ship "Haucois"

Report 2

N^o 145


Scale $\frac{1}{2}$ - 1 foot

Length BP 210.6

Beam Moulded 37.0

Depth in hold 22.11

Ru 20/6/68
JA

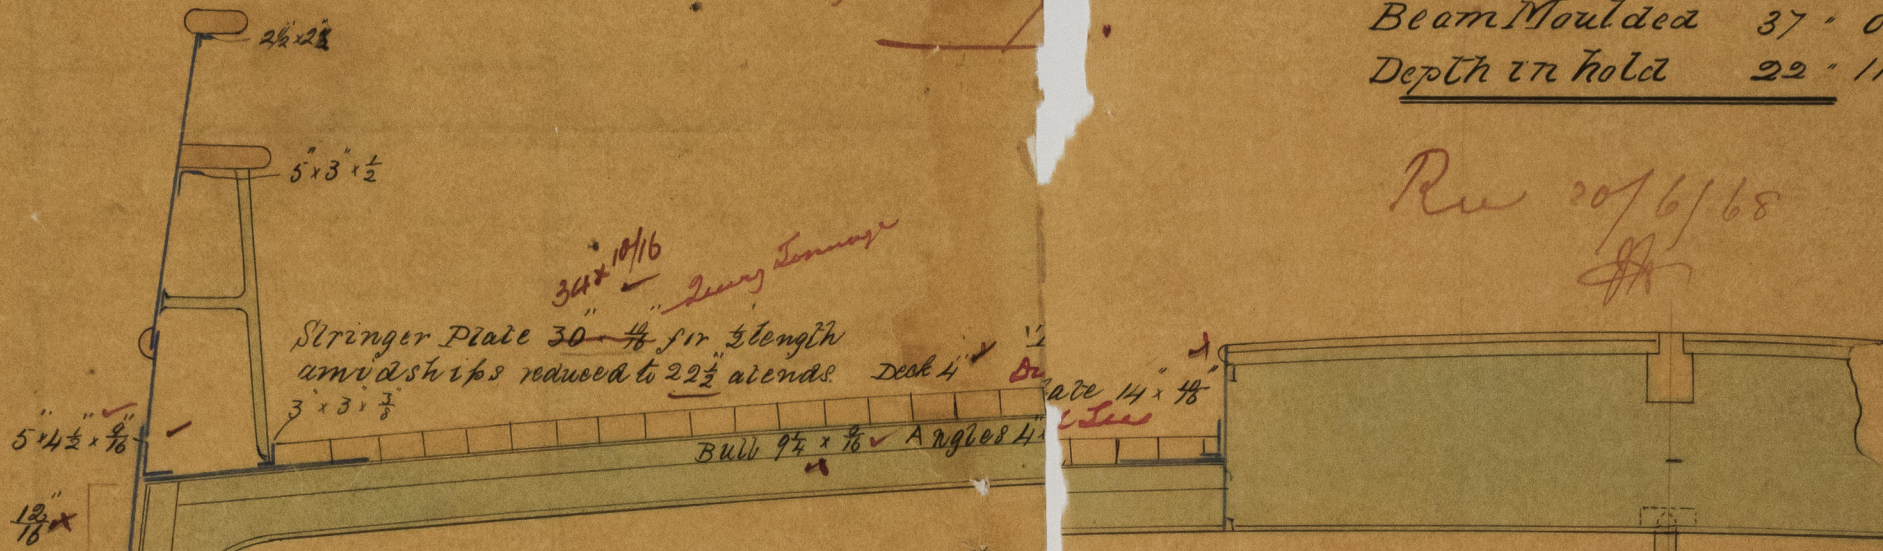

Grade 1000 and under 120

Keelsons 1200 and up A Class

under 1500 Tons

Strakes above 3rd depth 10" x 1/2" at each end reduced to 8" x 1/2" length from each end.

100 4/6



Bulk 9 1/2" x 1/2" Angles 4" x 3/4"

Deck

Plate 14" x 1/2"

Bulkhead 70


100 5/6

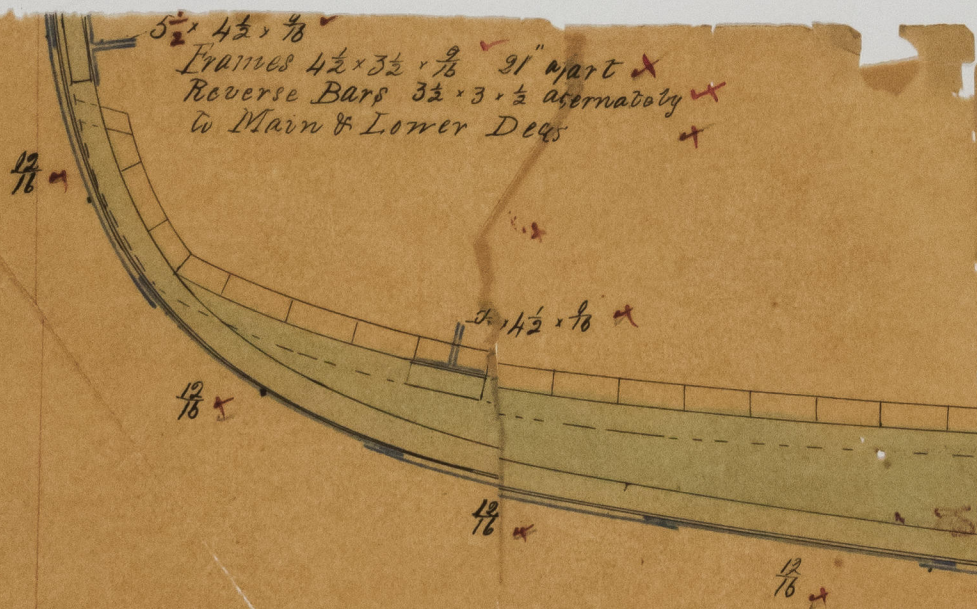

JMR
20 6 68

IRON 501-0100 1/6

100 3/6

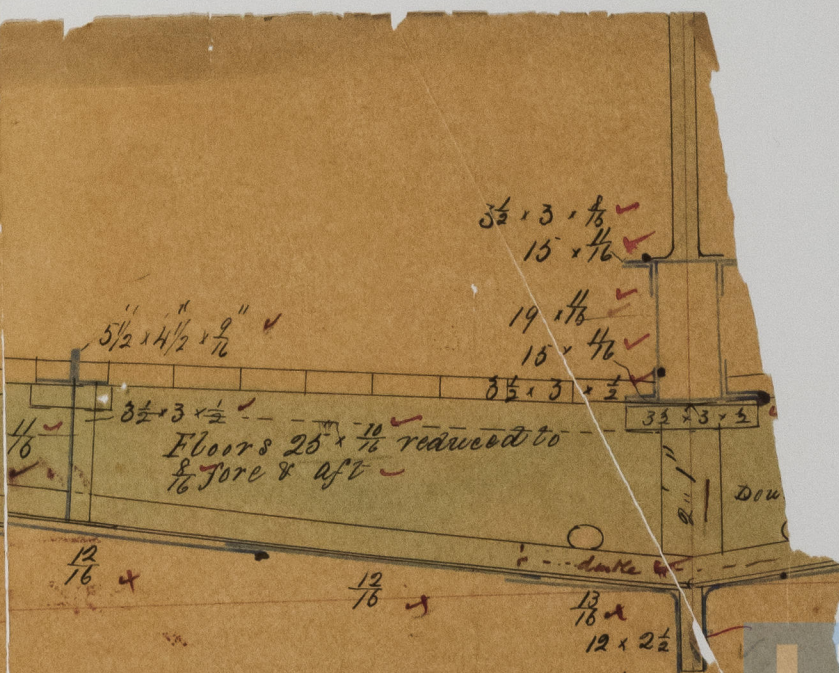

100 2/6



© 2021

Lloyd's Register Foundation