



Iron Masts for 145 Ship "Francis Stokes" - Report No. 2711.
 Scale 1/4" = 1 foot



Rec 31/8/68
 10

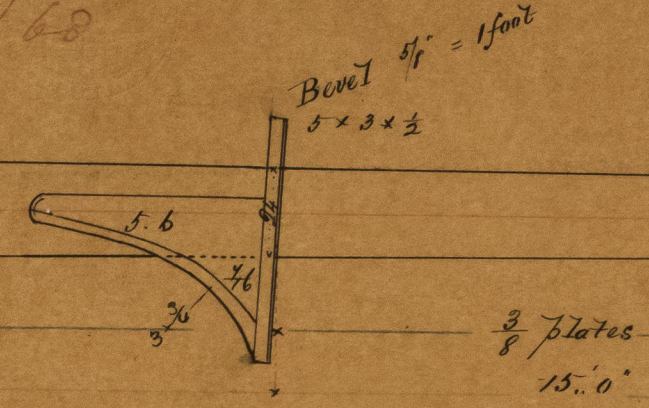



Bevel 1/4" to the foot

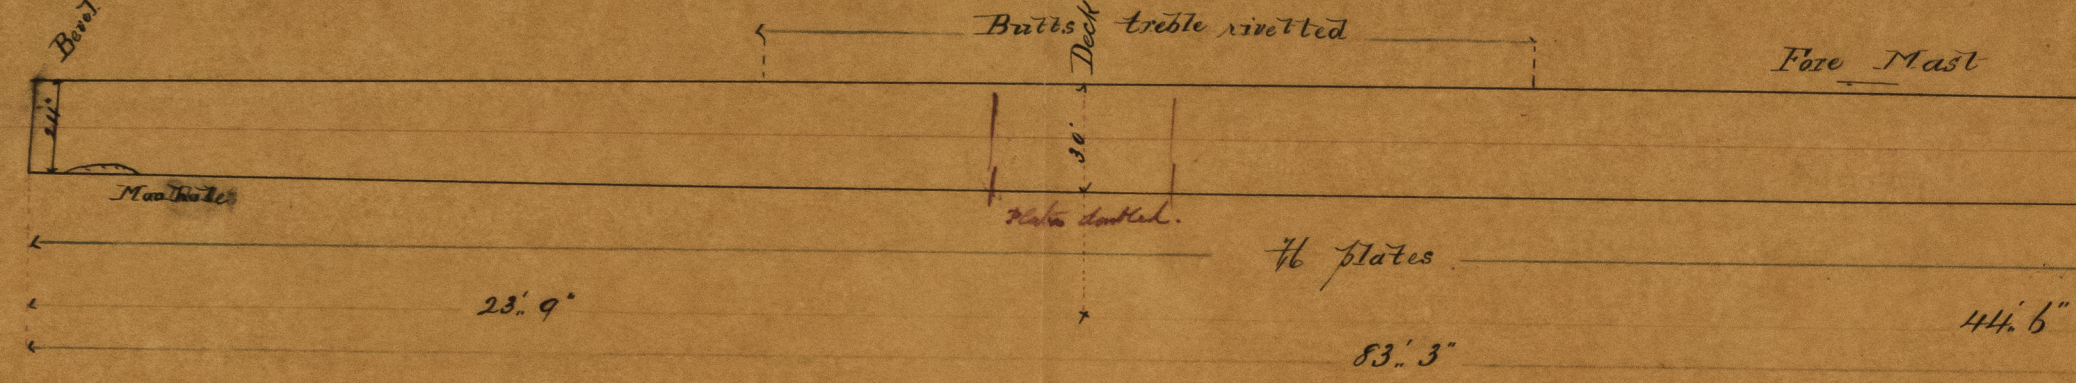

Bevel 1/4" to the foot

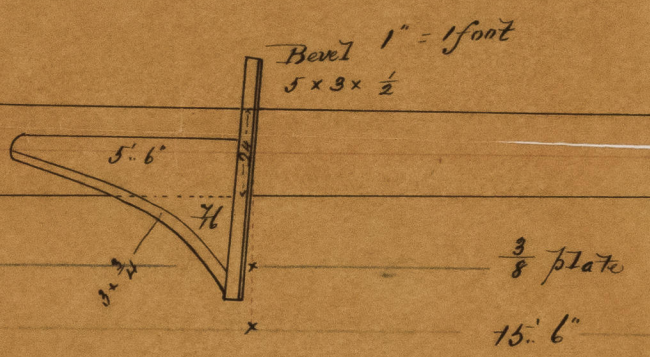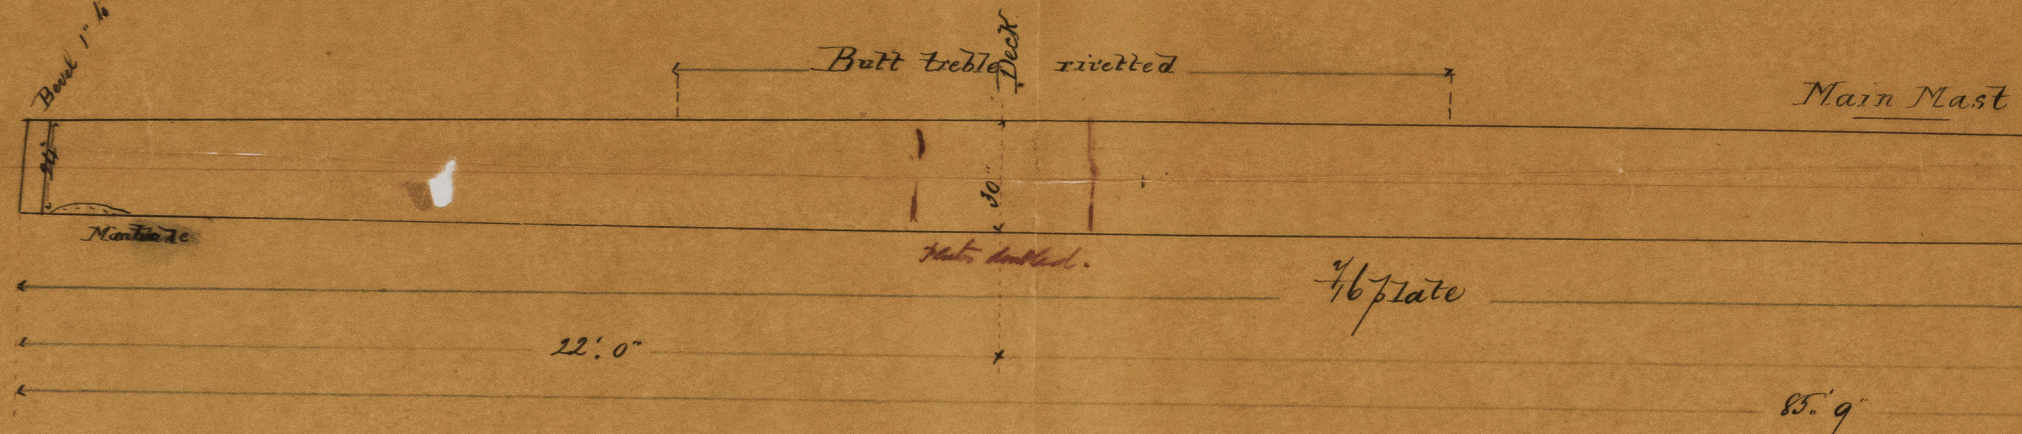


Bevel 1/4" to the foot

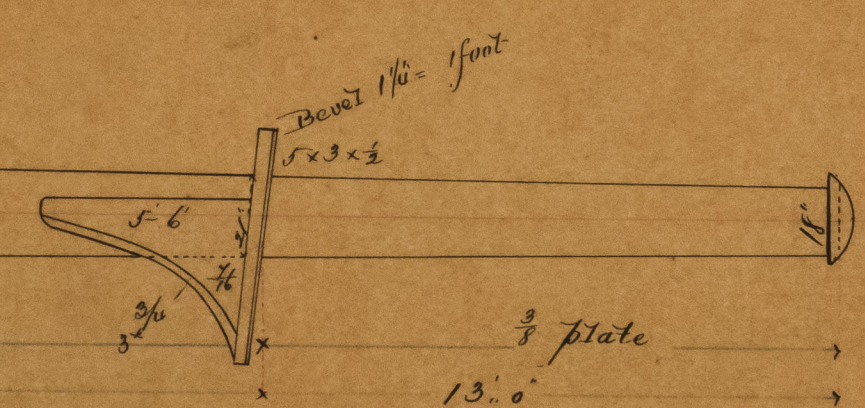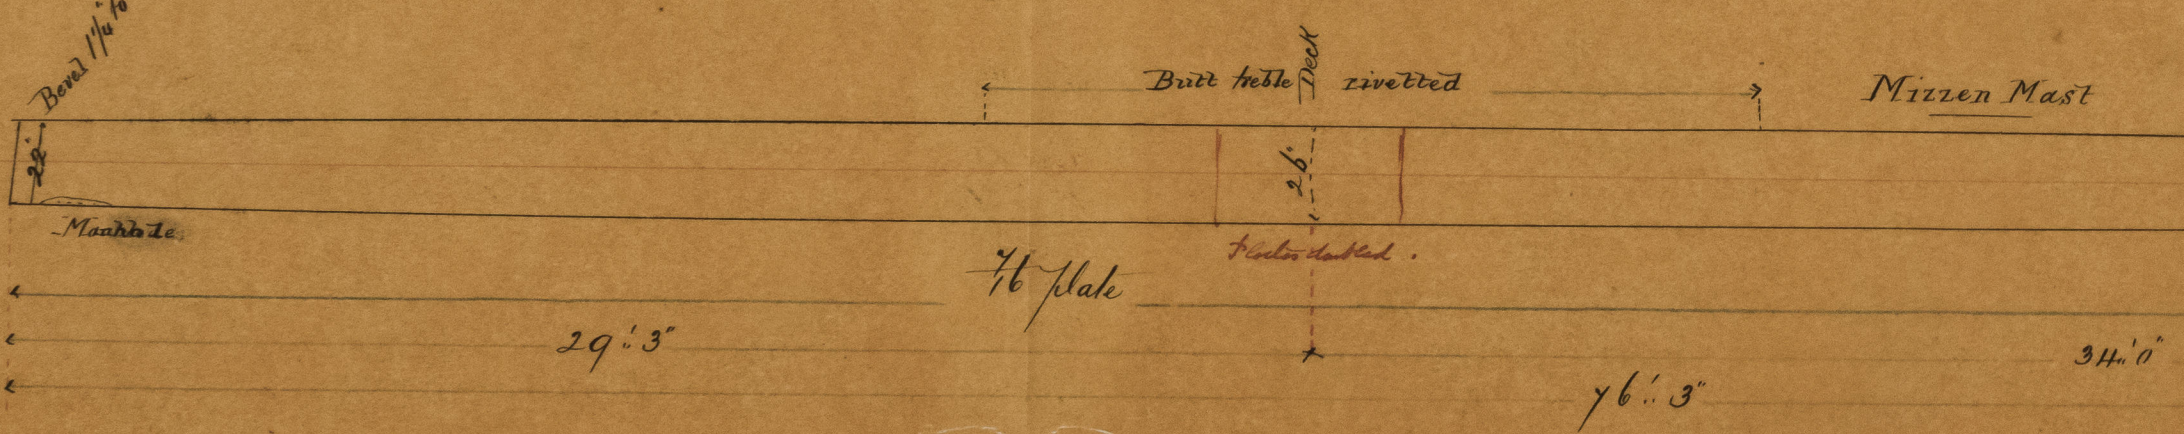


Plates in Bands of Mast 7/16 and 3/8
 Laps single riveted, butts double
 riveted except when marked
 otherwise
 Angles in number running the
 whole length 5 x 3 x 1/2
 3 rows of holes 3 ft apart
 1" diam holes punched below
 deck and all over manhole
 covers
 Plates 9 ft long butts shielded
 3 ft
 Cast iron covers bolted to angle
 iron top of masts
 5/8" rivets
 9 x 7/16" plates
 and riveting
 treble

Checks 1/4" = 1 foot
 Fore & Main Checks

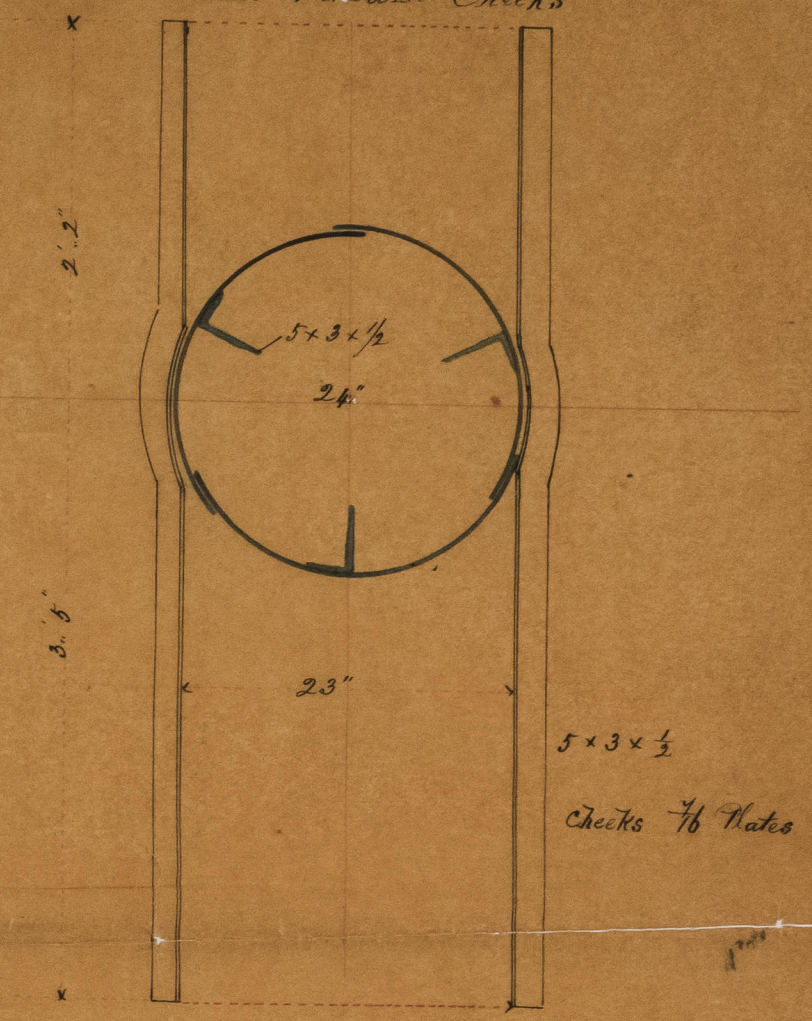

Mizzen Checks

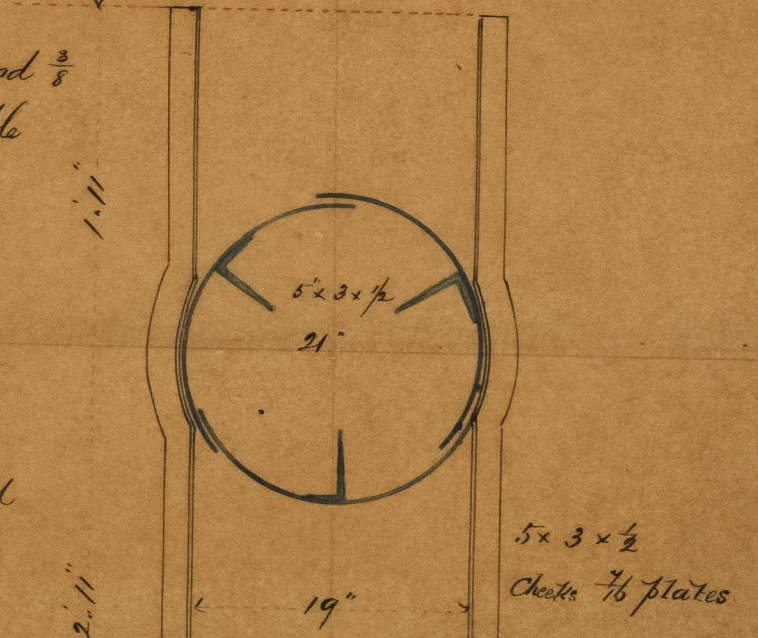

RICHARDSON, DUCK & CO.
 STOCKTON ON TEES

IRON 501-0101 1/2