


0550 Report No. 2714

Ship "Lutterworth"

Ship No 78 Midship Section.

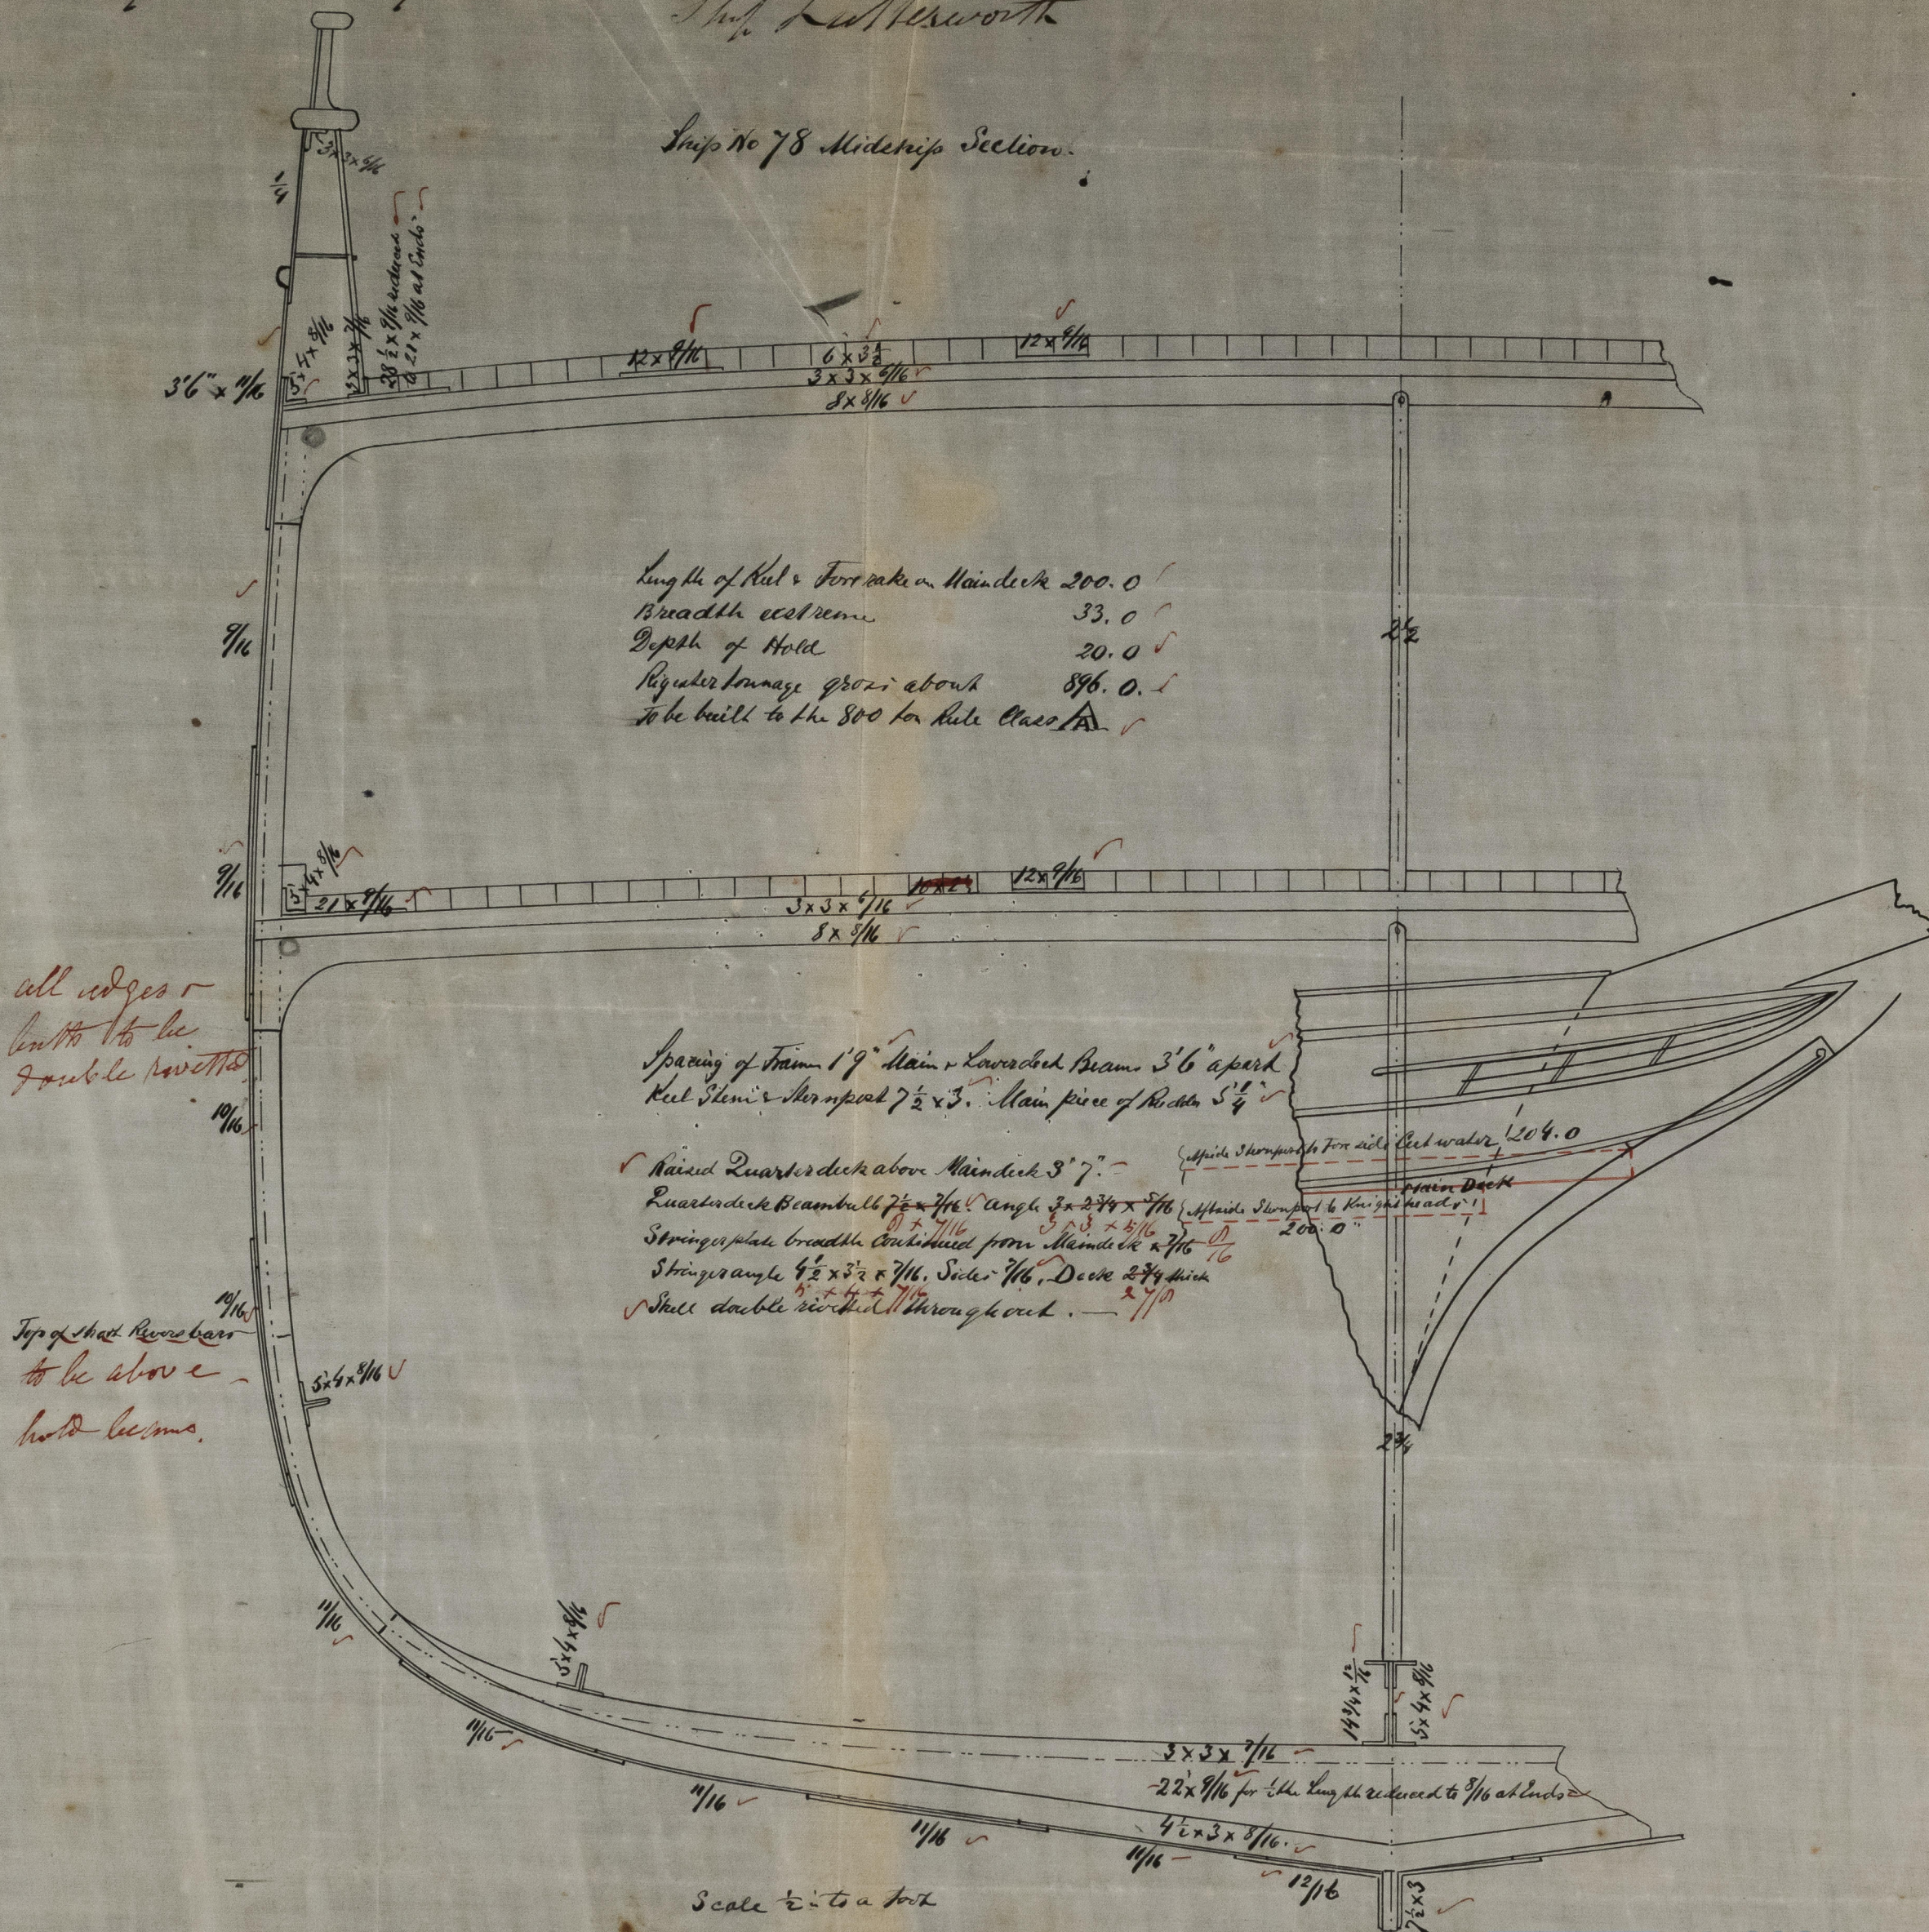

Scale 1/2" to a foot

Denton Gray & Co.
Middleton Iron Shipyard
Hartlepool N.S. 1868
© 2021
Lloyd's Register
Foundation

120501-0115

6770

IRON 501-0115