


Readhead Saffley & Co.  
South Shields  
1<sup>st</sup> July 1868

# Midship Section of Sailing Ship "Peri" Scale 1/2 ins = 1 Foot.

Iron 6798

6798

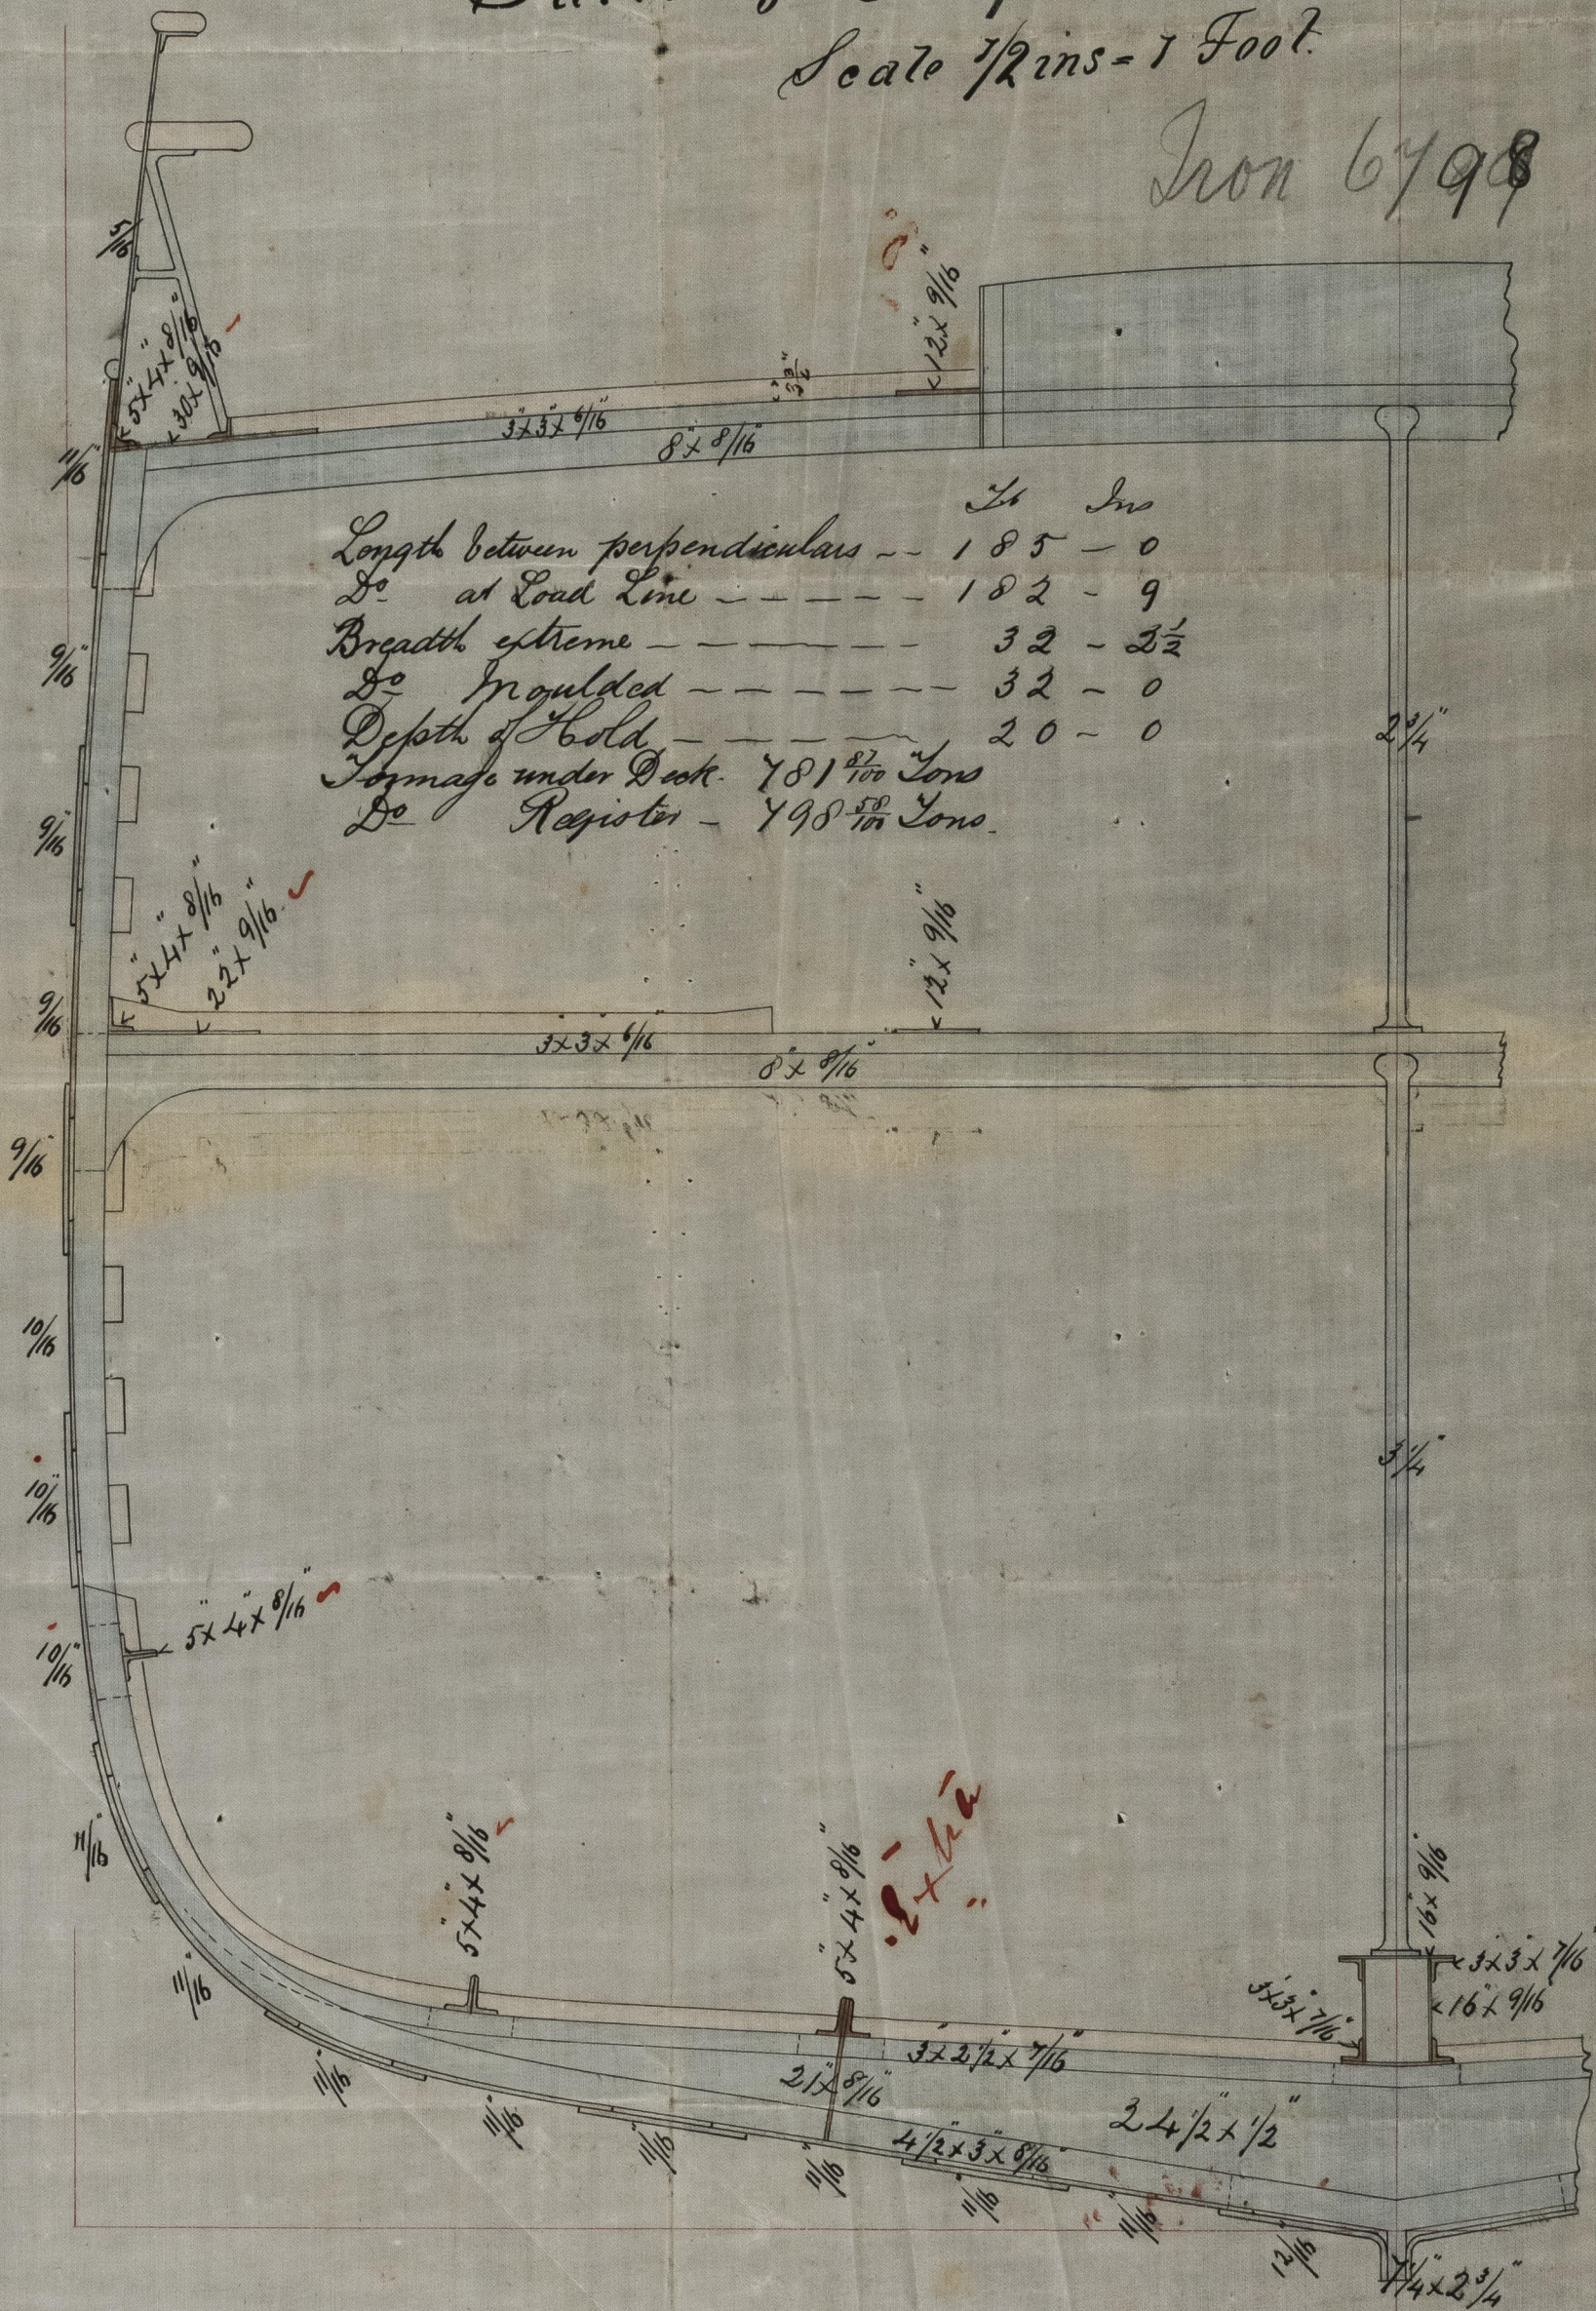

© 2021

Lloyd's Register  
Foundation

IRON 501 0118