


Double angle iron 5x34 7/16
 agreed to be fitted 24/4/68 J.H.L.

Two Iron Screw Steamers
 building by M. Lawrie
 Per 22/4/68
 J.H.L.

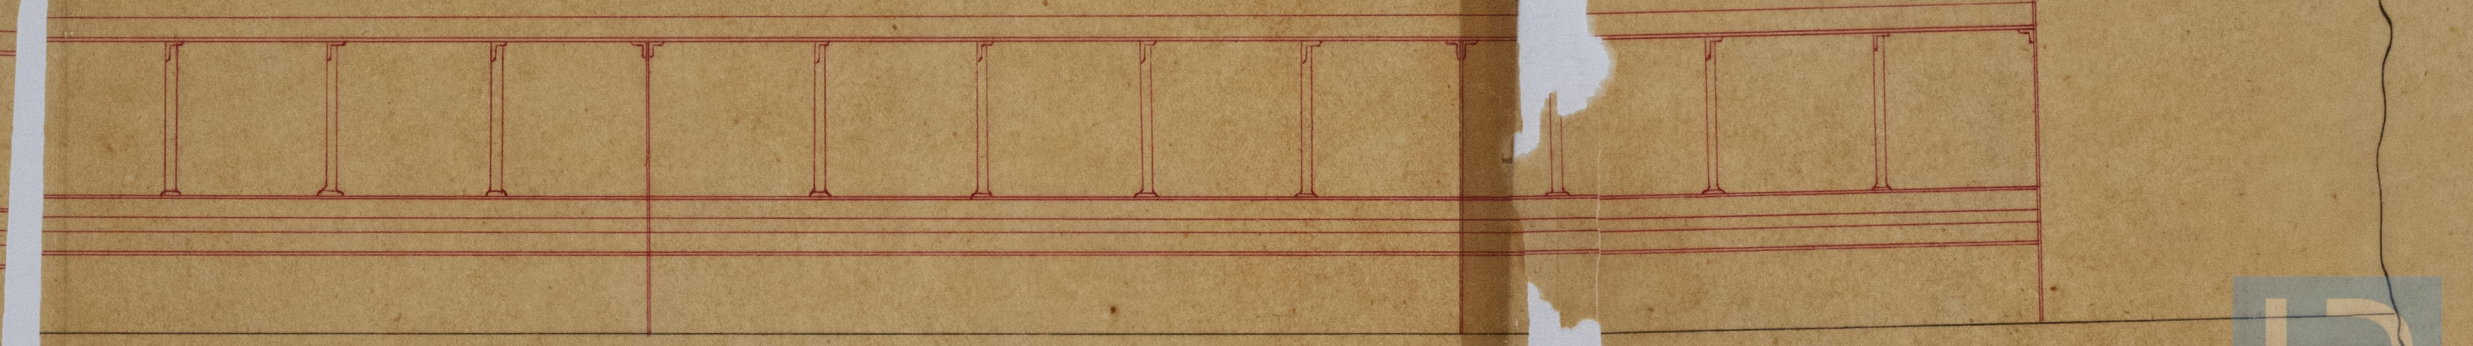

J.H.L.
 24 4 68

