


MIDSHIP SECTION, OF, S. S. N<sup>o</sup> 103

Length from afterside of Stern Post to foreside of Stern.....205 feet inches

Breadth extreme  $28 - 3 = 4.24 B$  in  $L$ .

Depth of Hold 15 - 5 - 13.32 Dir L.

Rec 5/12/68

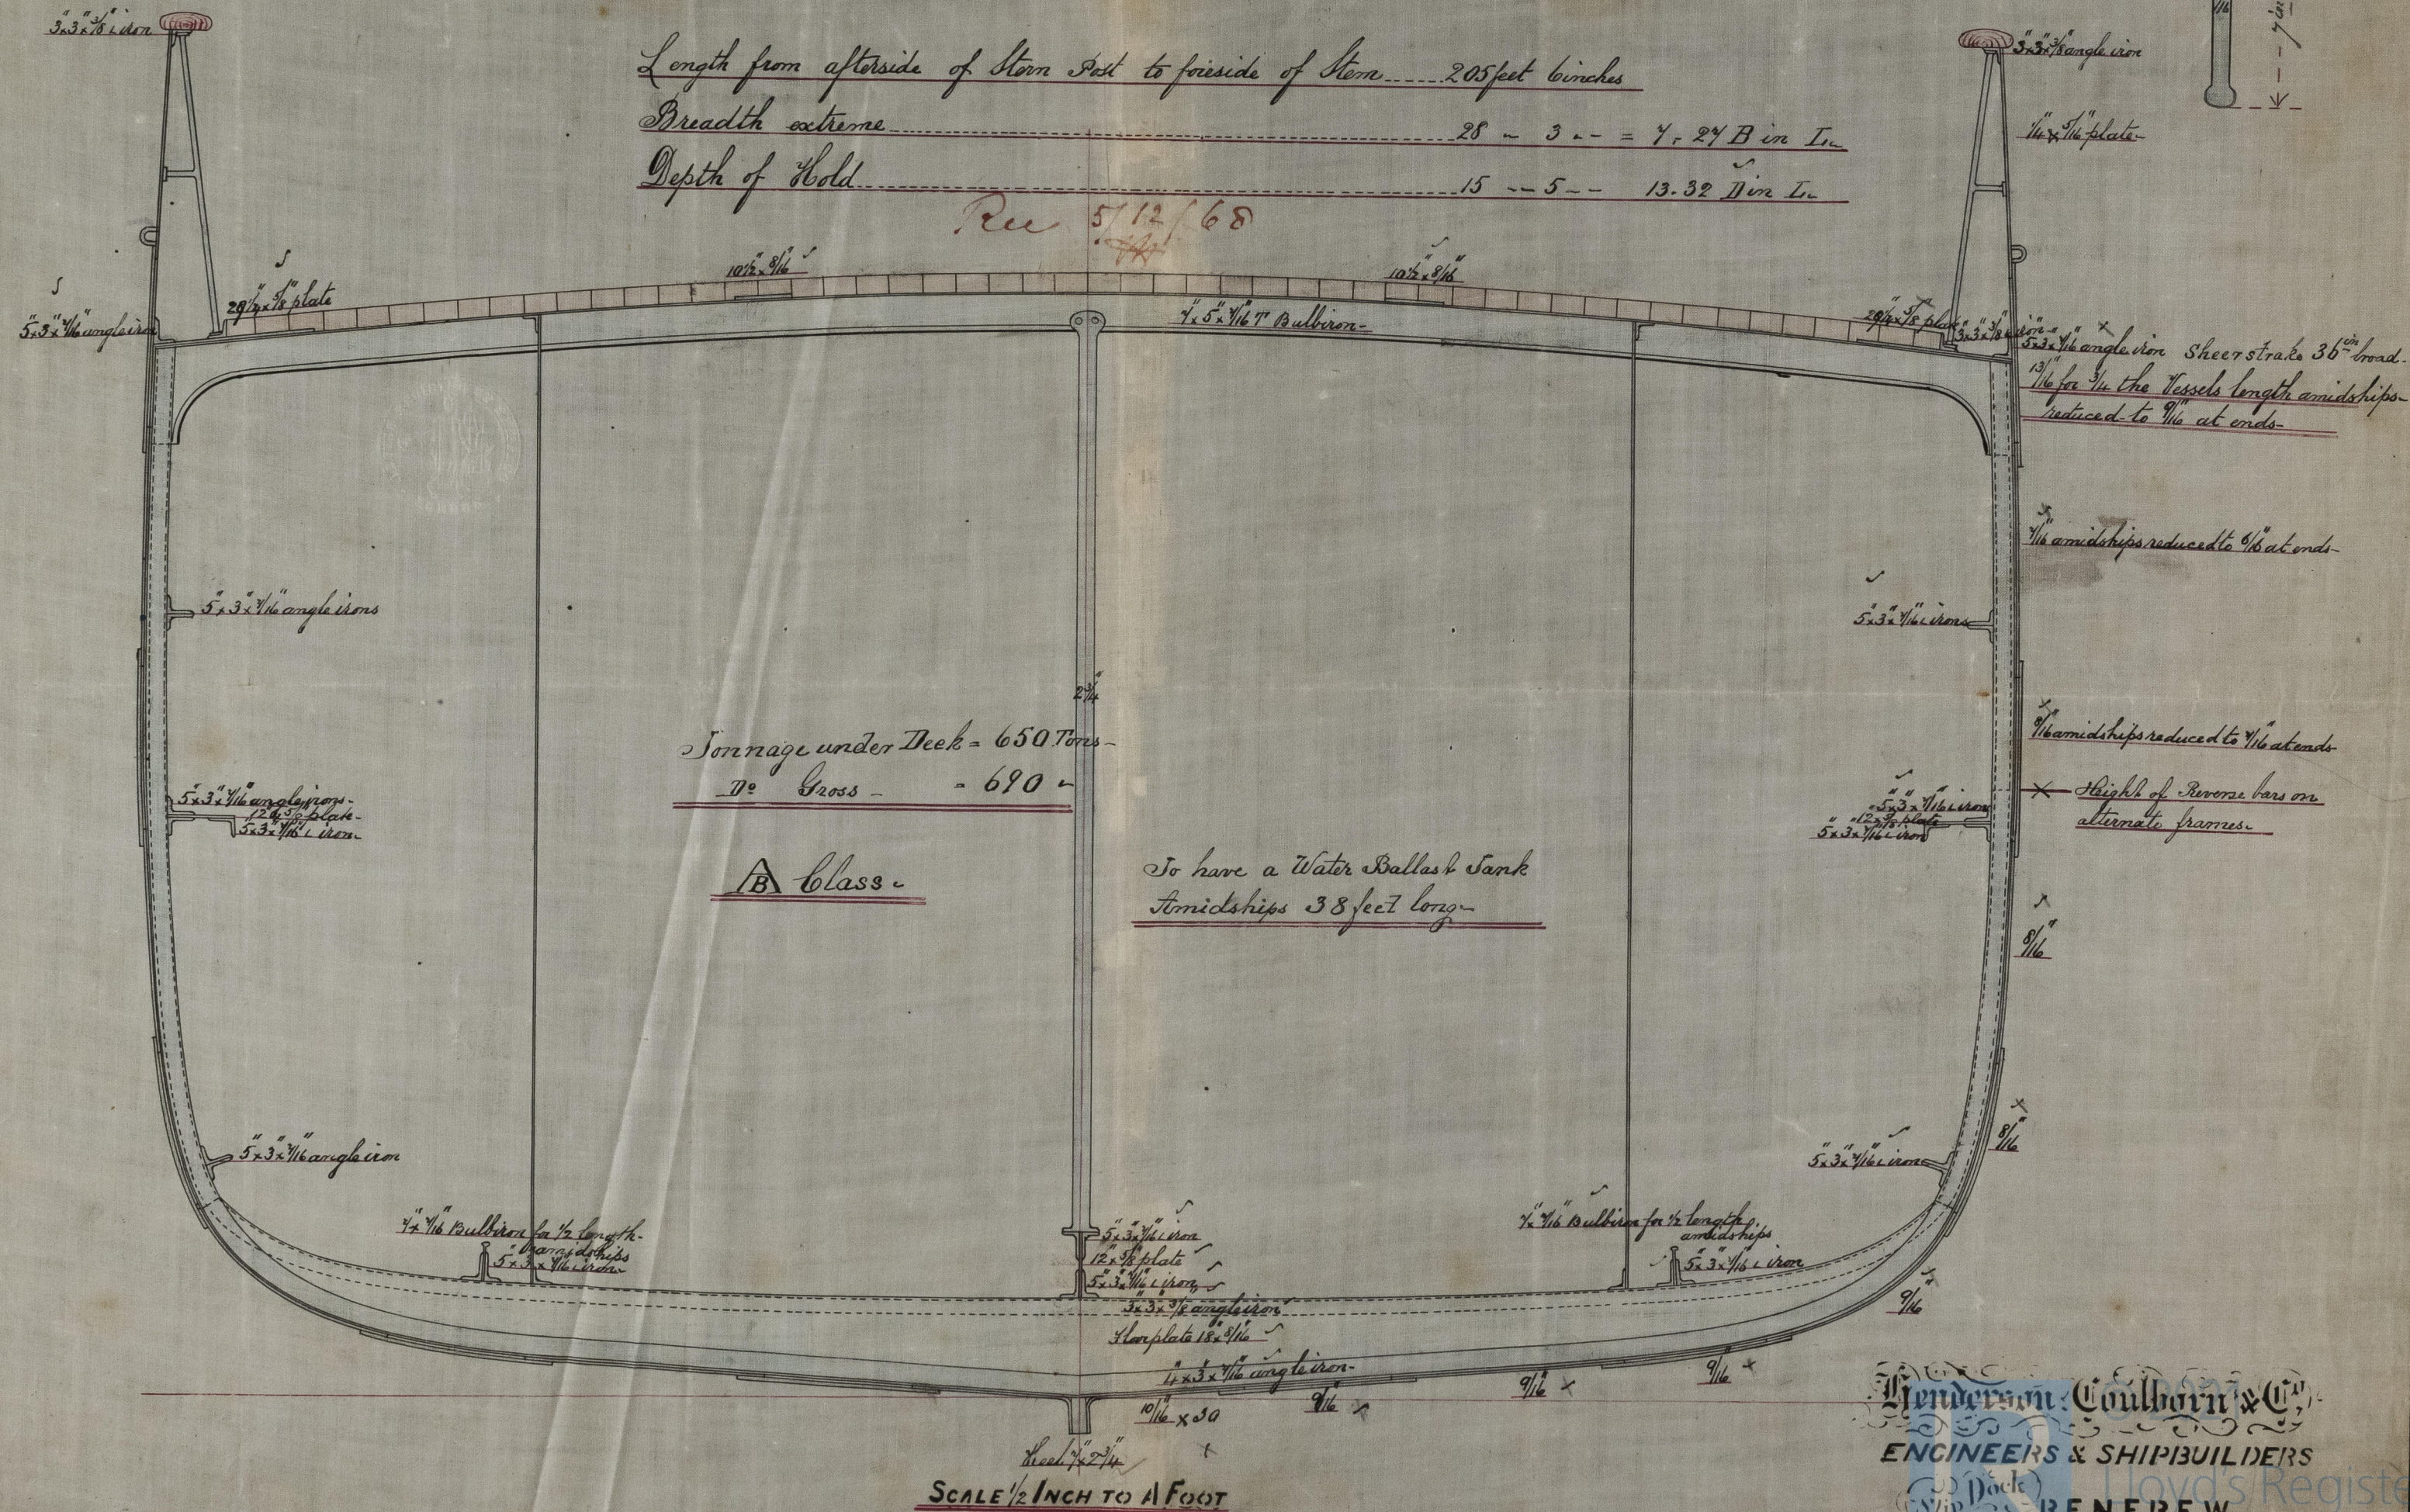

SCALE 1/2 INCH TO A FOOT

**Henderson, Coulborn & Co.**  
**ENGINEERS & SHIPBUILDERS**  
Ship Dock  
**RENFREW**

3<sup>rd</sup> Decr 68

IRON 501-0239