


**Palmer's Ship Building & Iron Co.**  
— Limited —  
Newcastle on Tyne

"Lloyds"  
 Dec 7/53.

Scale  $\frac{1}{2}$  inch to a foot

Rec. 22/12/68 & 29/12/68 & 8/1/69

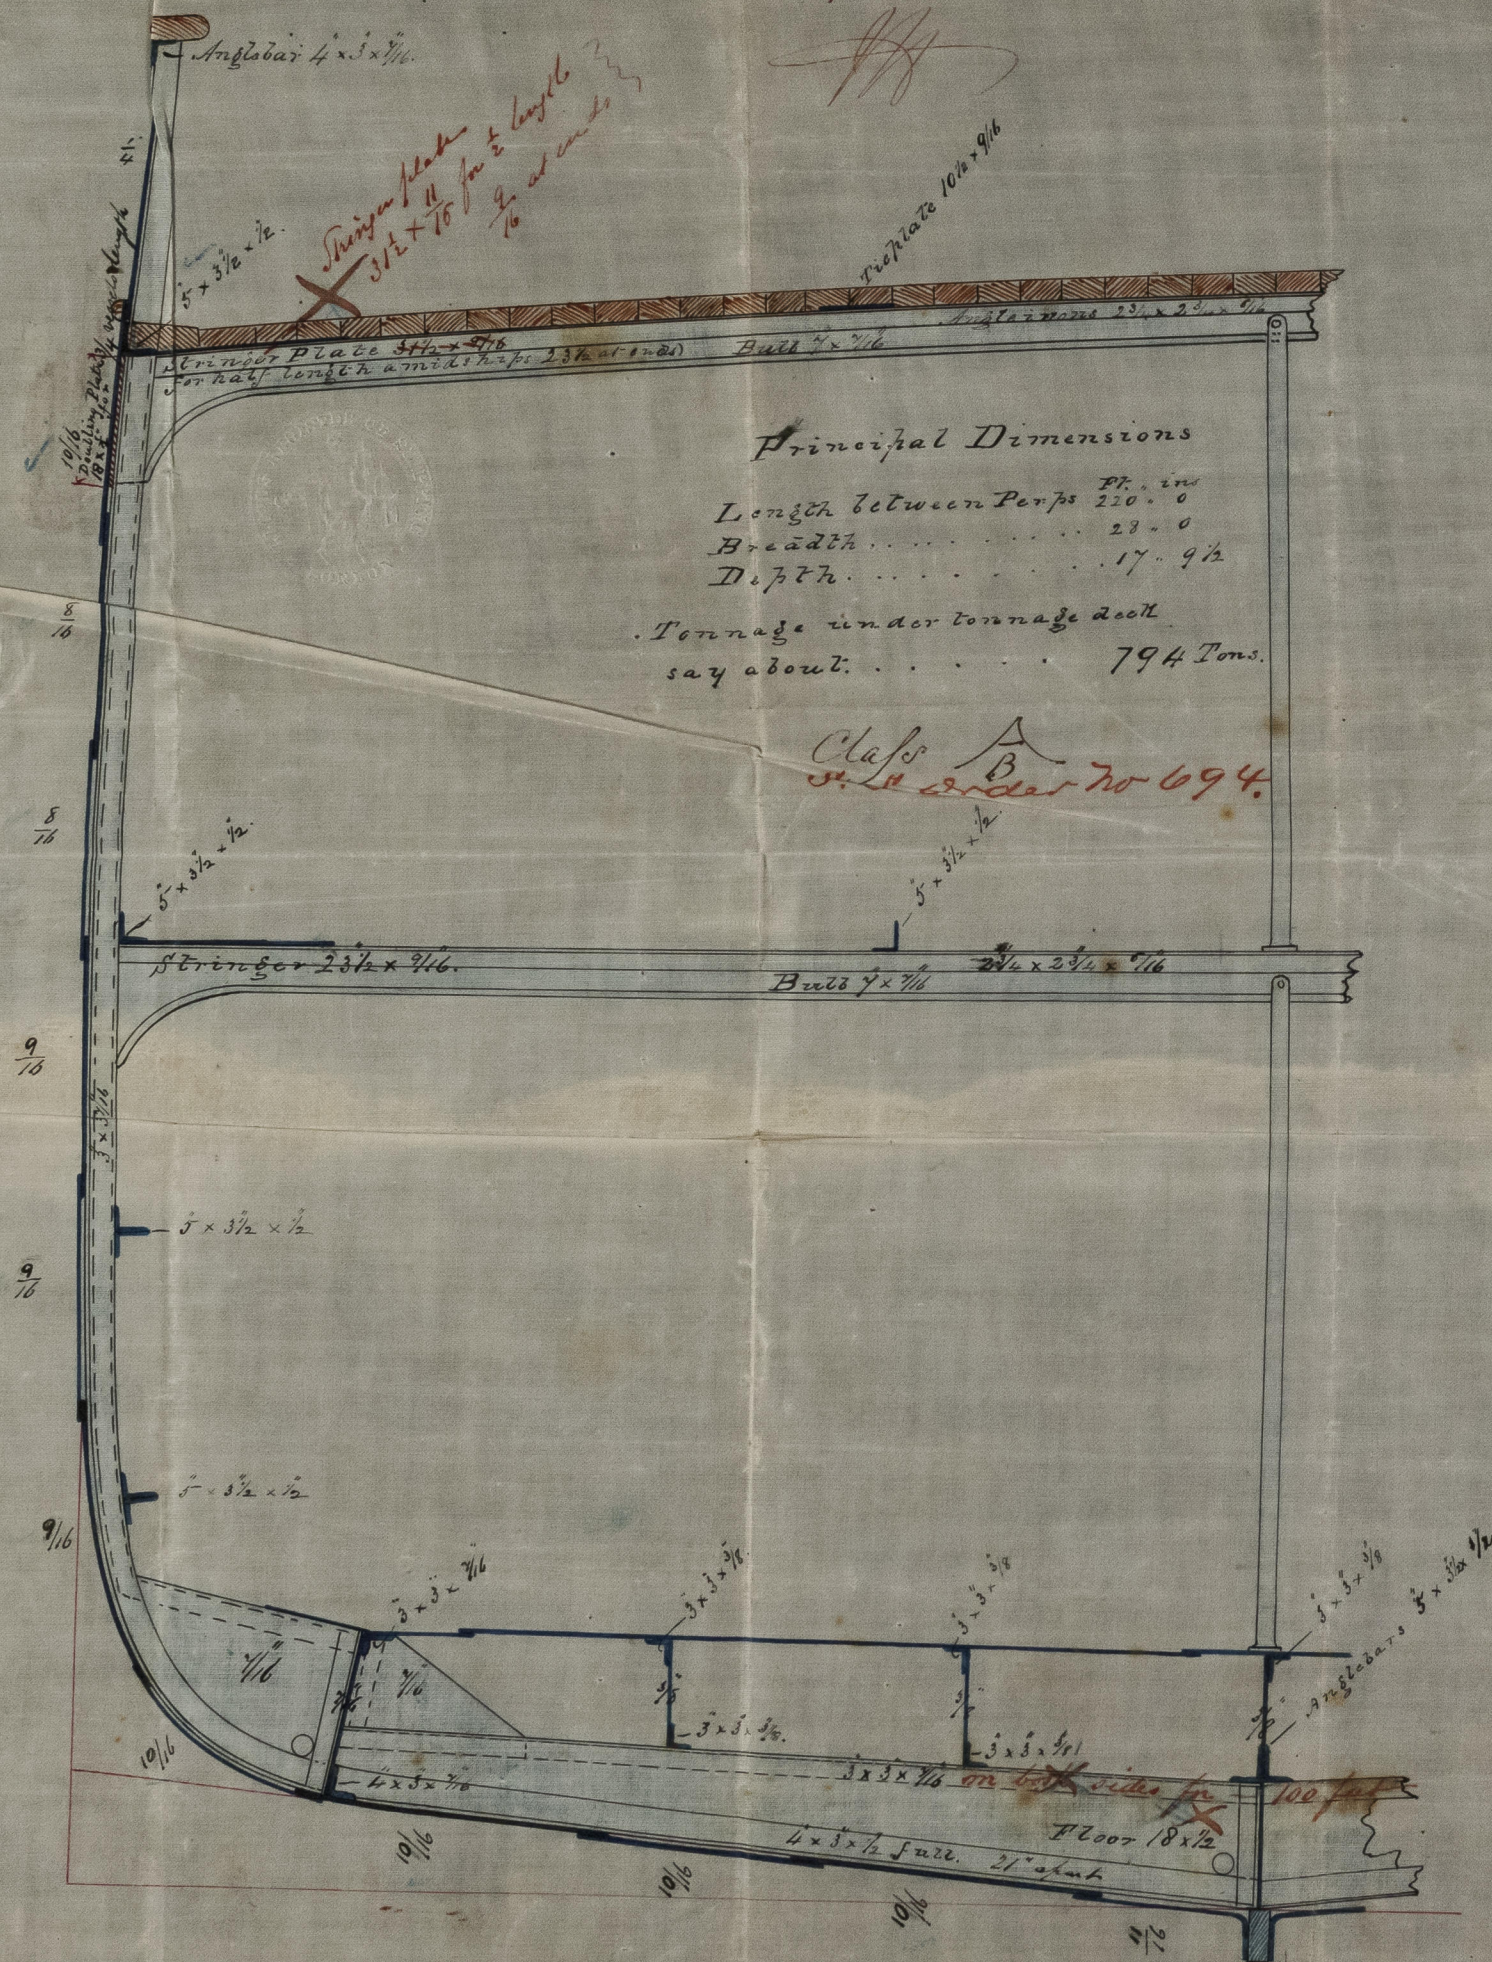

Class  $\begin{matrix} A \\ B \end{matrix}$  No. 694.