


MIDSHIP SECTION SHIP

Scantling  
 Principal  
 Length on load line  
 Breadth Moulded  
 Extreme  
 Depth in hold to  
 Tonnage O. B. N.  
 Class A

Ex-boma - 227. 2

Flush deck hull

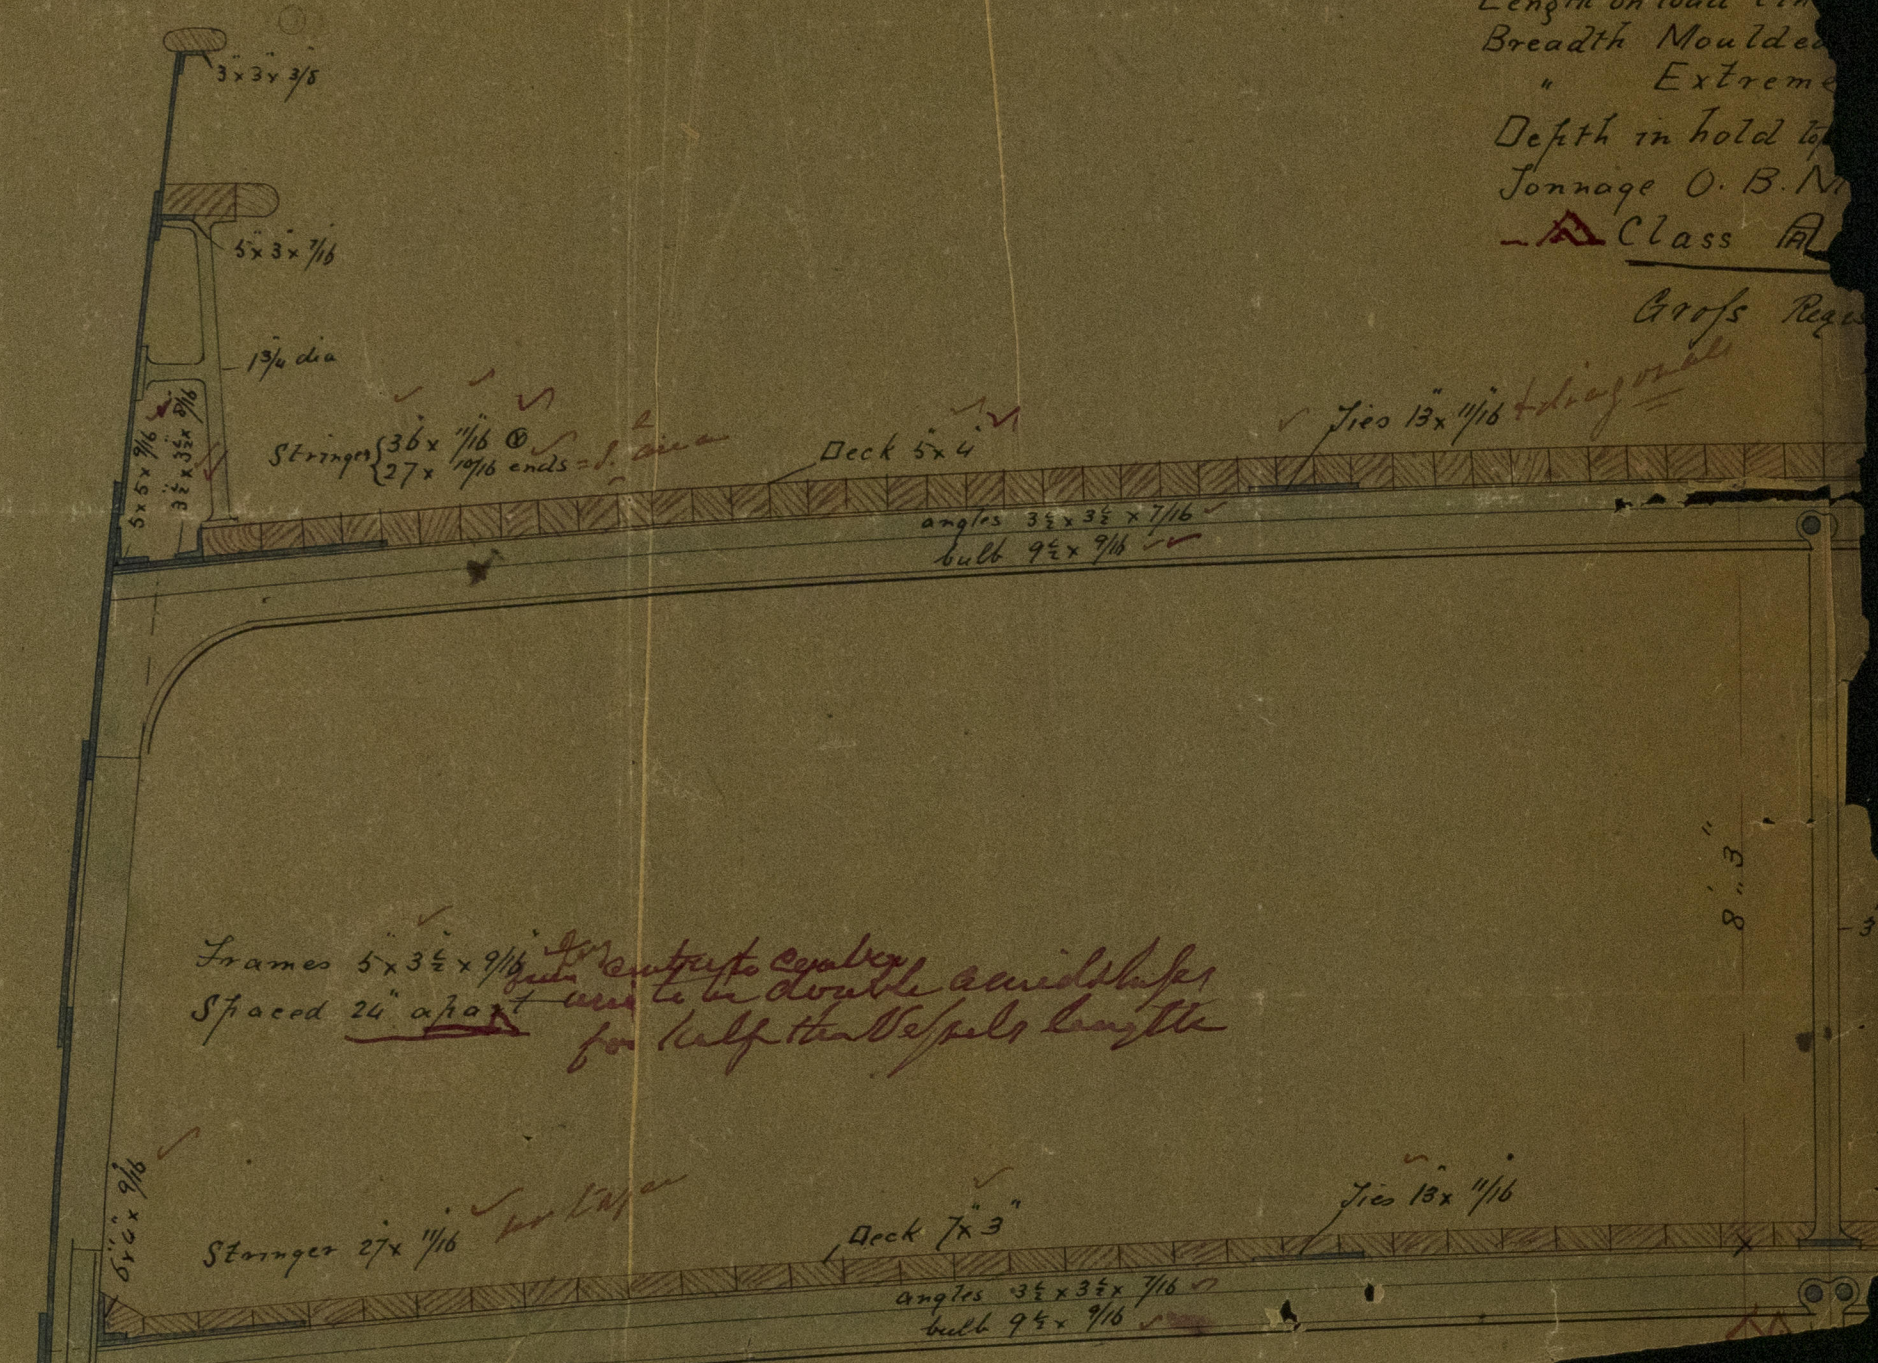

Reverse frames 3x3 1/2 x 9/16 extending to Gunwale & hold deck alternately


5x5 x 9/16 with lugs

6x4 x 9/16 no lugs

6x4 x 9/16 no lugs

Plate 1/16 fitted for 2' length @ angles 6x4 x 9/16

3x3 x 1/16

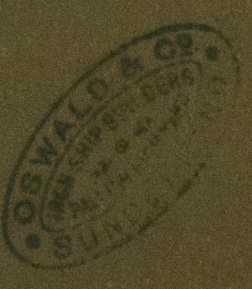

1200501-0259 2 1/2

1200501-0259 1/2