

Midship Section showing Proposed Hold Stringer for

Seven Steamers.
 Length keel and fore rake. 165' 0"
 Breadth 23' 6"
 Depth 12' 0"


"Claire"

Rev 11/9/68

Mr E J W Letter to
 Winton dated Sept 21/60
 States depth to top of
 plate mill on 12. D₂ thus
 being less than 13 ft
 in depth, they also say about
 35 tons gross.

Load 25 1/2

Letter to
 Winton
 Recd 28/9/68

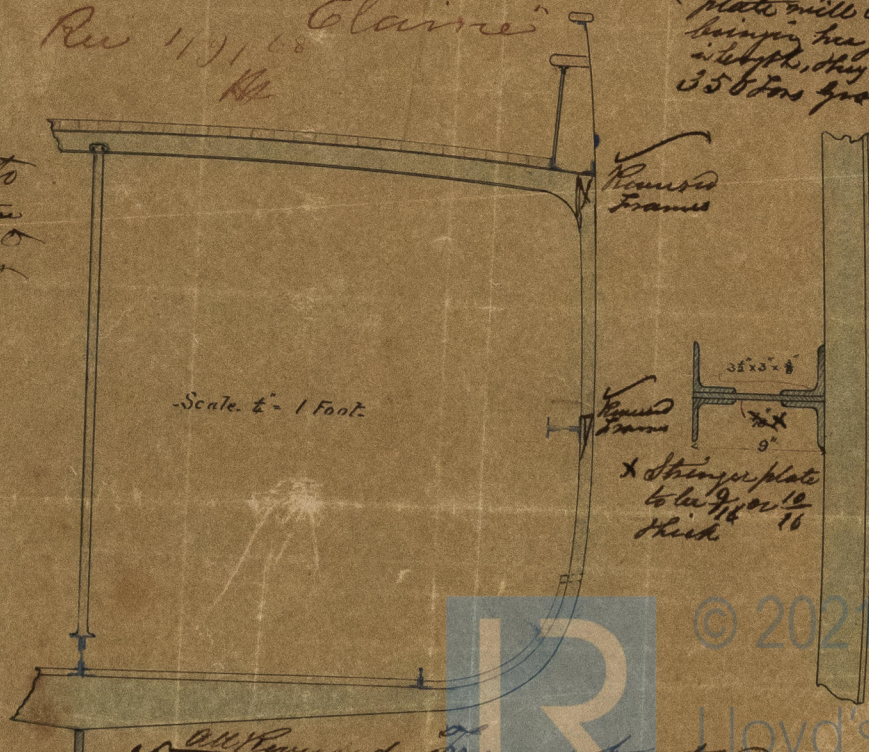

Scale. 1" = 1 Foot.

Scale. 1" = 1 Foot.

Stringer plate
 to be 9 1/2 or 10
 thick

All Revised Frames to extend
 to above stringer angle for all machines
 and on alternate frames from thence
 to upper Deck Stringer Plate. 2/10/60

12001-0201