
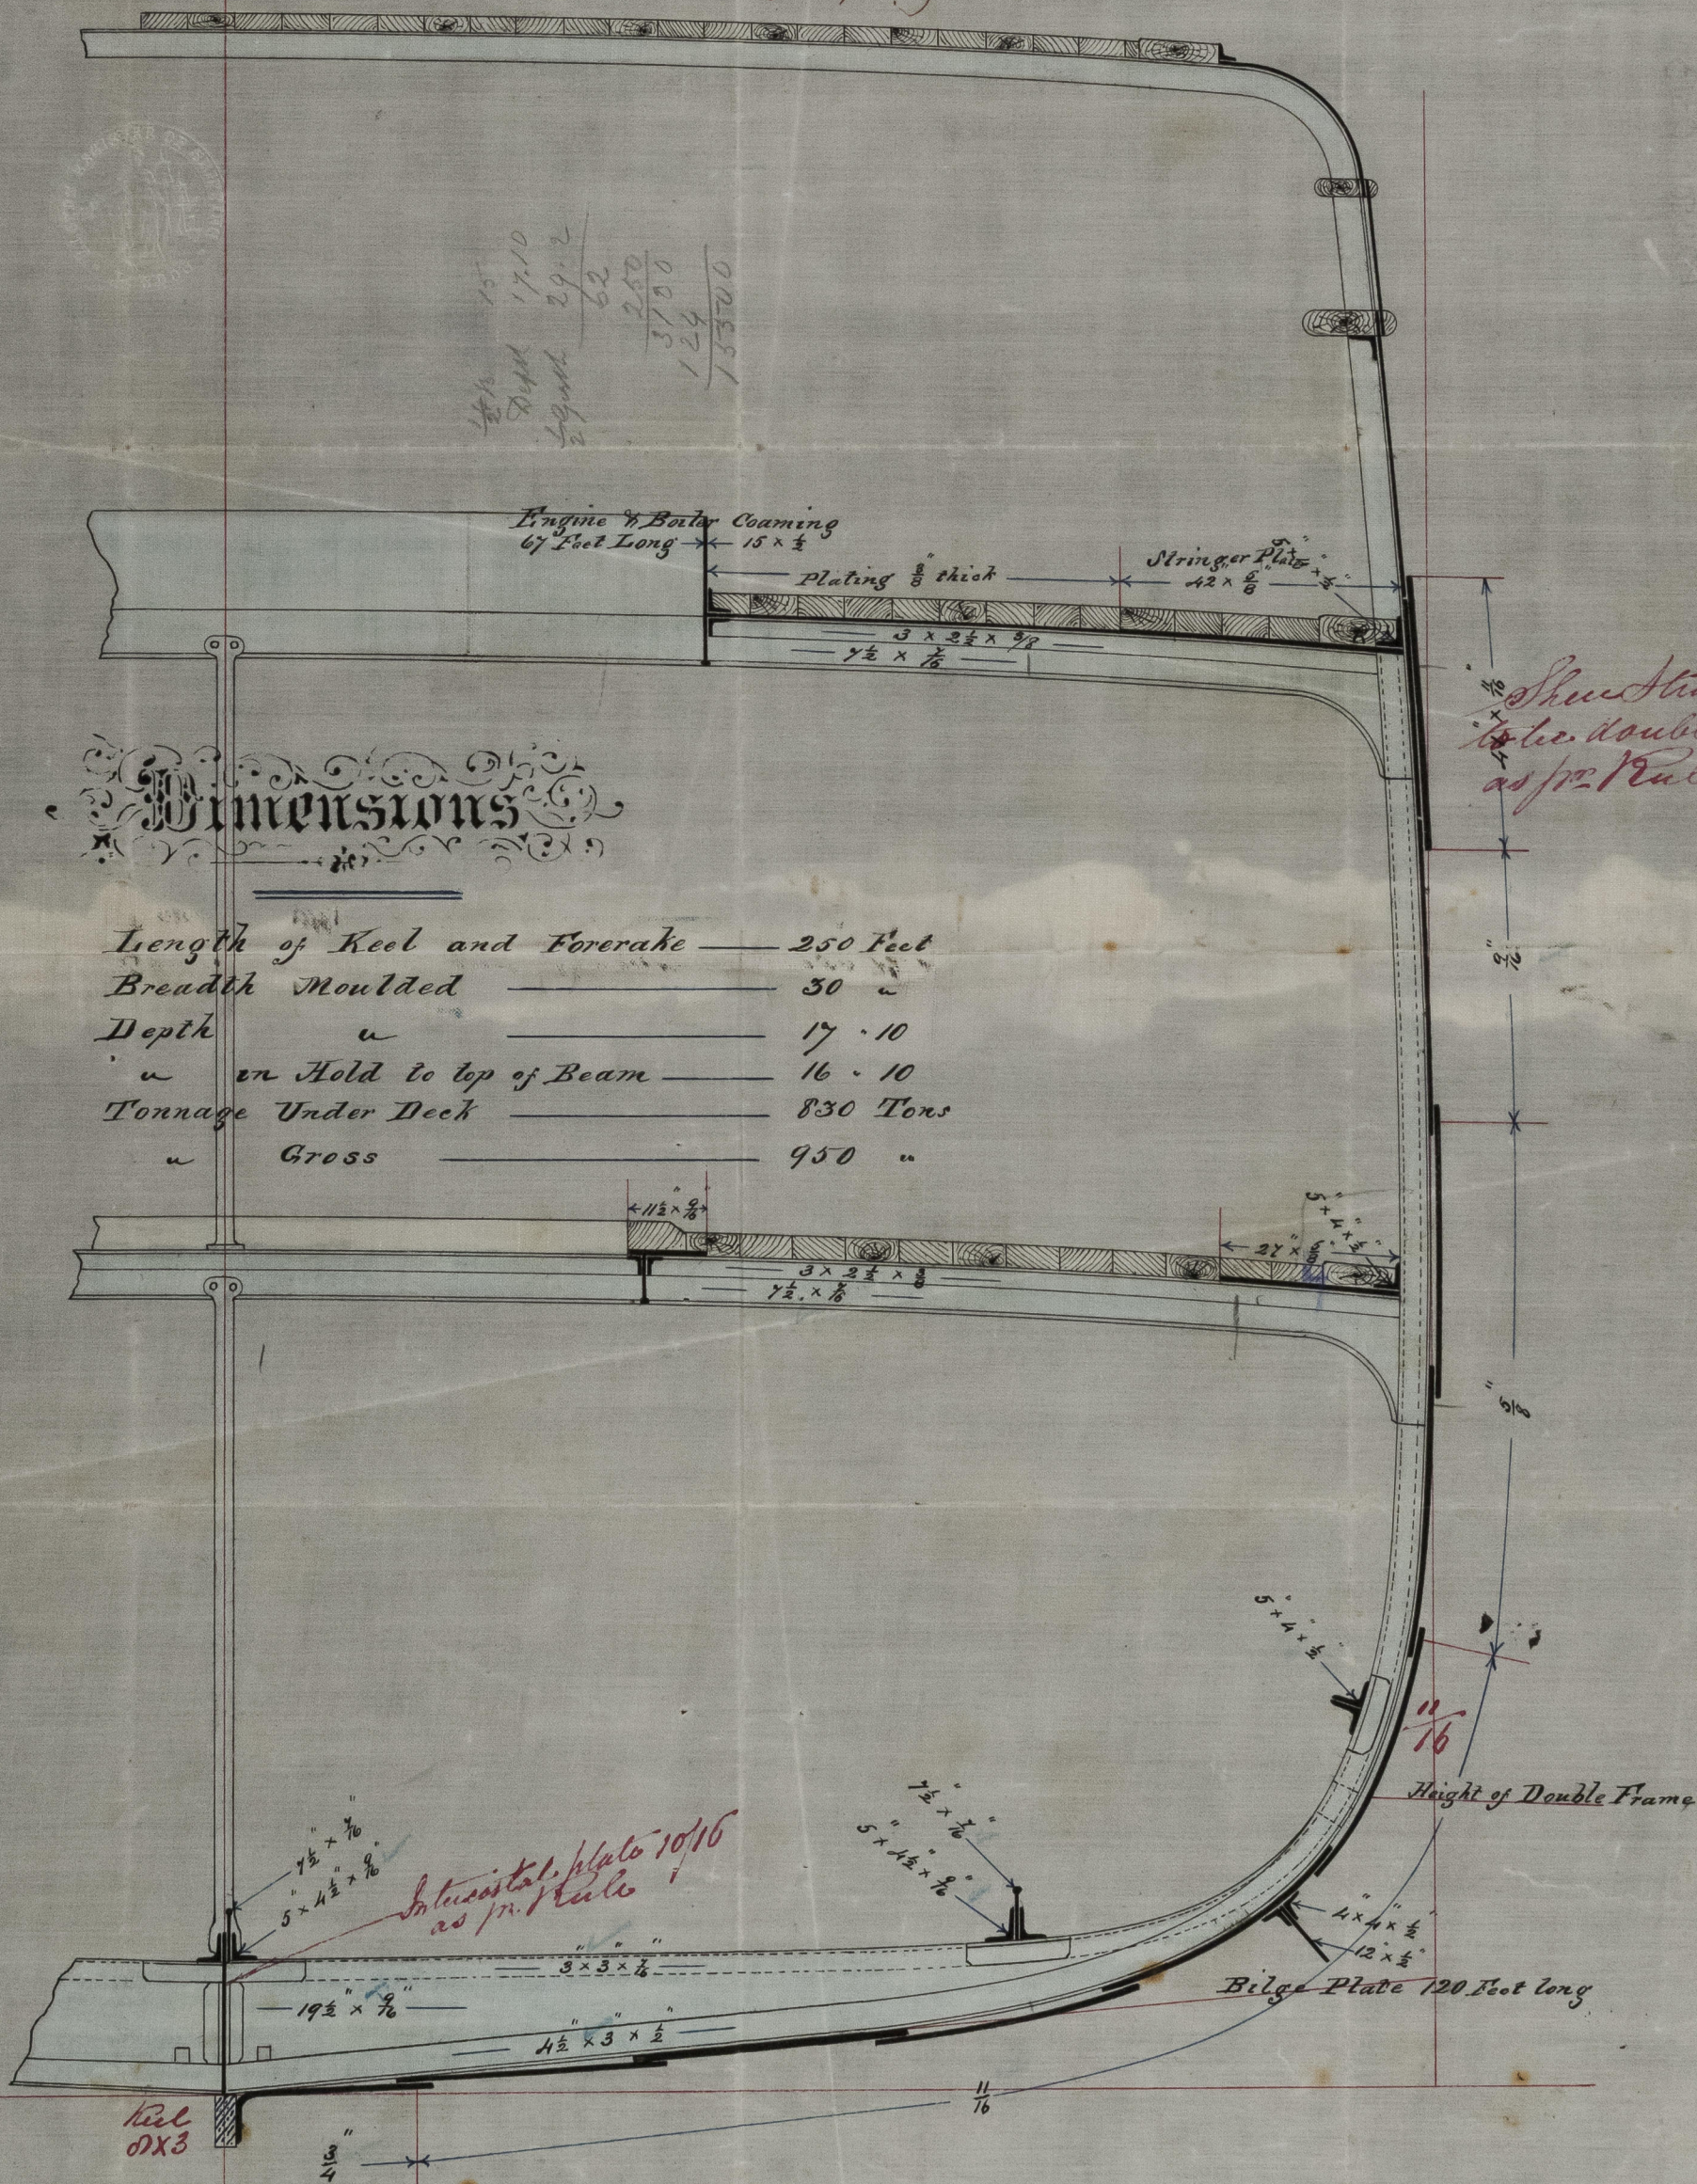


MIDSHIP SECTION

SCREW STEAMER No 41

Libra *Rev. 22/2/69*

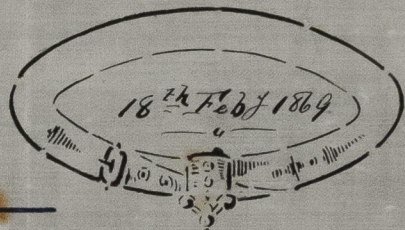

SCALE $\frac{1}{2}$ INCH TO A FOOT



© 2021


Lloyd's Register
Foundation

IRON SOL-0313

7314 Iron Ship

1200501-0313



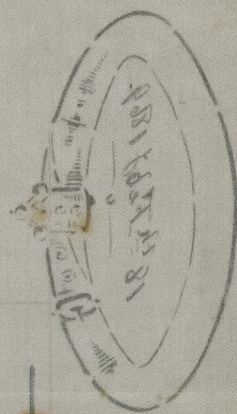

SCREW STEAMER

SECTION

SCALE 1/2 INCH TO A FOOT

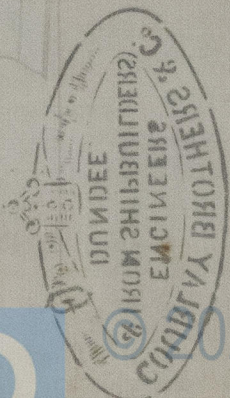

Lloyd's Register Foundation