
 


Libra

DECK PLAN
— SCREW STEAMER *Nº 41* — *Rev 22/11/69*

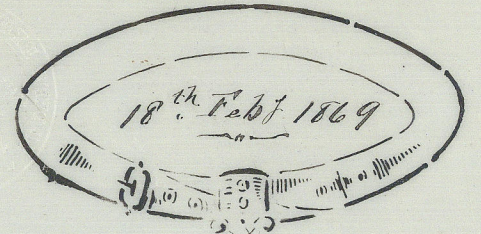

SCALE $\frac{1}{4}$ INCH TO A FOOT

*See letter to Lloyd's Register
5/3/80*
Lloyd's Register
Foundation
1800501-0314