


From 7/4/72 Midship Section of S.S. "Isabella Croll"

Scale $\frac{1}{2}$ inch = one foot

roll. Not named "Harvard"
see Report, p. 5666 (Cincinnati)

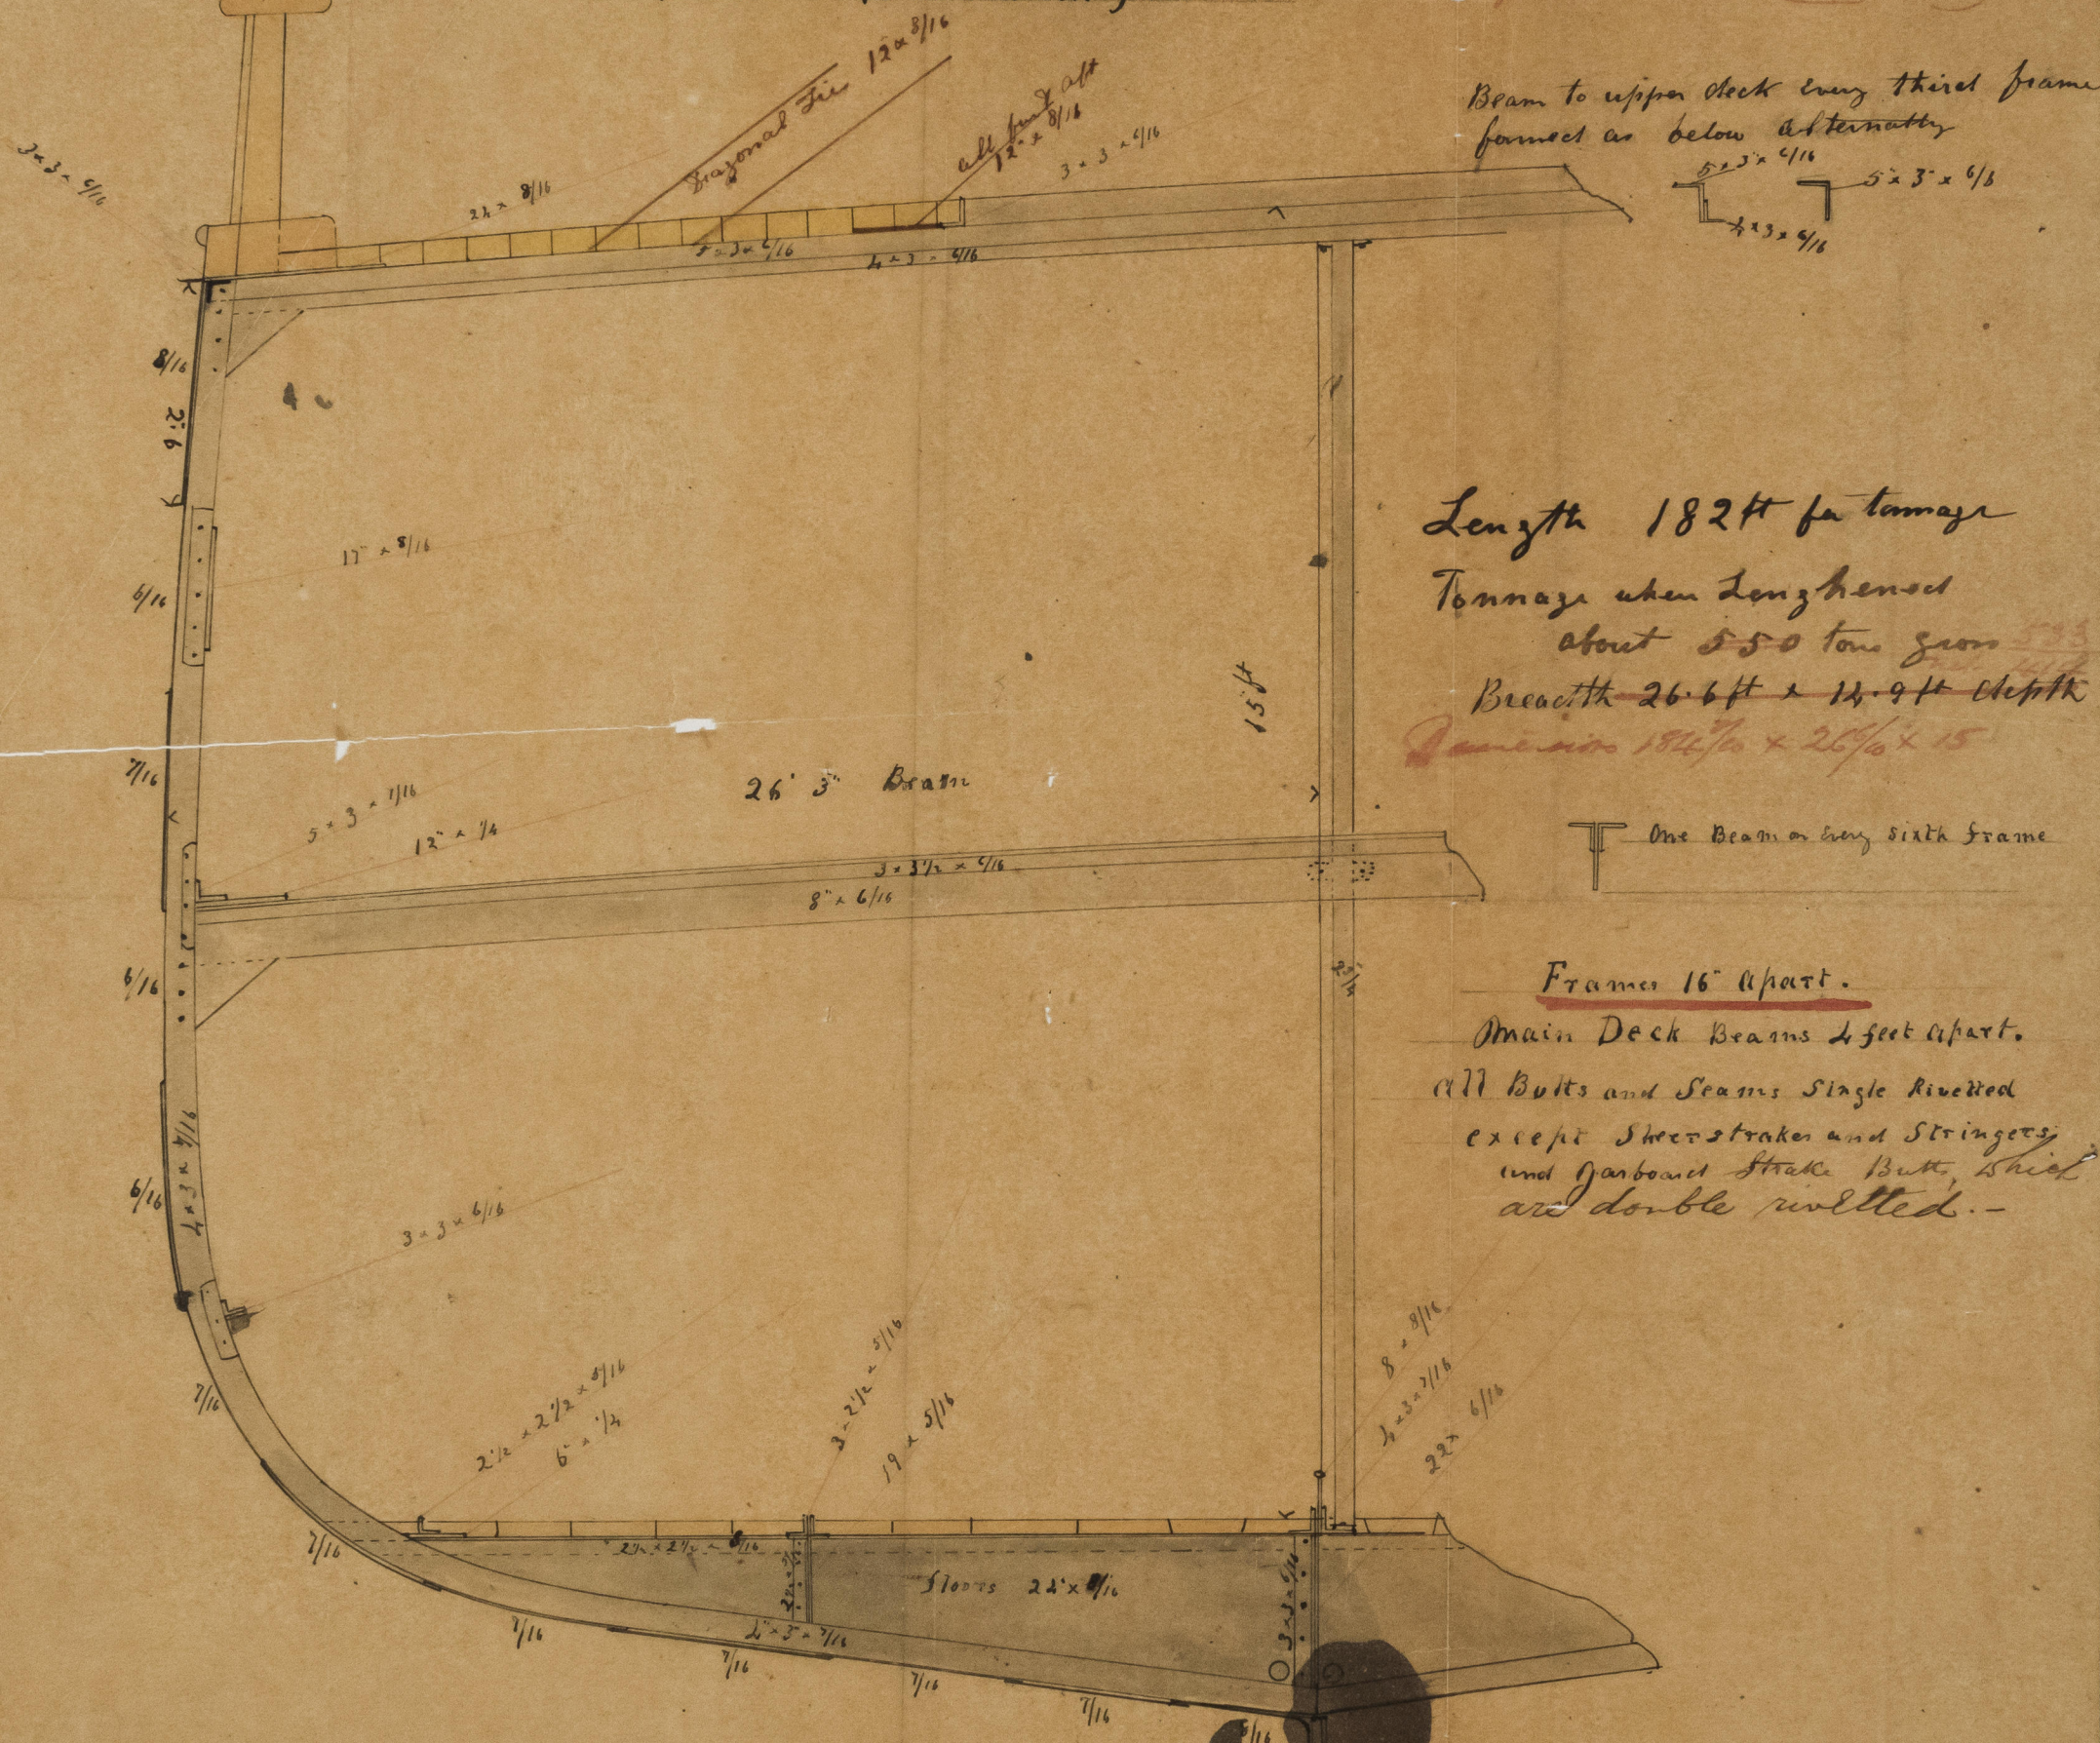

Length 182 ft for tannage

Tonnage when Lengthened
about 550 tons gross

Breadth $26.6 \text{ ft} \times 14.9 \text{ ft depth}$


T One Beam on every sixth frame

Frames 16" apart.

Main Deck Beams 4 feet apart.

All Bolts and Seams Single Rivetted
except Sheerstrakes and Stringers,
and Garboard Strake Butt, which
are double rivetted. -

Lloyd's Register Foundation

H. M. J. Henry 1861 Port Glasgow

Rev 502 - 0037