MIDSHIP SECTION No. 85

Scale 1/2 inch to 1 foot

Principal Dimensions

Length between perpendiculars	220'·0"
Breadth extreme	37·3
Depth in hold to top of floors	22·4
Tonnage Builders measure	1458
— " — Register under M.d. abt	1175

Class Ad Lloyds 1000 ton scale

Full poop & J G Forecastle - Gross abt 1275 tons

Mfr. Oswald Jr.
Rec 23/4/69
Order No. 2202

Rec. 15/4/49

Rec 23/4/69

Ship Oxford

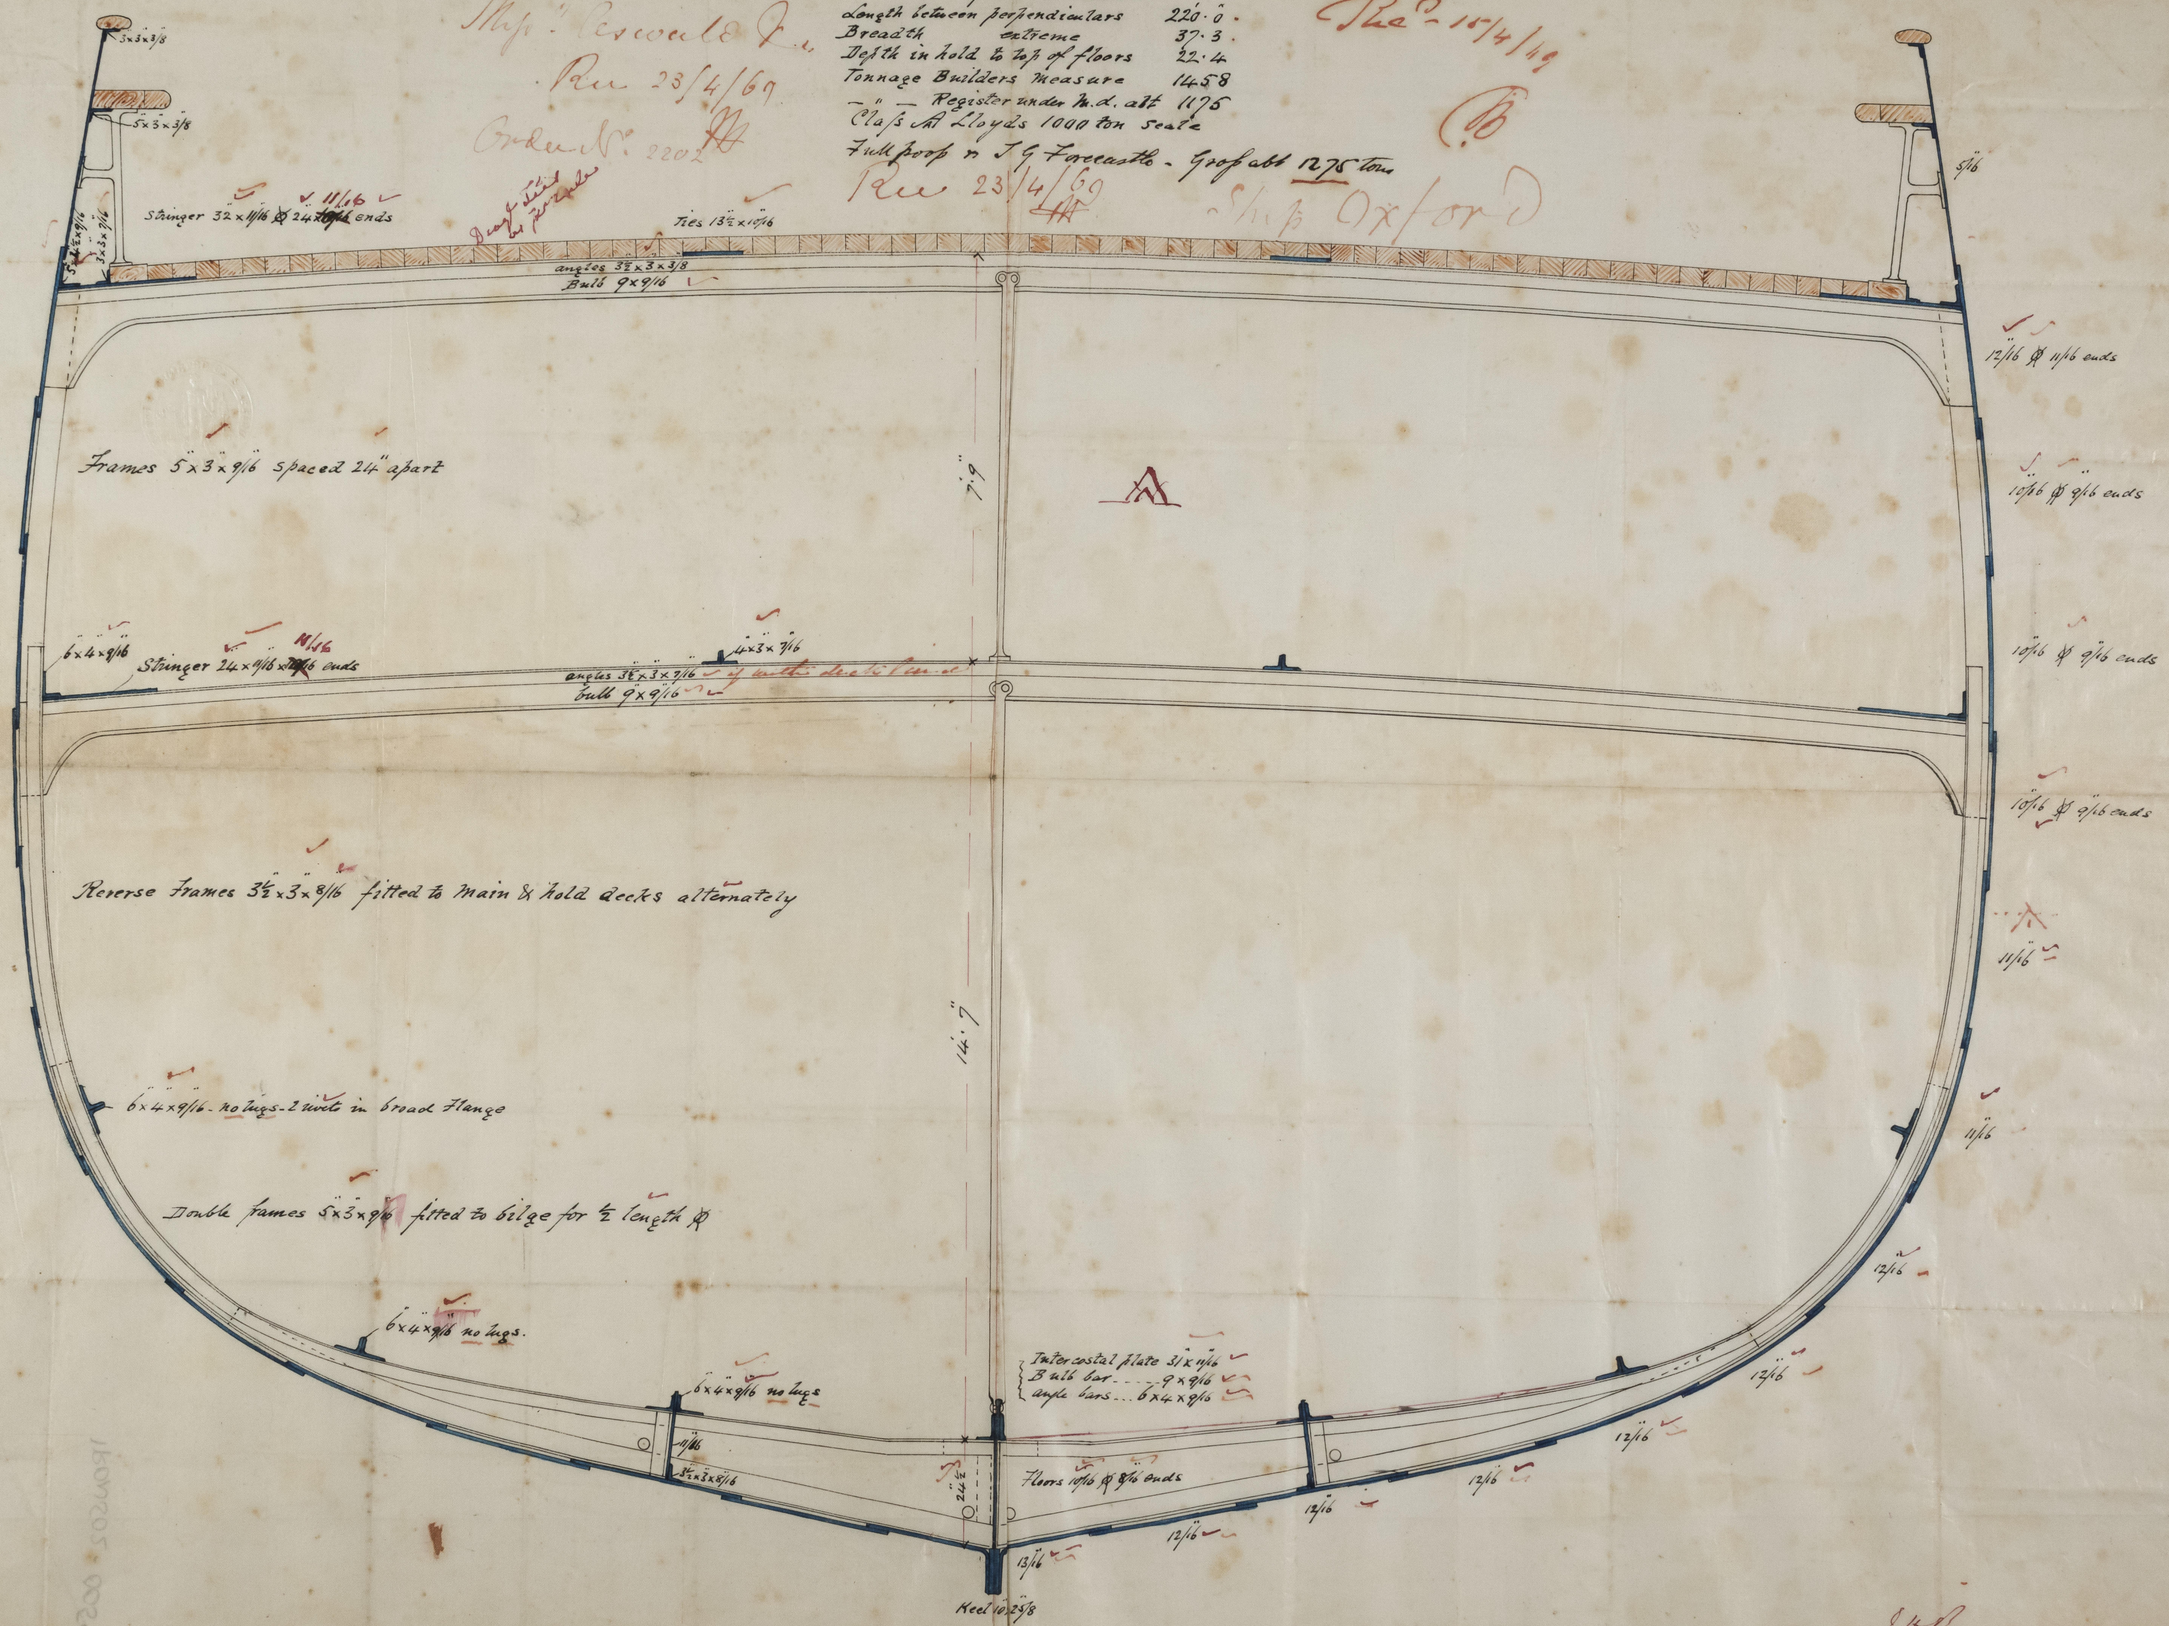

1207

IRON502-0059

© 2021 Lloyd's Register Foundation

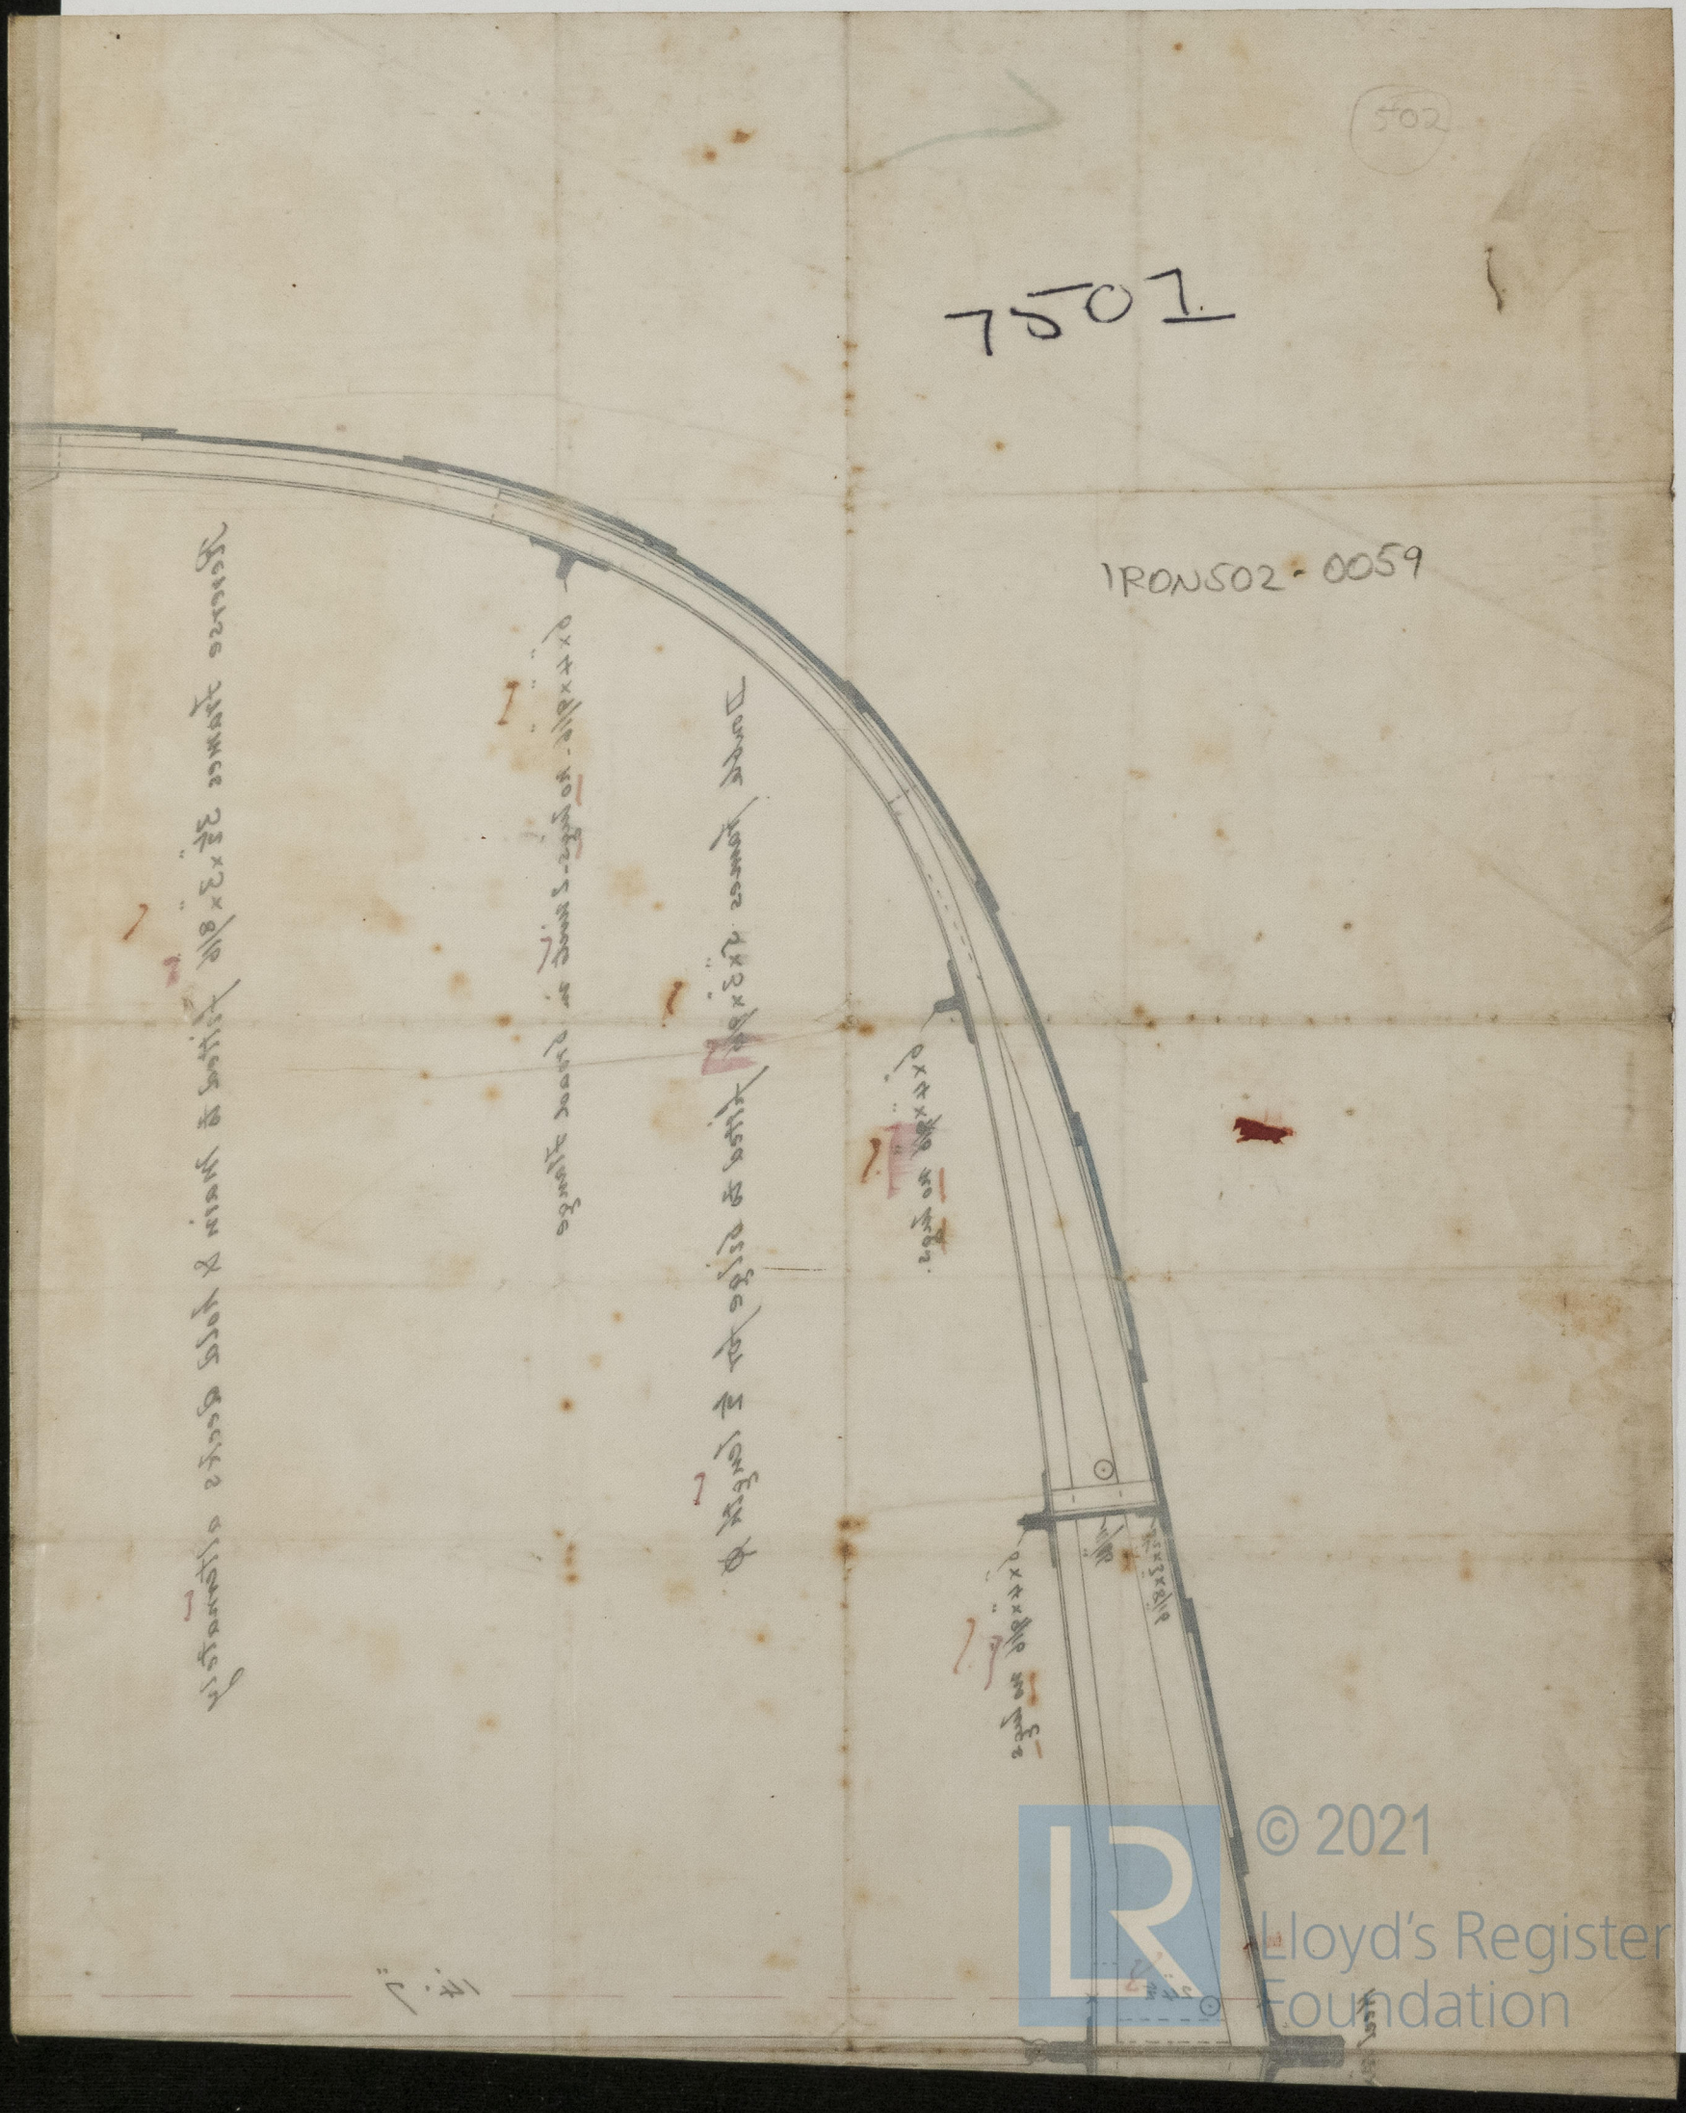

© 2021
Lloyd's Register
Foundation