

"Cingalese" 88759

No. 140 London & Glasgow Co. 9.1.69

"Cingalese"

# Principal Dimensions

Length of Keel and Fore Rake 185' 0"  
Breadth of Beam 32' 6"  
Depth in Hold 12' 3"  
Tonnage Gross 695 tons

Class

Special Survey

Building by the "London and Glasgow Co."

Recd 24/5/69 & 13/6/69

Again 18/6/69

15' 4"

6' 3" 1/2 on one side only  
8' 7/16 on every 2nd and 4th frame

Plating 5' 3" 1/2 x 7/16  
4' 3" 1/2 x 7/16

5' 3" 1/2 x 7/16  
4' 3" 1/2 x 7/16

4' 3" 1/2 x 7/16

4' 3" 1/2 x 7/16 at ends 21' 7/16

Frames 4' 3" 1/2 x 7/16 spaced 2' 1/2 apart and doubled in bottom to bilge

7' 2 3/4

Scale 1/2 Inch to one Foot

IRL  
21.5.69  
4.6.69

© 2021

Lloyd's Register  
Foundation

LRDN502-0077

This section is submitted that we may dispense with the inner deck stringer plate to suit the particular trade for which the ship is intended, in lieu of which we substitute an extra stringer of double angle iron 5' 3 1/2" and the upper edge stringer is made 5' 3 1/2" instead of 4' 3 1/2". The angle iron on inner deck beams is 6' 4" instead of 4' 3 1/2".

The outside plating to be double riveted in lap joints. The main deck stringer plate is made 3' 8 1/2" instead of 2' 7" for 1/2 length.

In lieu of ties on inner beams we substitute a built up 10' 4" x 1/2" running fore & aft in centre of beams.

The inner deck beams can only have an angle iron on one side which is made 6' 3 1/2" instead of double 3' 3 1/2".

Please forward the section to your Committee and return as early as possible.

Sheer strake 1/16 for 1/4 length, thence to ends 10/16 and 9/16

Double Riveting

8' 1/16 for 1/2 length at ends 7/16

Single Riveting  
Double Riveting


Proposed  
height of double  
frames



7588

Iron Bk "bingalese"

Iron & report No 7588

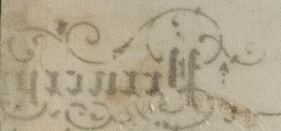








IRON 502 - 0077

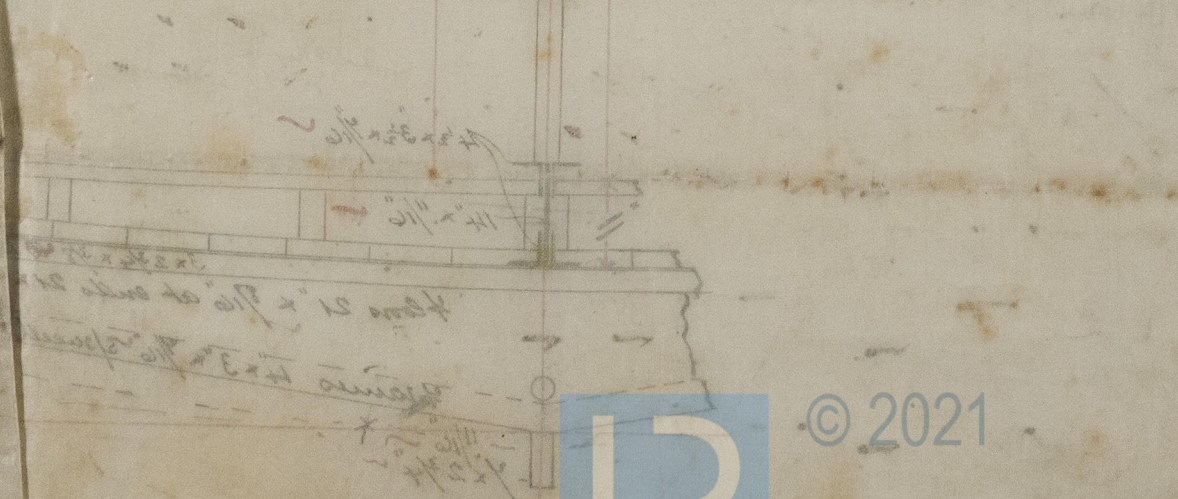

© 2021  
Lloyd's Register  
Foundation