


Screw Steamer "Fitz-Rand"

Midships Section of No. 100 S.S.  
Length Keel & Fore rake 225' 0"  
Breadth Moulded 29' 0"  
Depth of Hold 17' 6"  
Tonnage under deck 757 tons  
" Grass - - 830 tons.  
Lo Class A1

Blackwood & Gordon  
Castle Building Yard  
Port Glasgow  
22/1/58

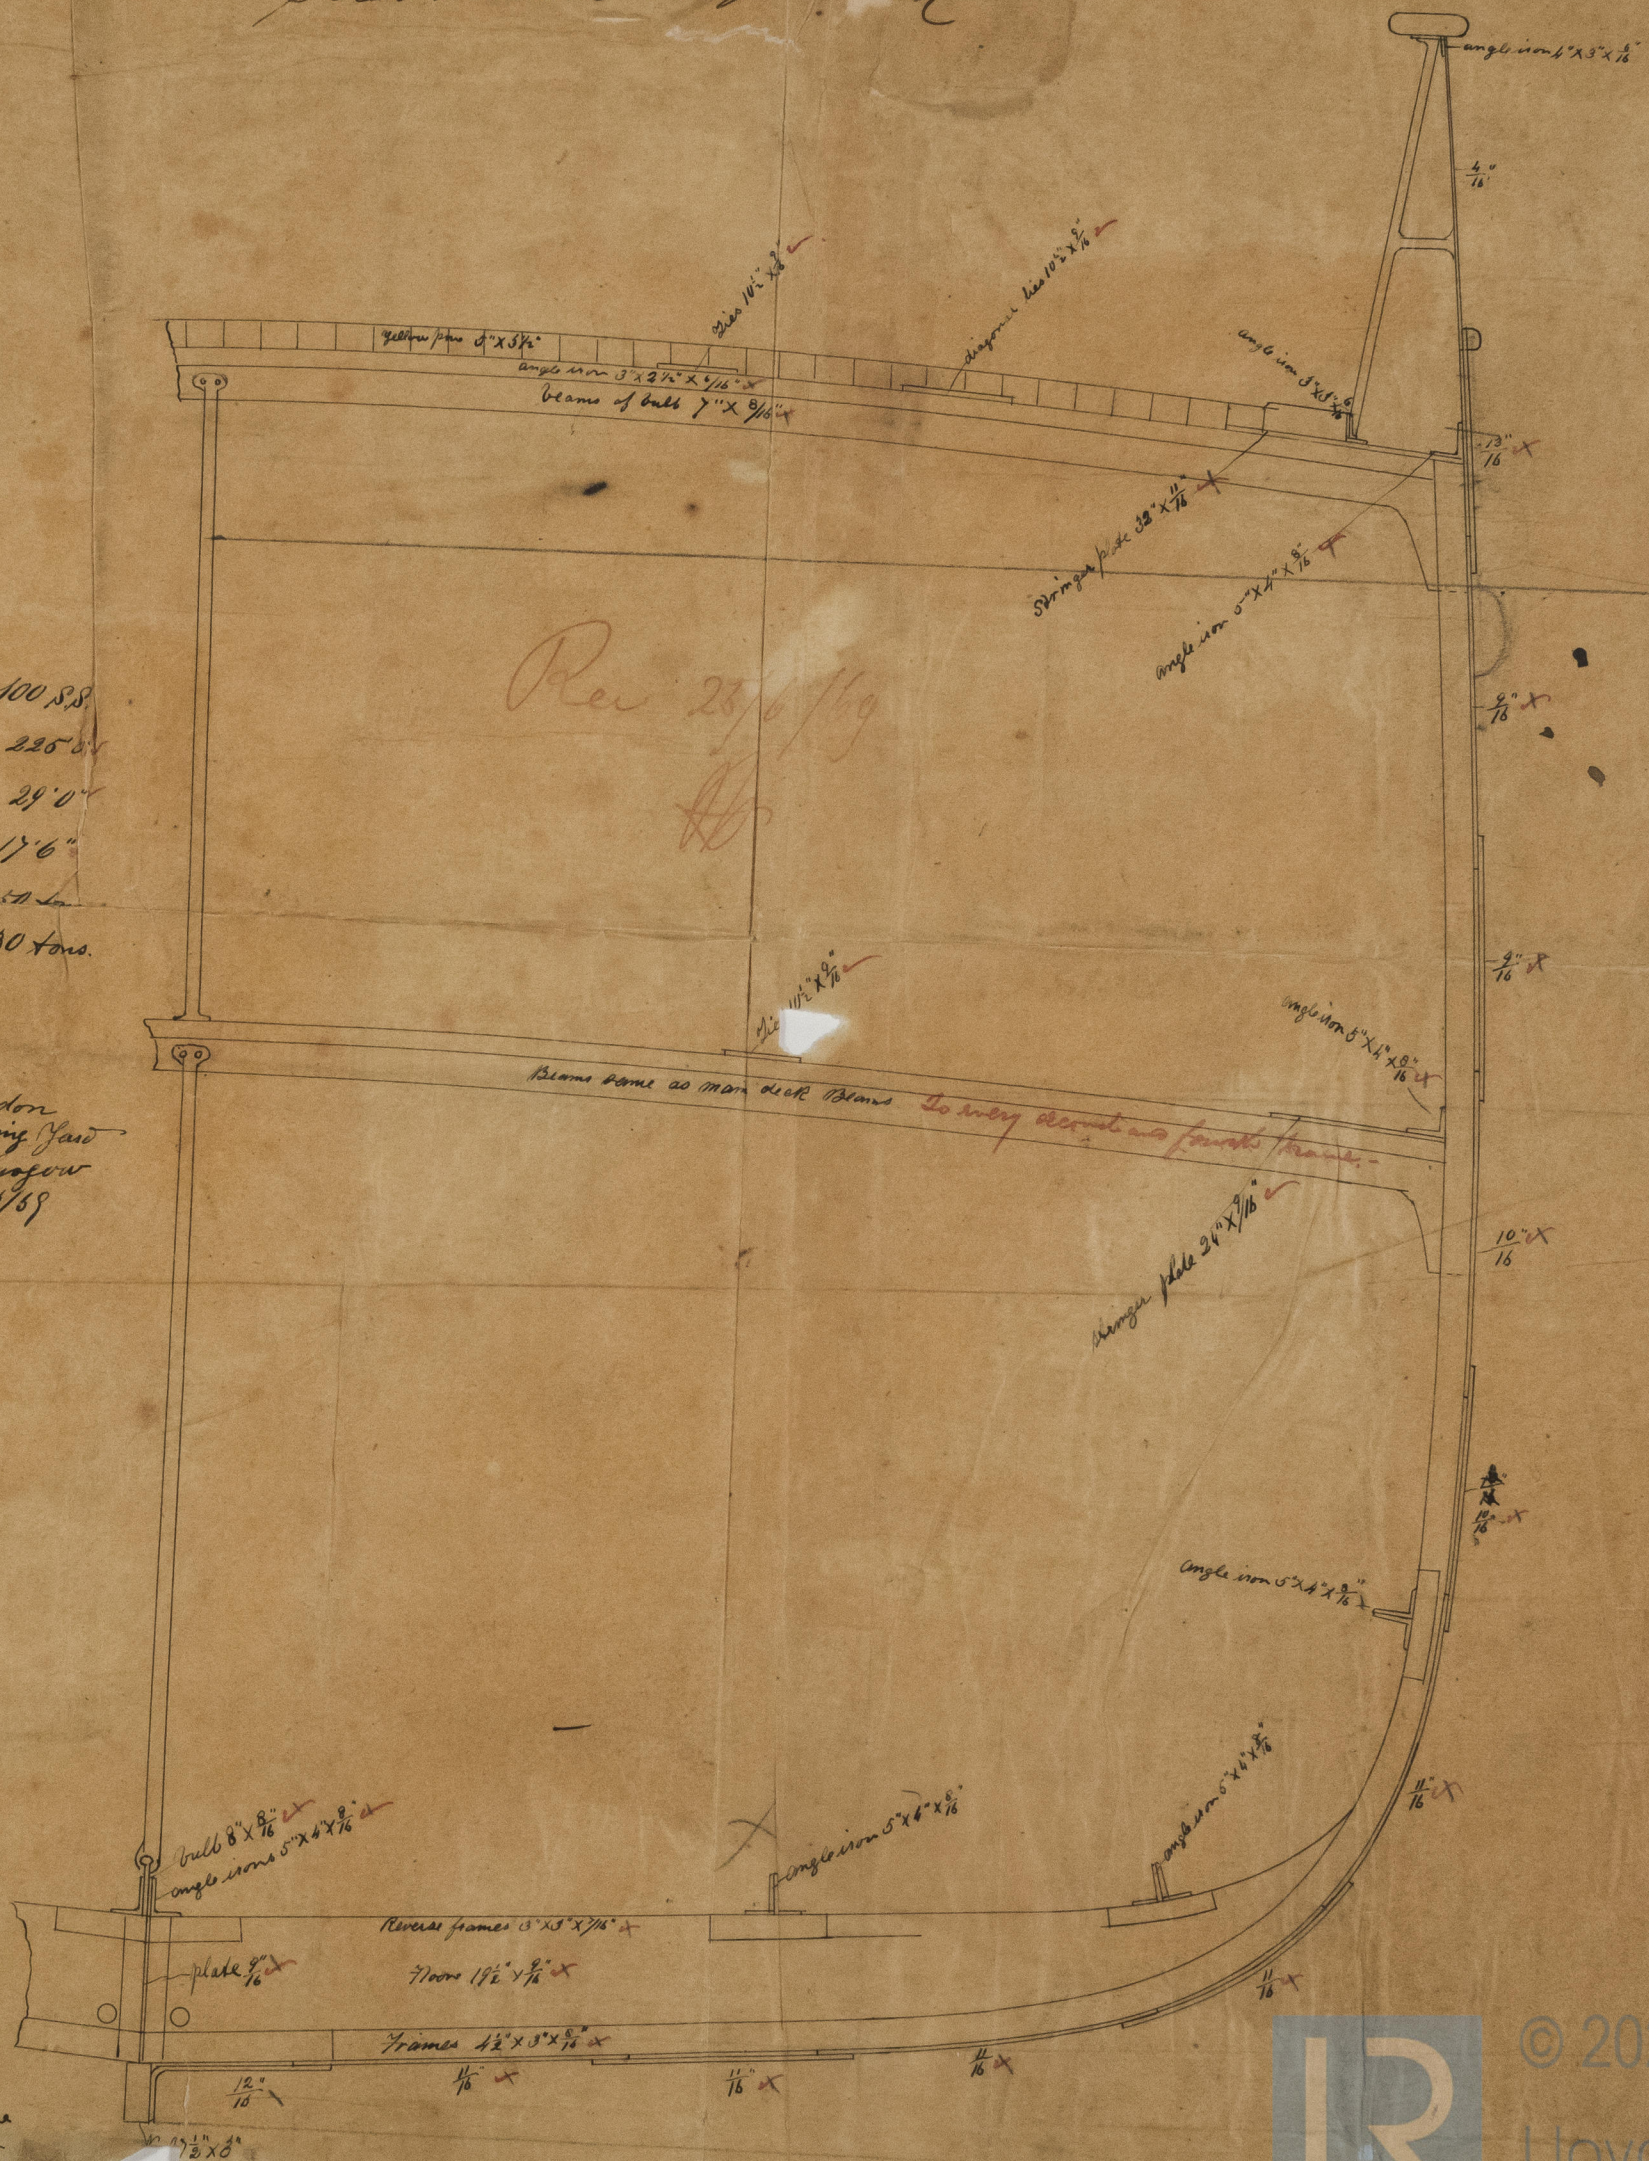

5/2/70

Wm. Alpina

IRON 502-0080