

Midship Section for S.S. Walter Stanhope.

Built by A. J. Inglis, Glasgow in 1883.


Present Tonnage

Tonnage under deck 375
Gross — 386
Engine Room 116.74

Estimated new Tonnage under deck about 535 tons

Present Dimensions Length 188.9
Breadth 26.2
Depth 12.25

Per 8/7/69
H

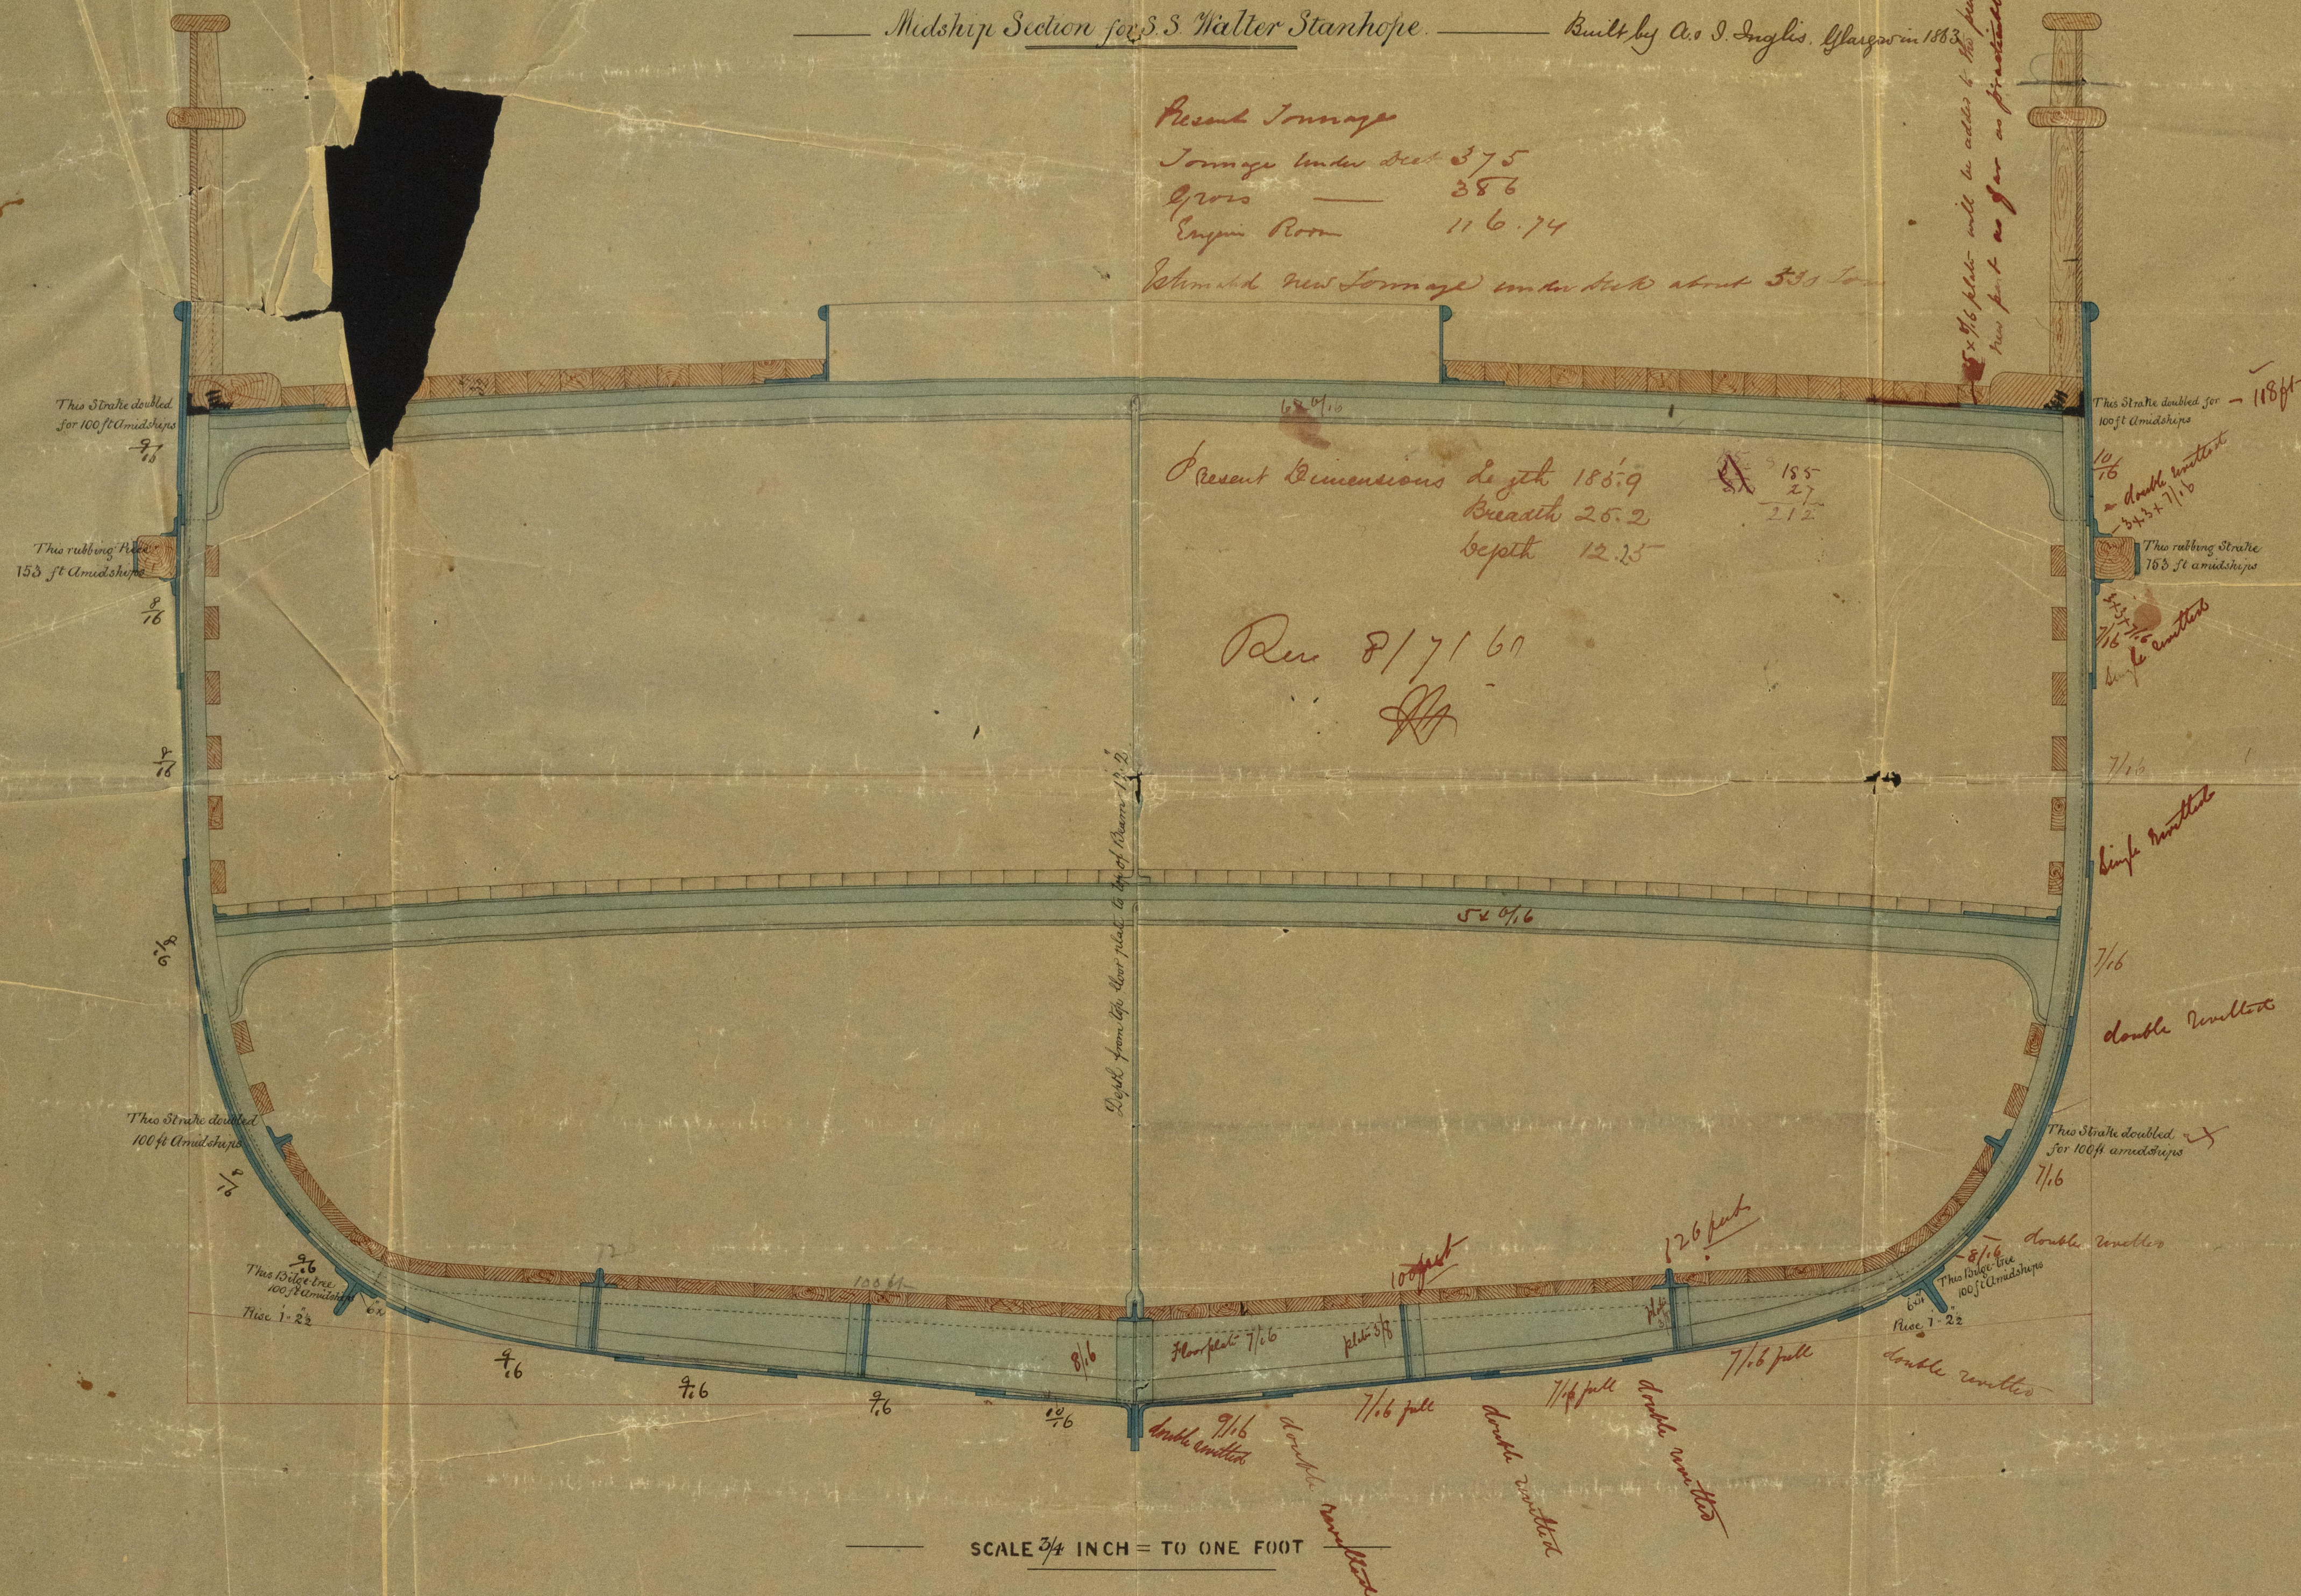

Dimensions	
Length Between Per's	270' 0"
Do Keel	25' 1"
Breadth extreme	25' 1"
Depth Moulded	12' 10"
Tonnage D.M.	648 25/64
Builders Measurement	8.7.69

Plating	
Fore and Aft Strake	10/16
to upper part of Bridge Strake	9/16
Upper part of Bridge Strake to Sheer Strake	8/16
Sheer Strake	9/16