

S.S. "Viceroy"


Recd. 4/10/16
lengthened dimensions

Present dimensions
from Customs Register

length 220.2
Beam 29.35
Depth 16.95
Tonnage under deck 753.72
Poop 68.84
Excess of Tonnage 47
Gross 823.03

increase
estimate 154.8
" 75.
Estimated gross 1052.83

17.2 to top of floor
908.52
143.84 Extra length of poop
to cover Engine etc

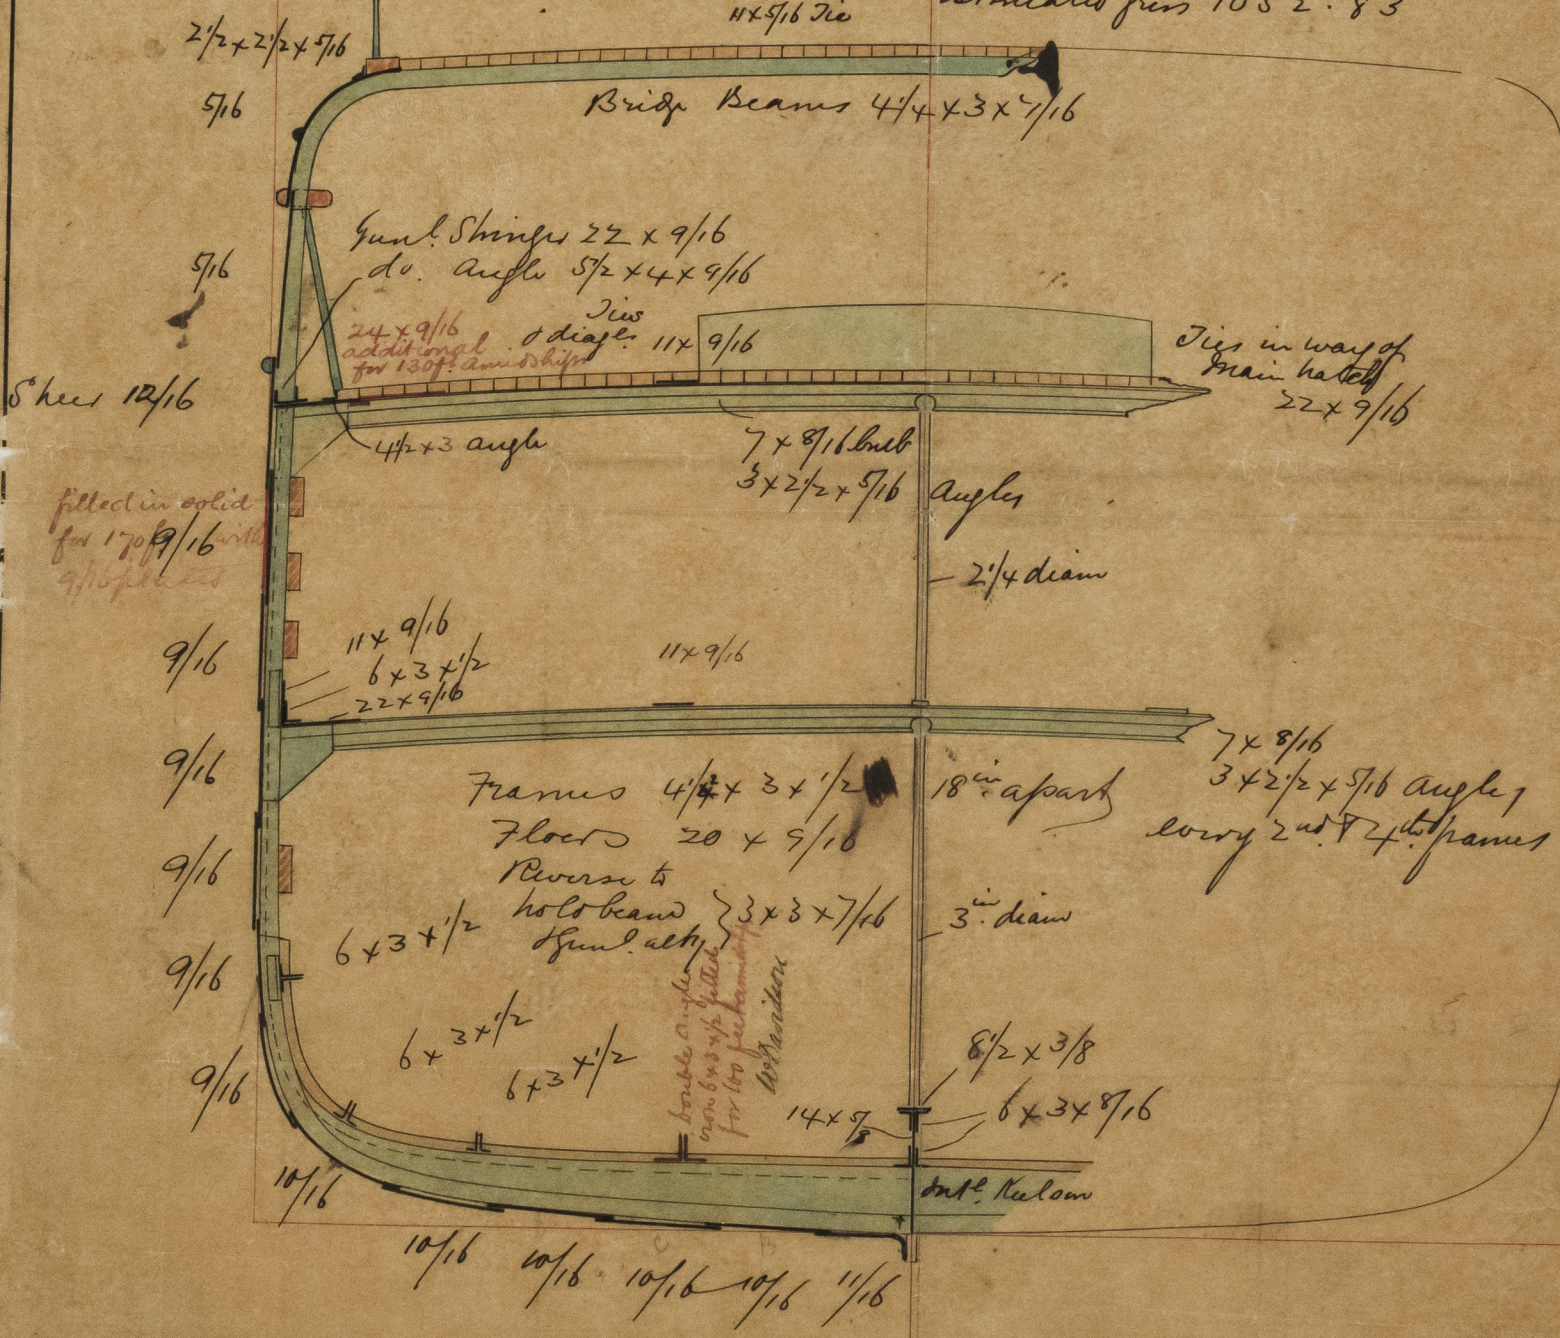

all. cutting of edges & Butts of plates and strings carried out as found in the record - with the exception of the Butts of plates and strings plates when forming the old part which have in the bottom



© 2021

Lloyd's Register
Foundation

IRON 502-0108