


	Length	283.00	
	Breadth	34.75	
	Depth	17.90	
	Do to Spar	25.30	
Yours under	Tonnage Deck	1251.60	
— " —	Propelling Spar	330.14	
— " —	Spar Deck	574.84	
— " —	House for Crew	12.09	
— " —	Under Bridge	17.26	
	Total	1855.79	

S. S. "Dacia" $\frac{1163}{1517}$ tons
 Long 243.4 x 34.7 x 17.7

Is lengthened 40 ft, making tonnage equal 12.50 tons under main D.R.
and causes her Length to exceed Breadths, and Fifteen depths

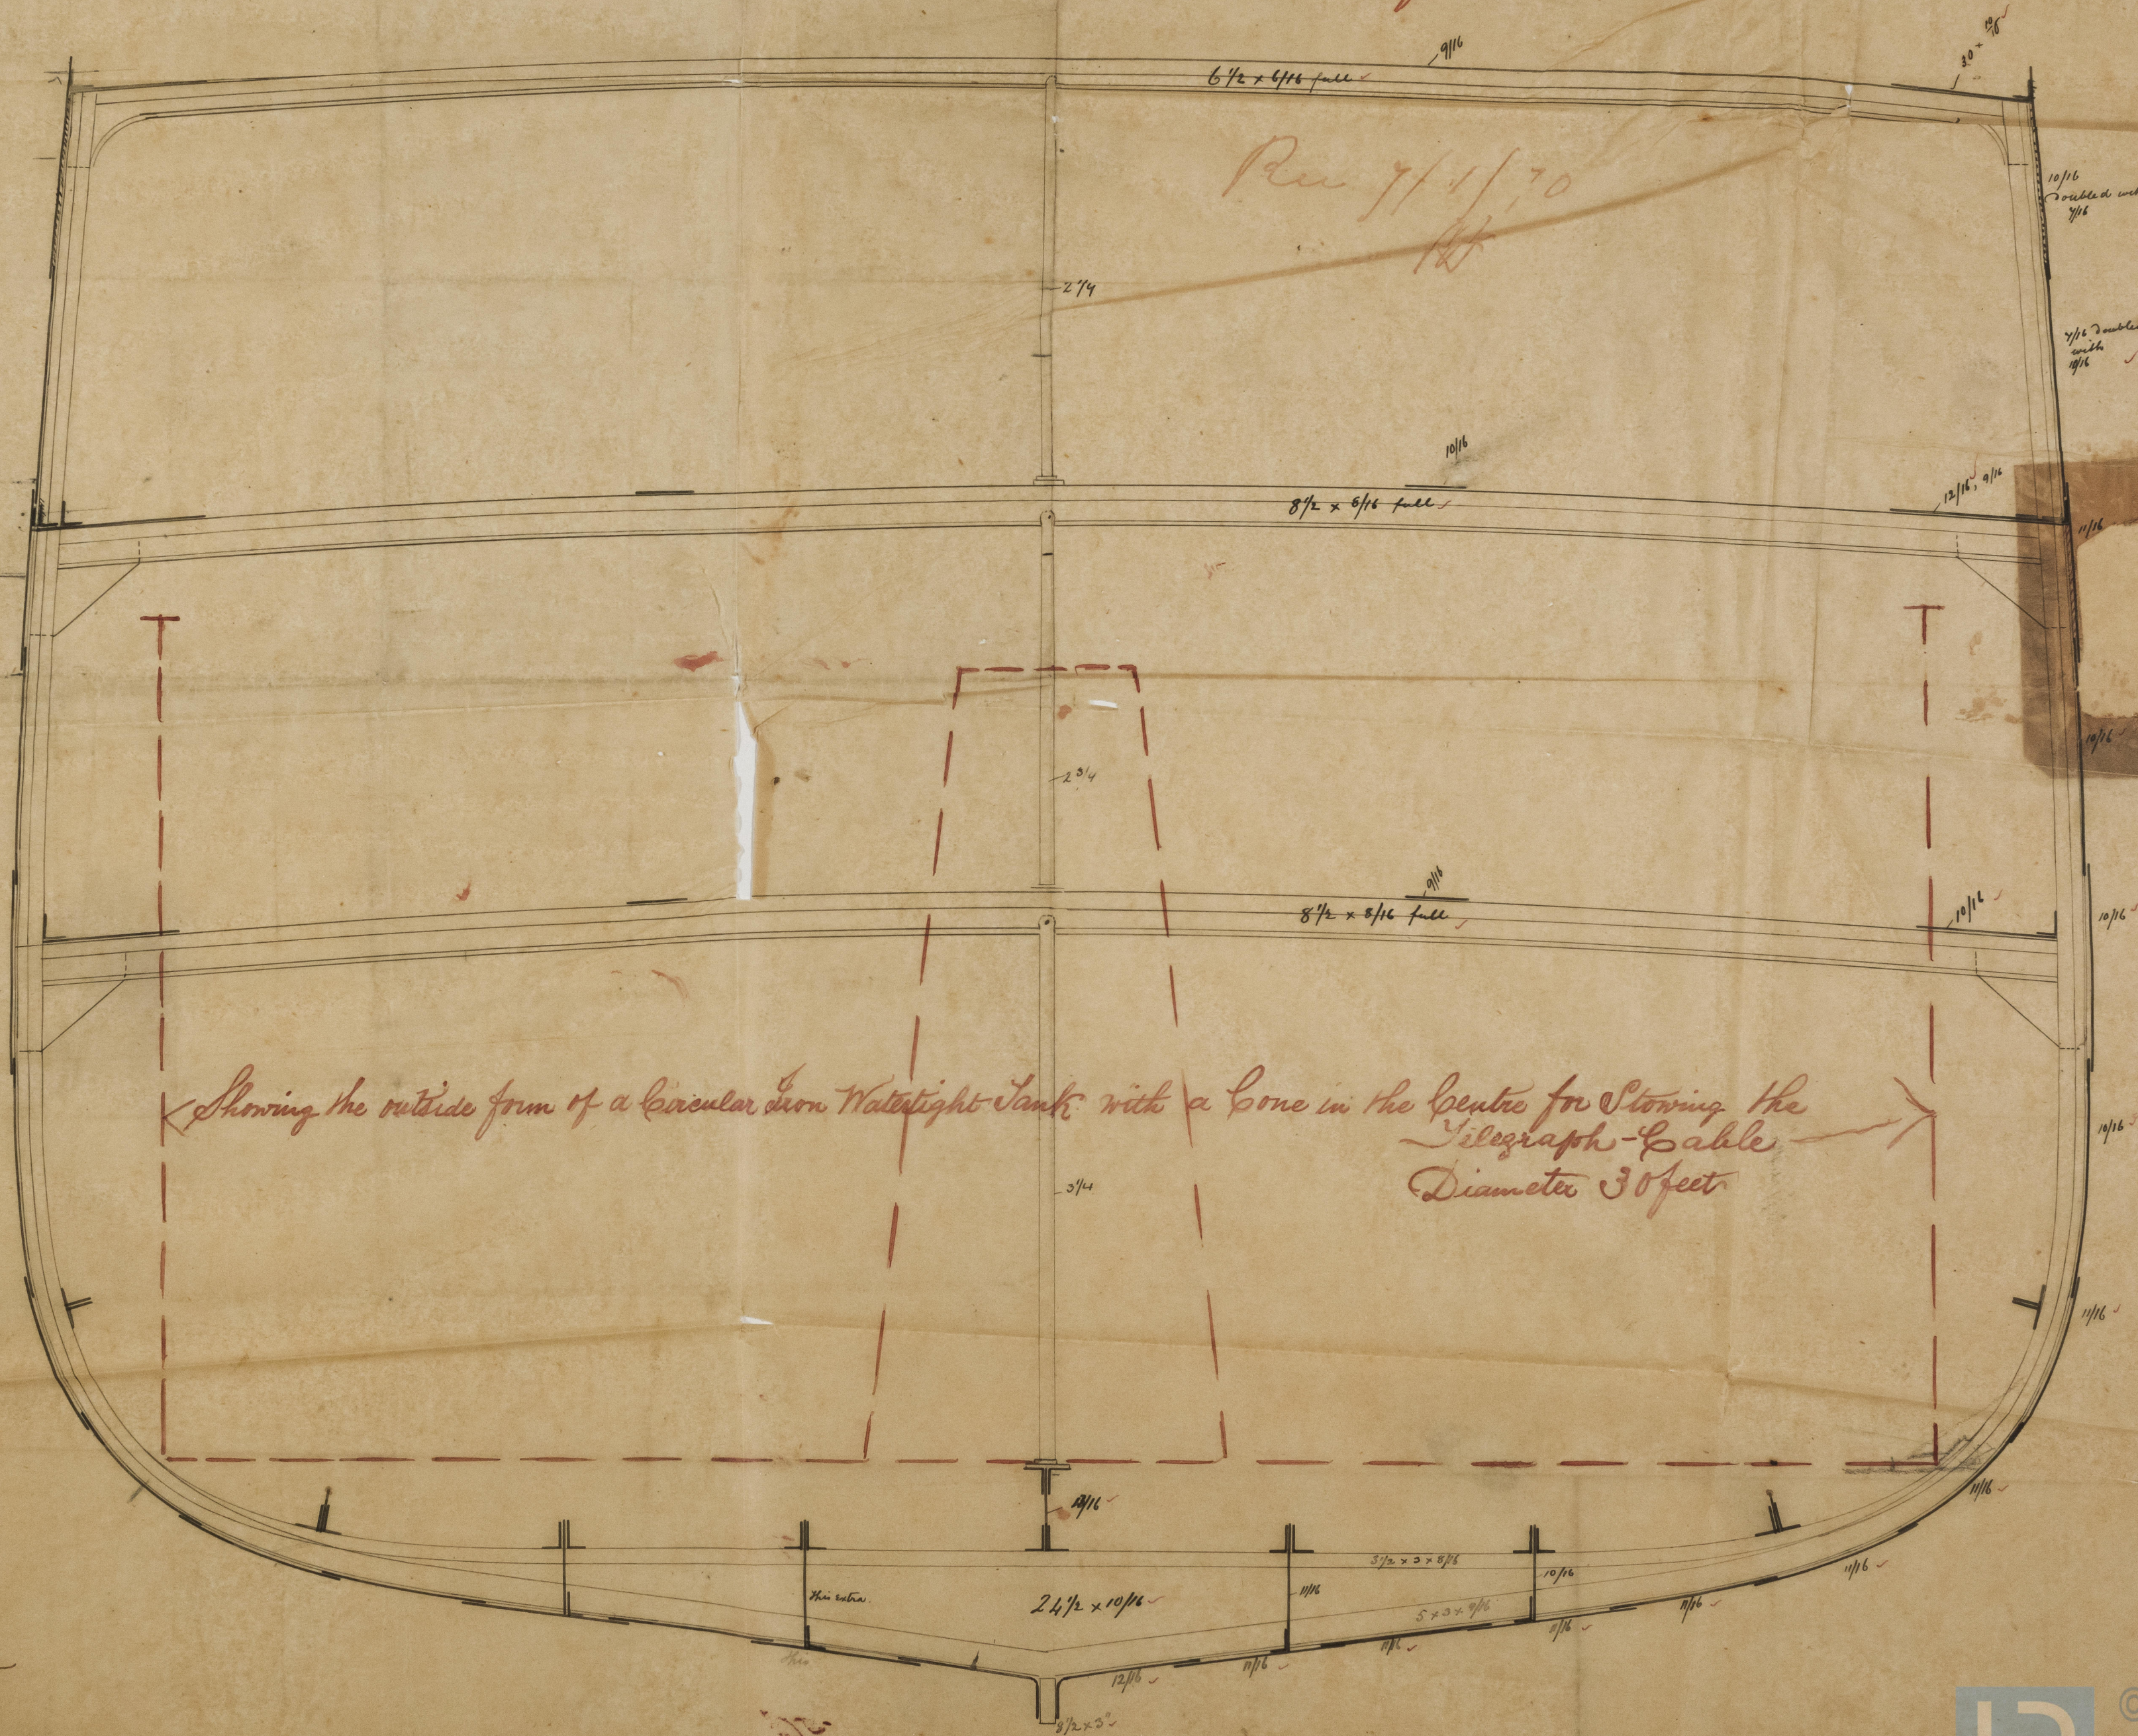

Scale $\frac{1}{2}$ = 1 foot.