

# MIDSHIP SECTION

— OF —

Nº 96 S S

"Menzaleh" Length 47 feet  
Additional strengthening shown in red.

SCALE 1/2 INCH TO THE FOOT

Dimensions 232 x 33 x 24.9 half deck


Proposed dimensions 279 x 33 x 24.9

Numbers

$\frac{1}{2} \times 7 = 38.9$   
 $\frac{1}{2} \times 18 = 16.5$   
 $8 = 19.9 = 26.9 - 7.0$   
 $75.3 \times 277 = 20858$

Half of dunnage breadth  
under 10 depths

Ex class 90. "Three deck" *Handwritten signature*

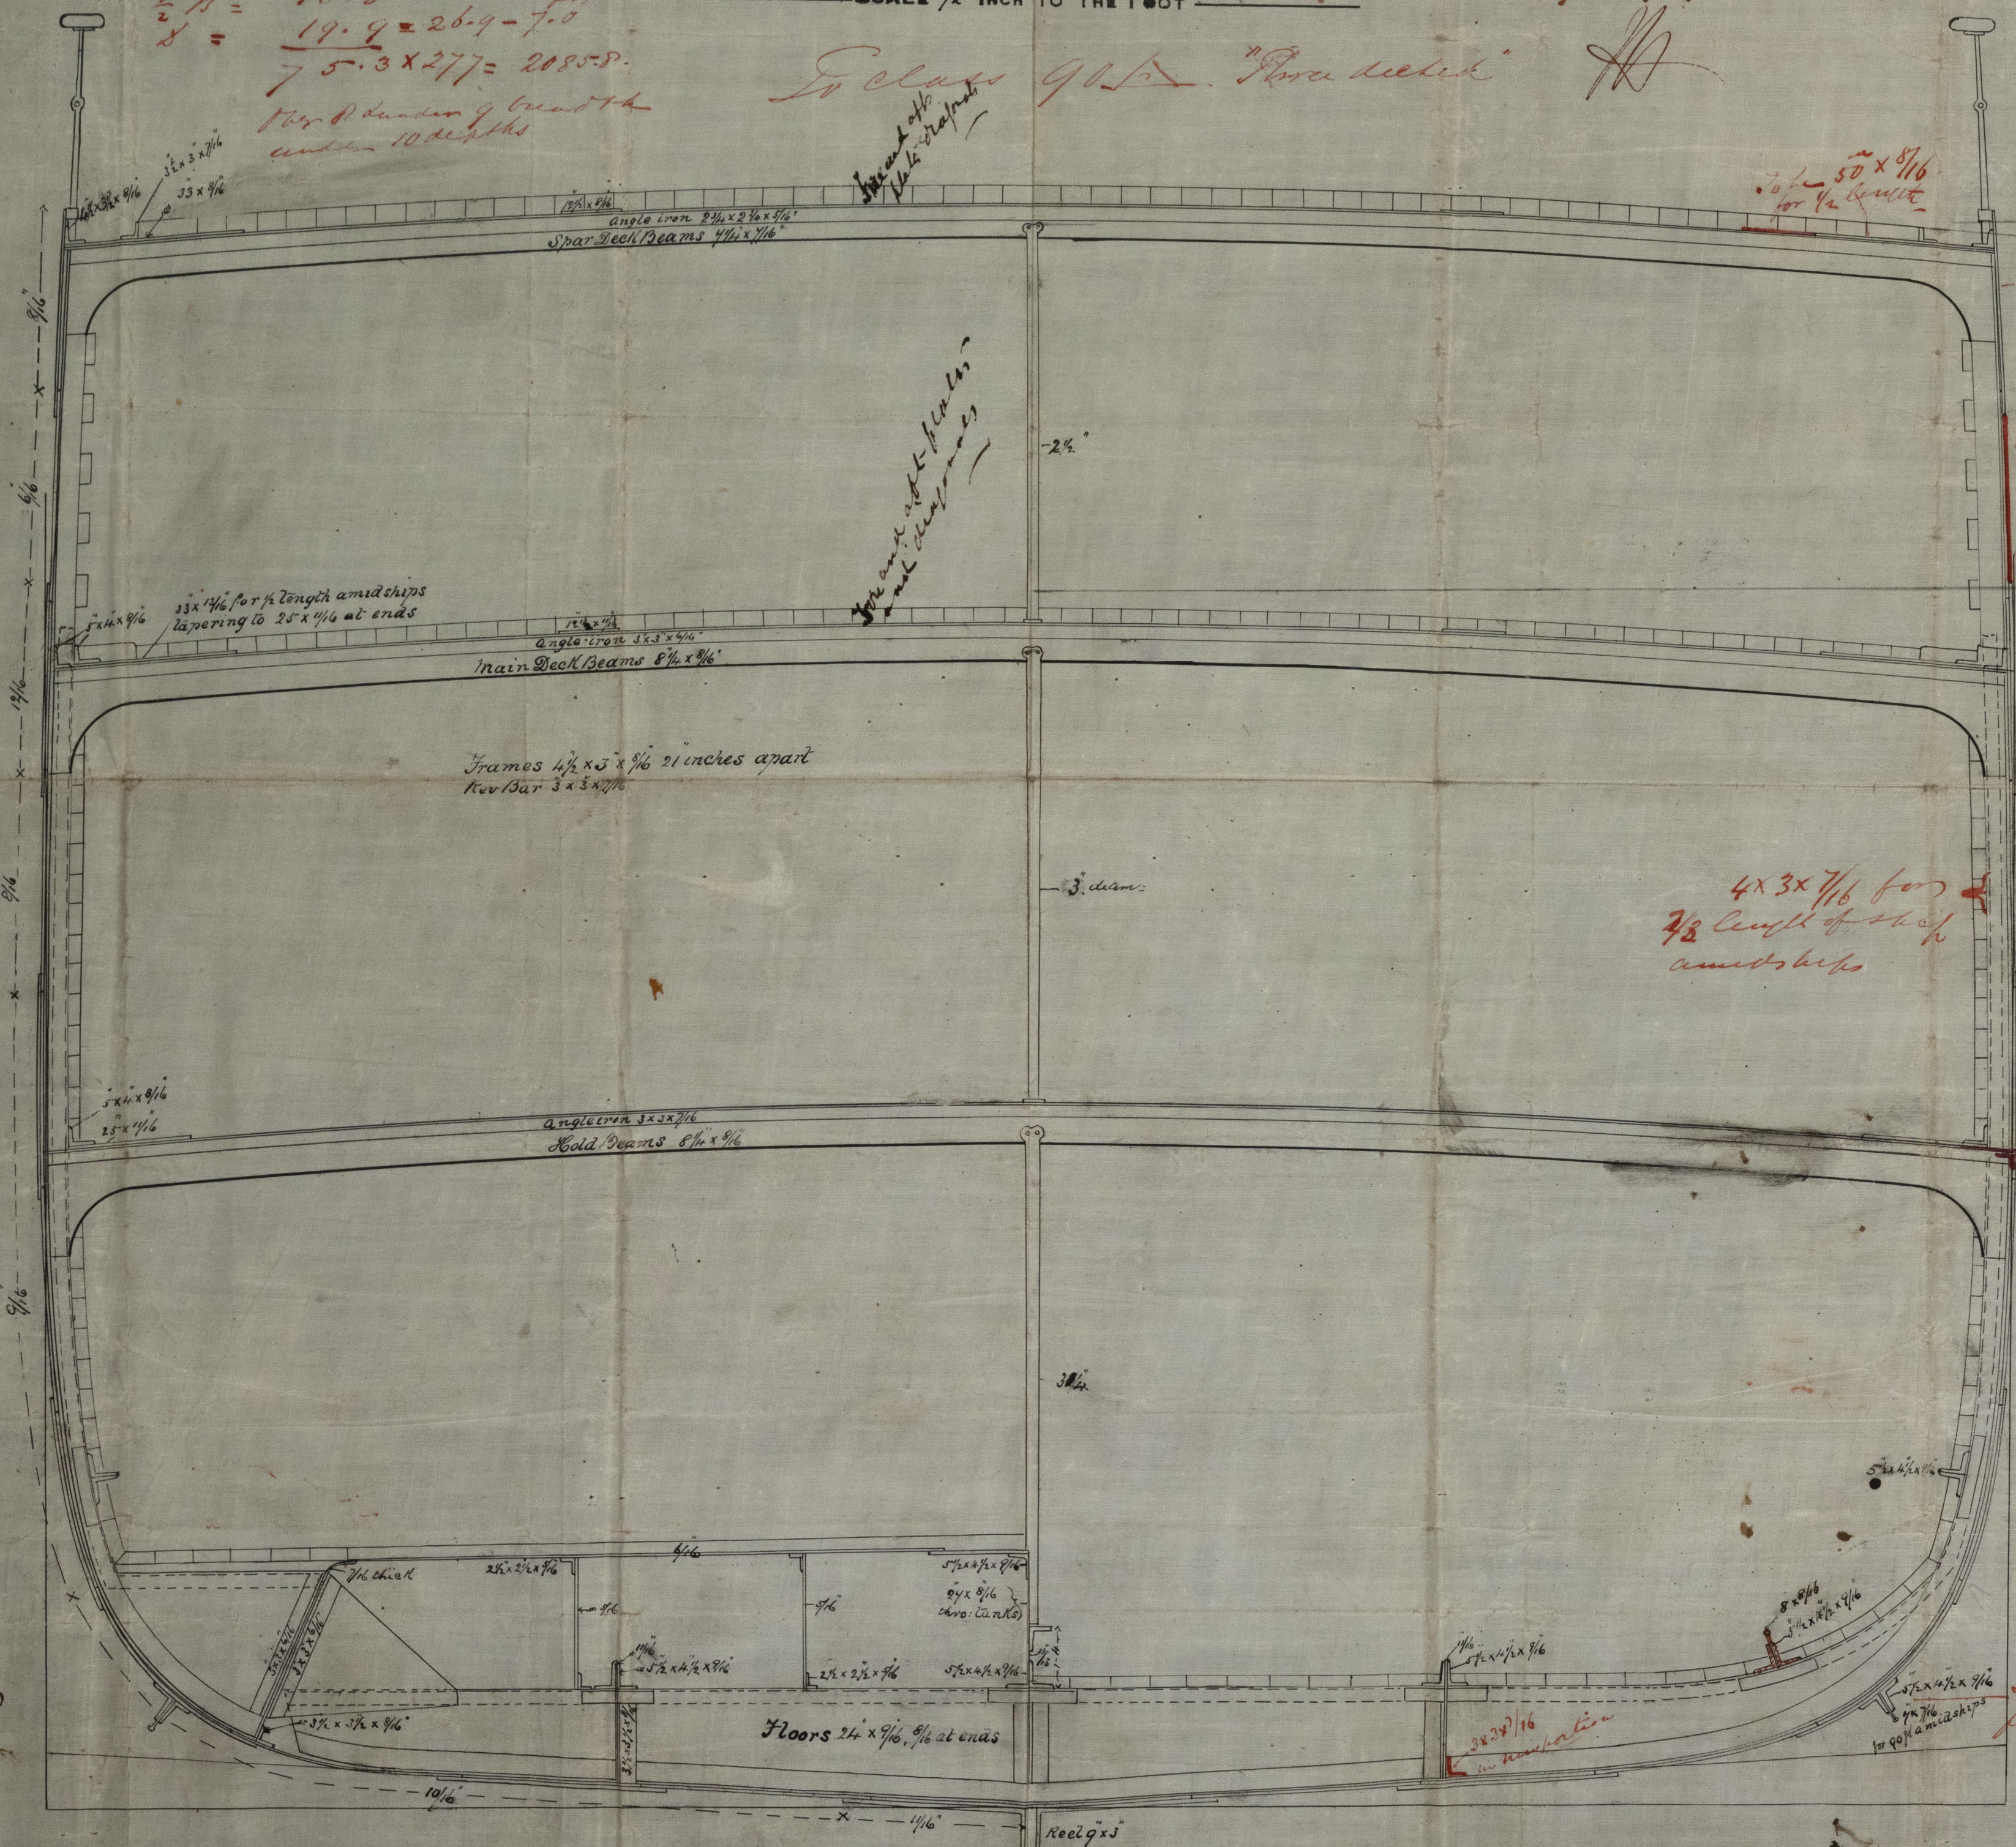

Sheer strake 10" 9/16 in new portion

Doubled with plate 10/16 thick for 3/8 length of ship amidships

4 x 3 x 7/16 for 7/8 length of ship amidships

Attached bracing plates for 1/2 length

To extend over 137 feet amidships

Floors 2 1/2 x 9/16, 9/16 at ends

Keel 9 x 5

11/9/71








5	252
125	
125	
875	



© 2021

Lloyd's Register  
Foundation