

Trn 7991

— OF —


N^o 96 S.S

SCALE $\frac{1}{2}$ INCH TO THE FOOT

Disbursements
 English Do. 232-0
 Rents 33-0
 Repairs of Vols. 24-9
 Claret St. a. Lloyd
 Off. 500 x 1200. 2m grade

Hoar Sack

Above 4 breaths & within 12 depths
from

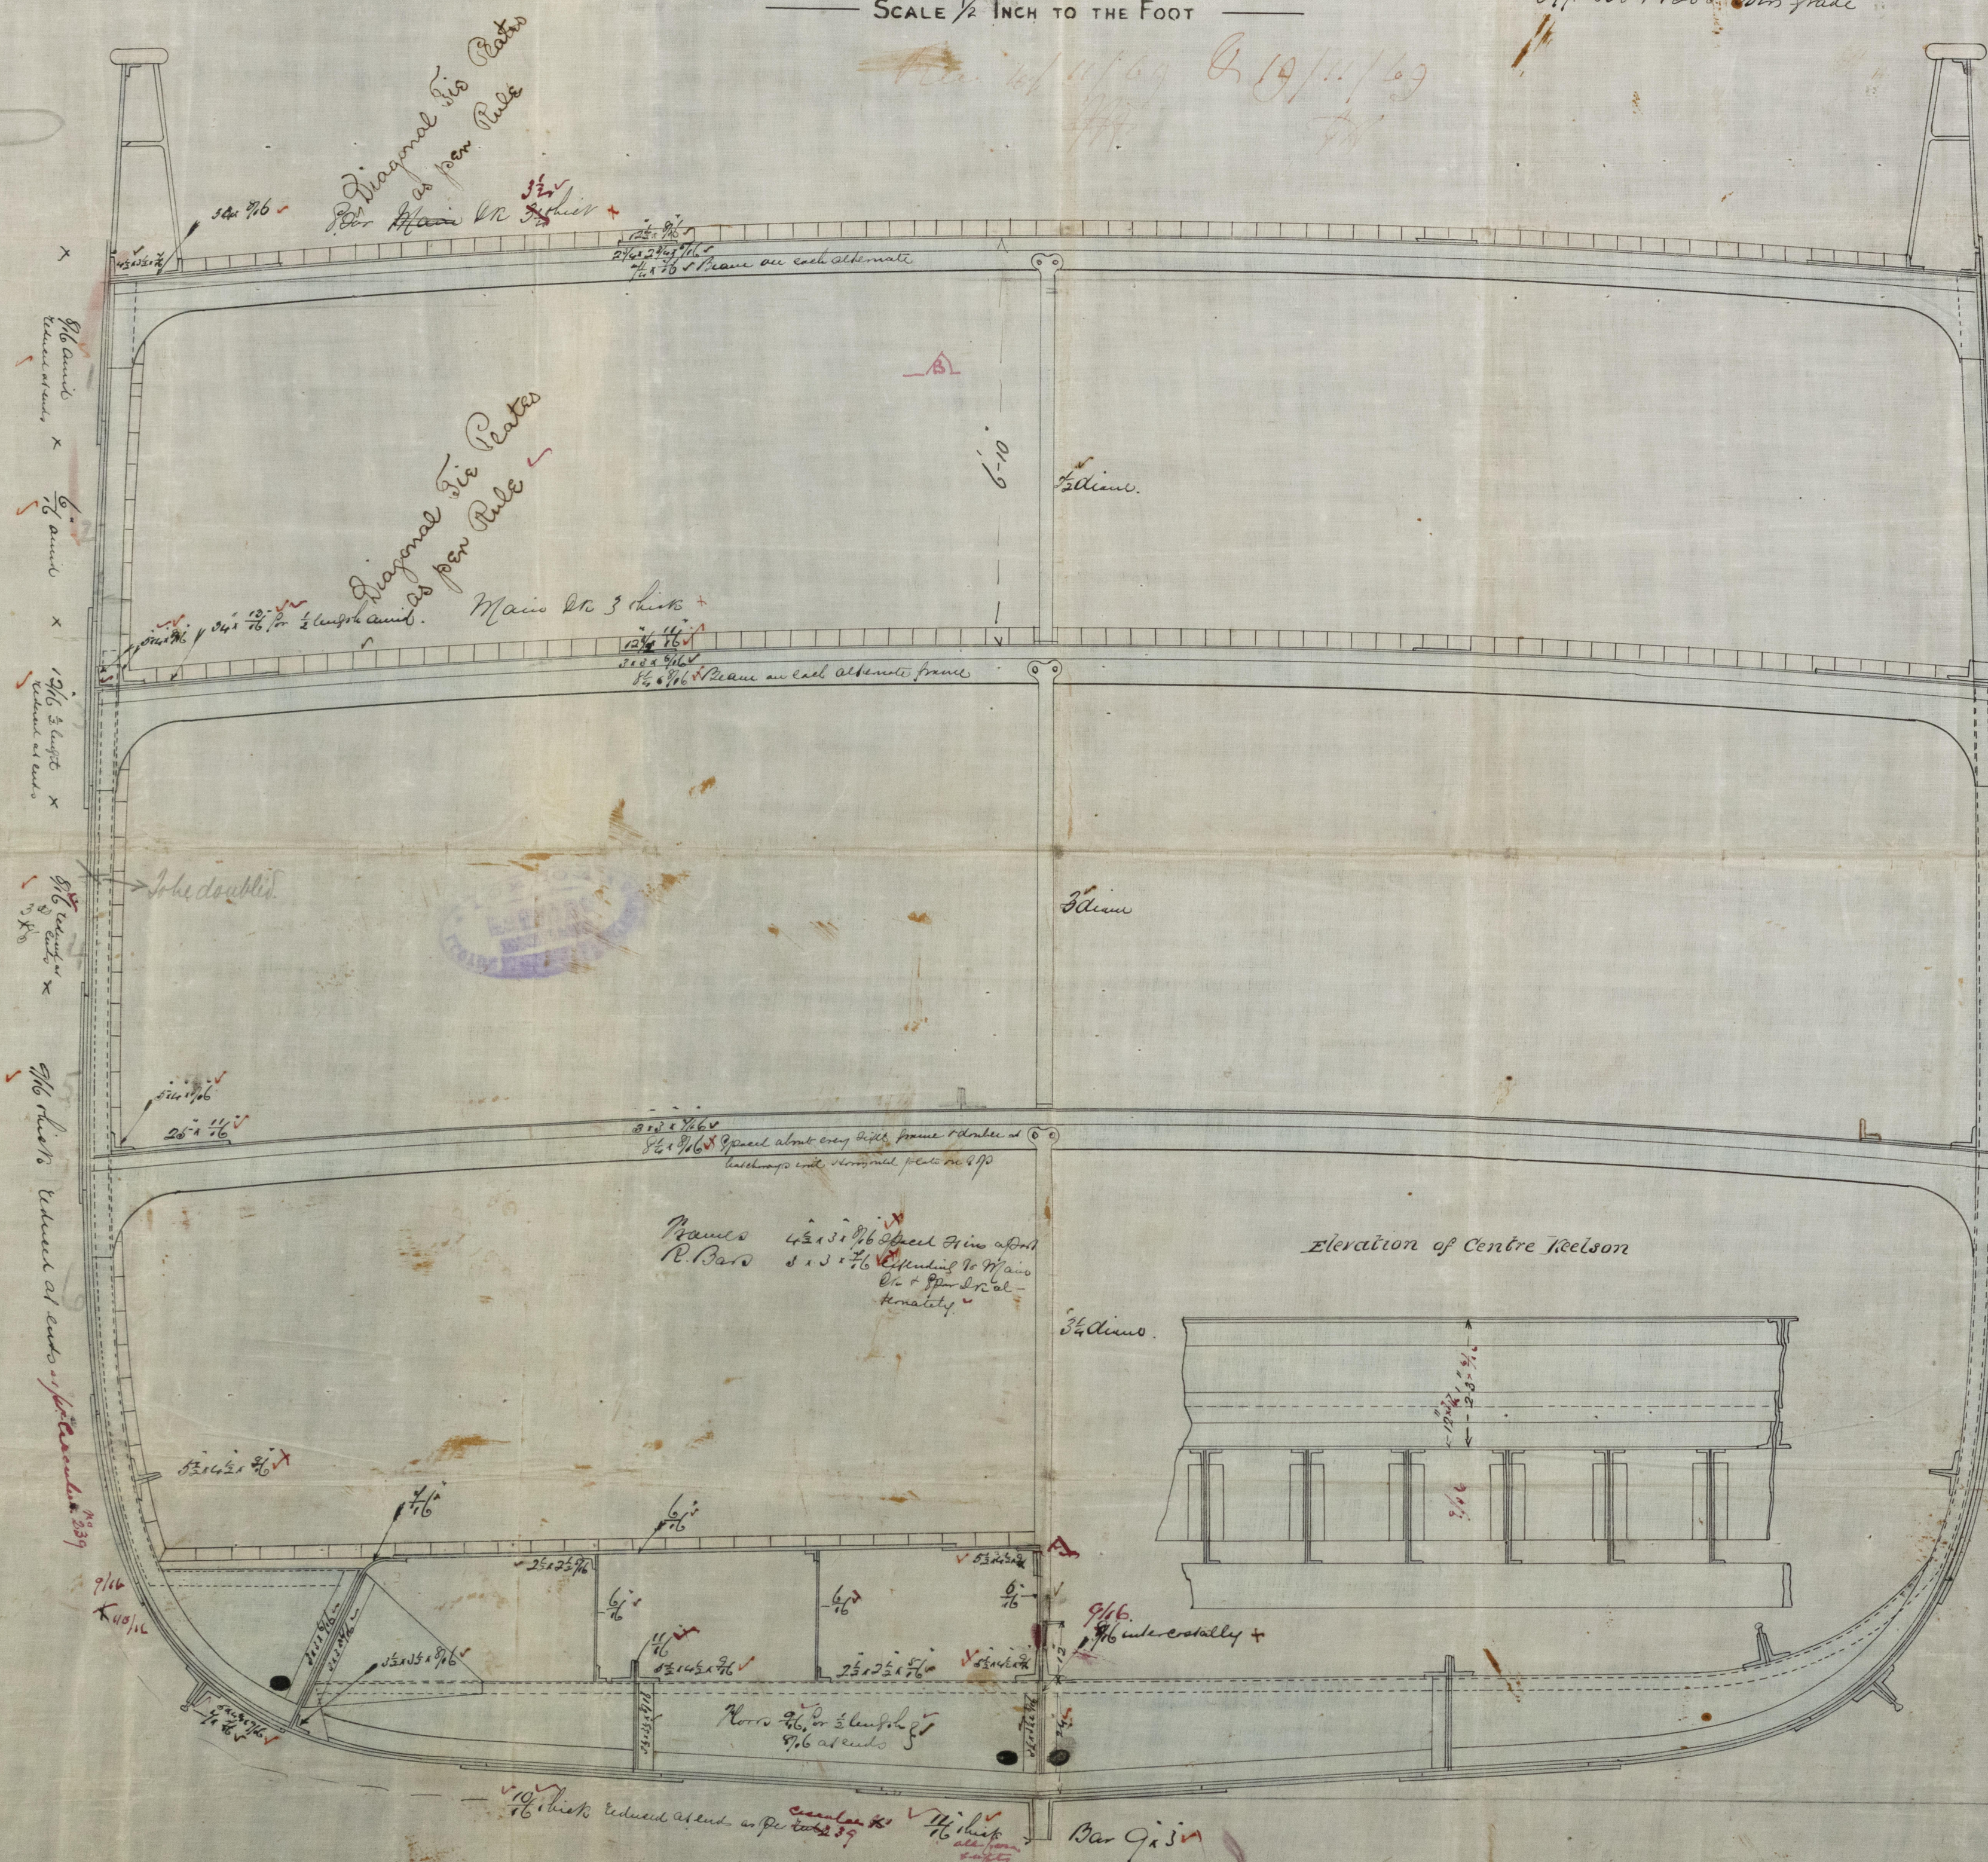

J. H. R.
9.11.69

MIDSHIP



LLOYD'S REGISTER OF SHIPS
RECEIVED
6 JUN 96
LONDON



© 2021
Lloyd's Register
Foundation