

MIDSHIP SECTION

of

171

DIMENSIONS

Length twixt Perpendiculars — 170 — 0 —
 Breadth Extreme — — — 24 — 4 —
 Depth in Hold — — — 13 — 5 —

5.7 Breadth
 12.5 Depth


Rev 26/11/69

Rev 14/3/70

Tonnage Under Deck 296

1 class

B

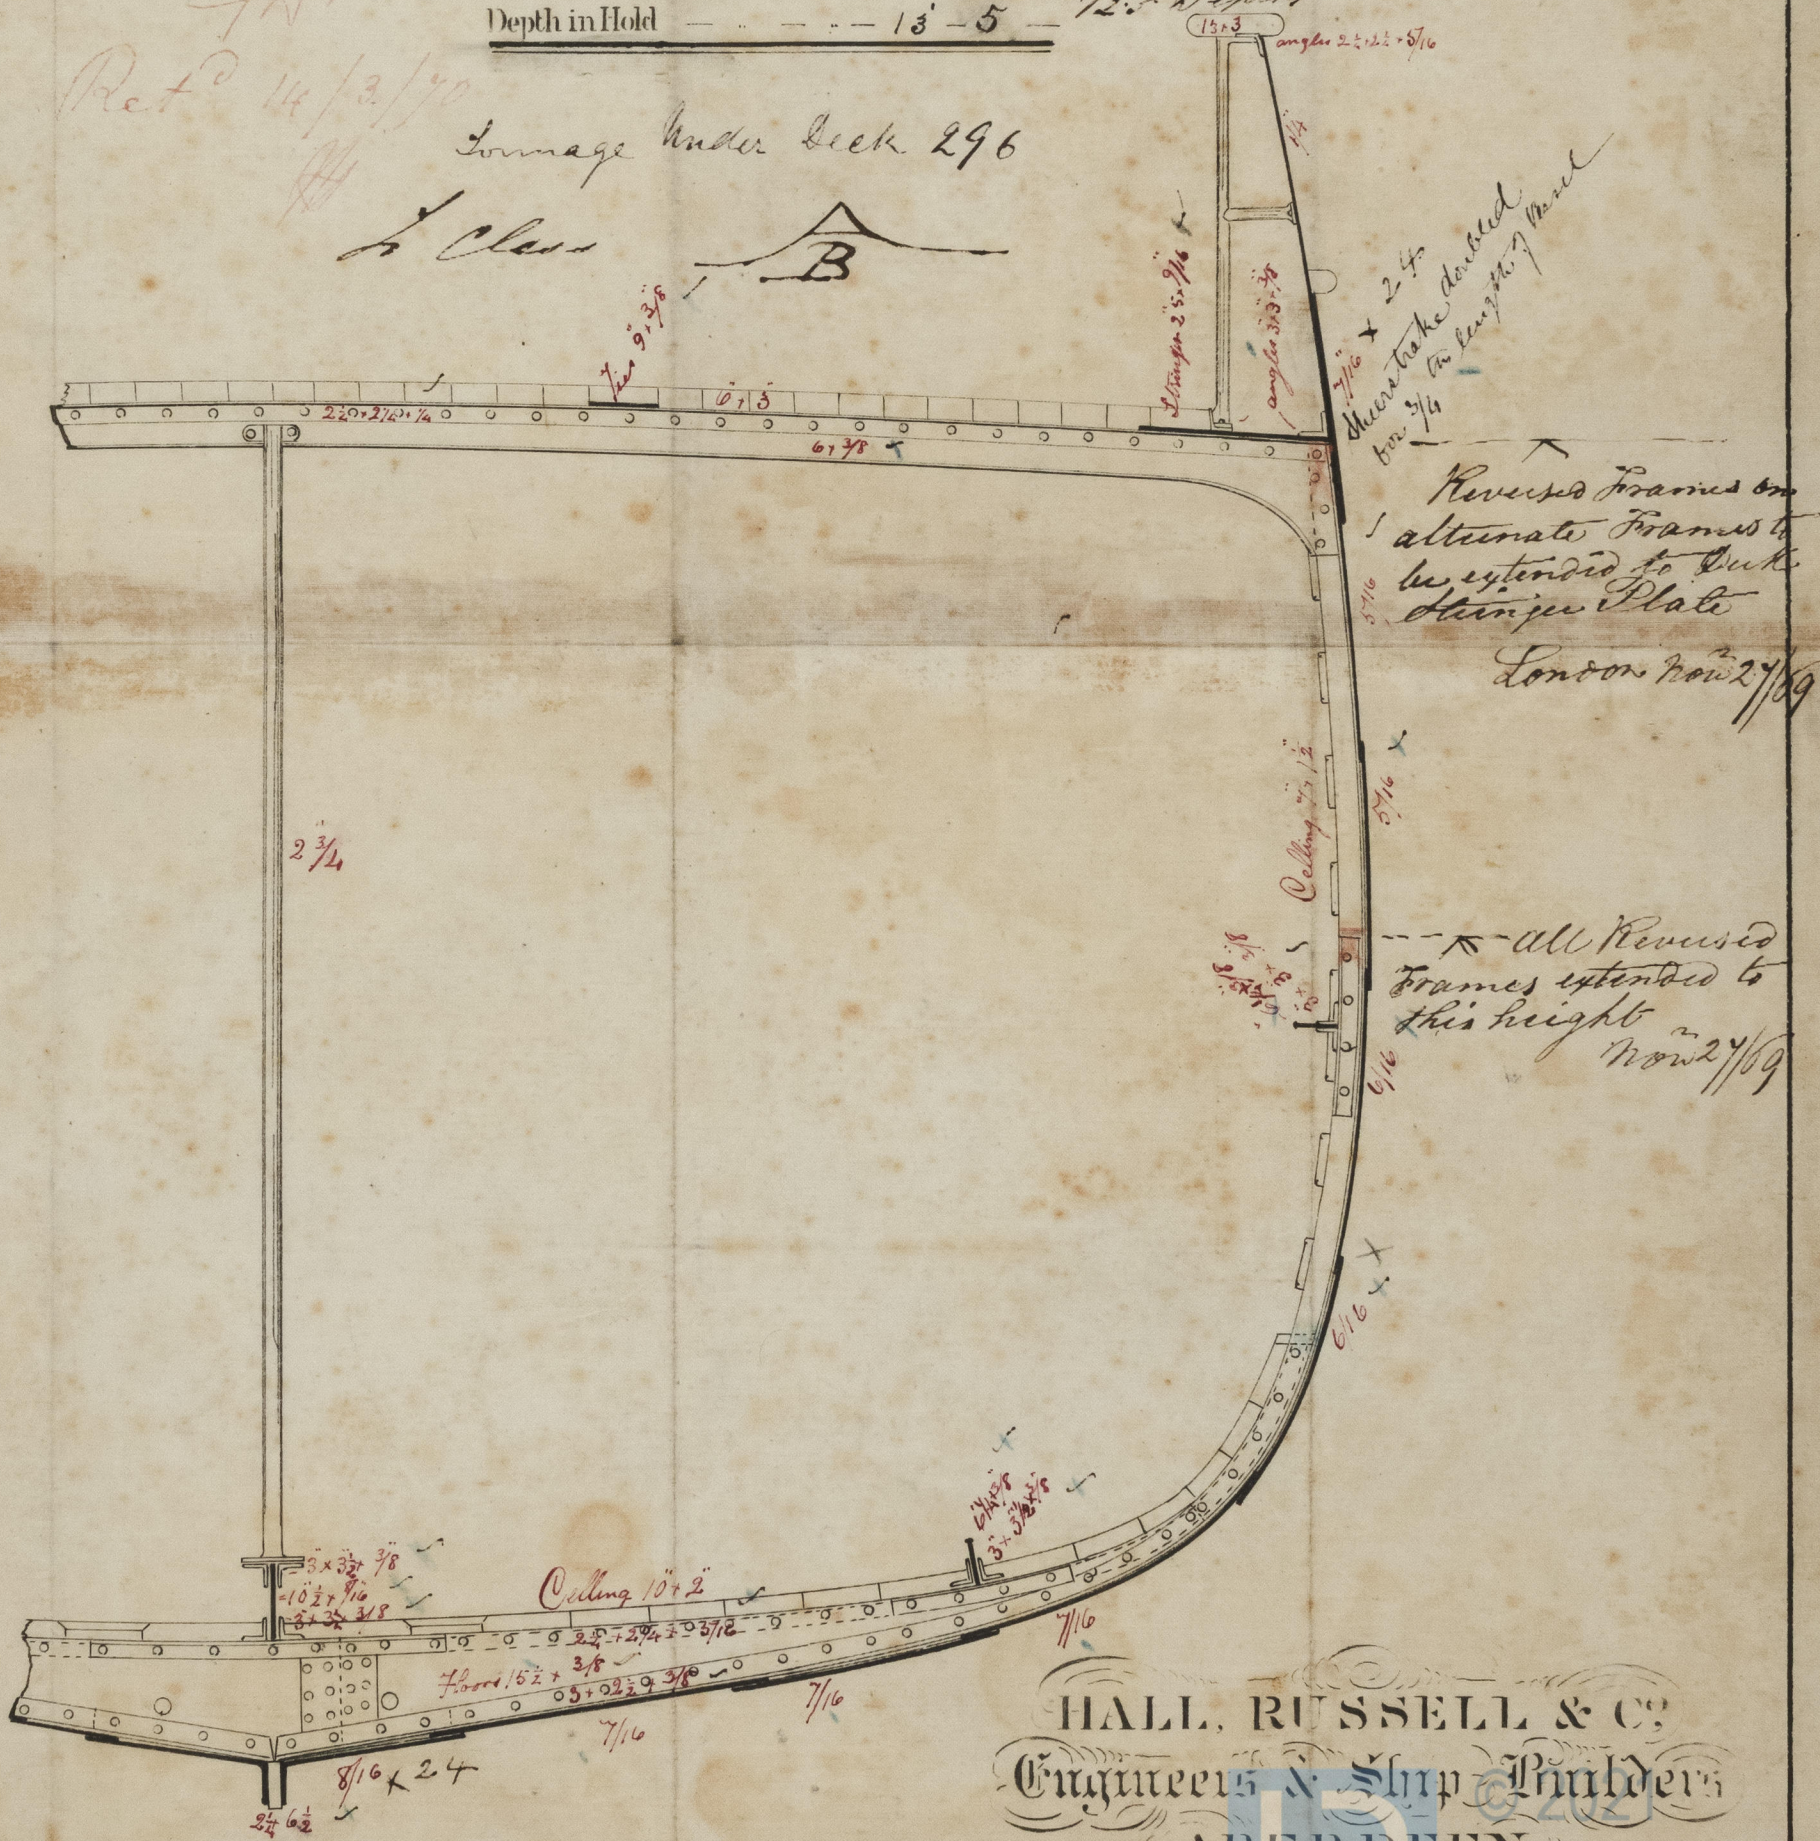

Scale 1/2 Inch to a Foot

HALL, RUSSELL & CO
 Engineers & Ship Builders
 ABERDEEN

IRON 502-0225

Lloyd's Register
 Foundation