


Frames made by carried to
 this kind
 and overlapping
 left on
 ing.

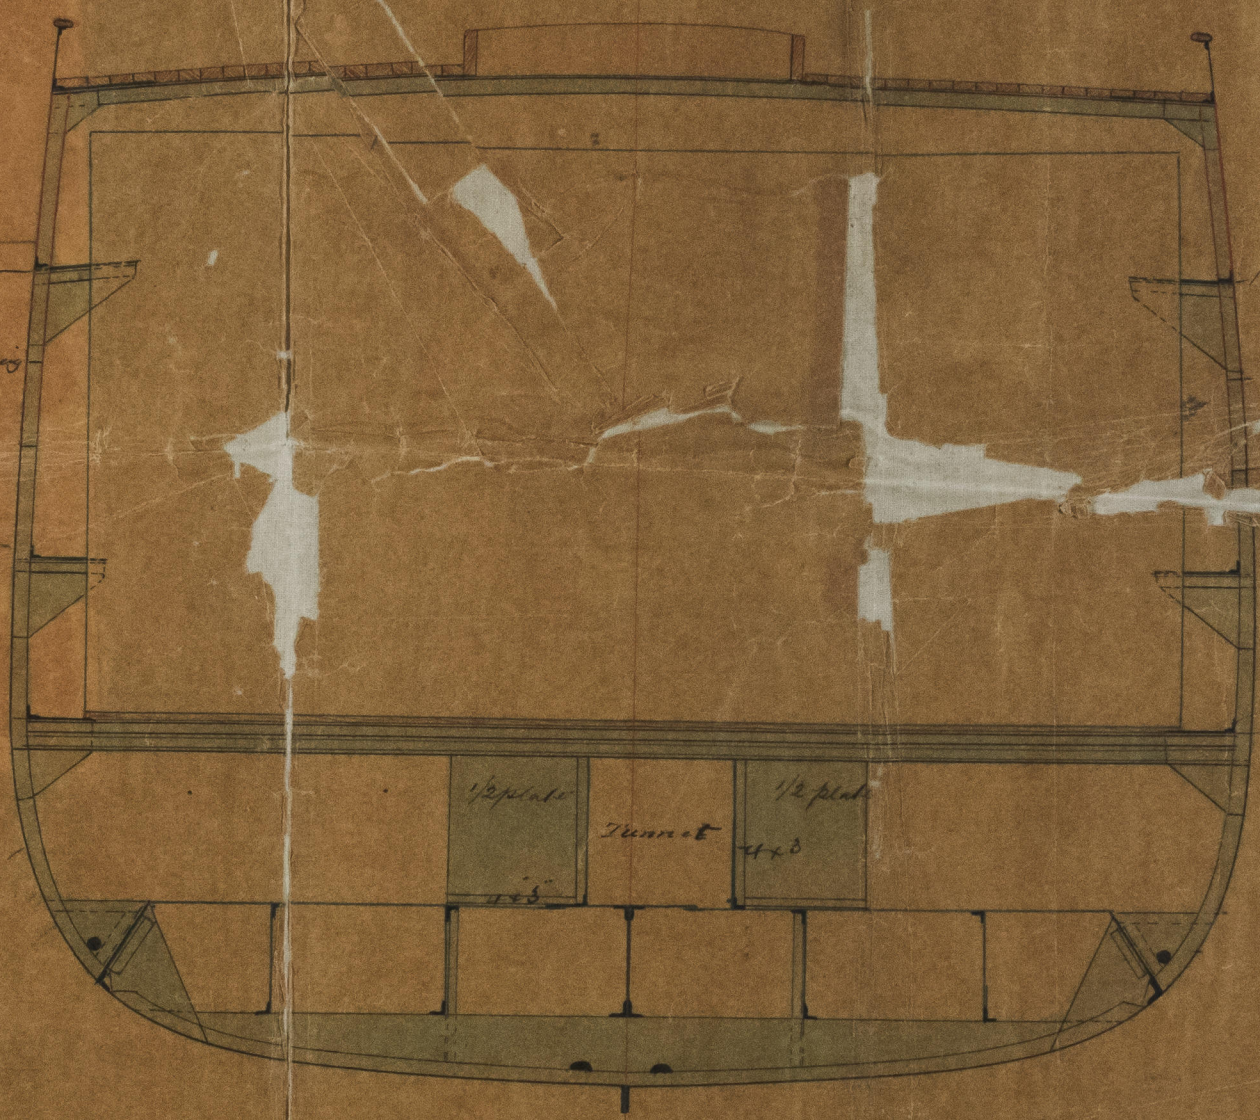

Reversed
 Stringer
 2ft sea
 4ft sea

4x3
 Stringer
 32 ft

1/2 plate
 Transverse
 4x8
 1/2 plate

ALTERATIONS IN



© 2021
 Lloyd's Register
 Foundation

IRON502-0227

"*S. Agnes*"

IRON502-0227



© 2021

Lloyd's Register
Foundation