


Midship Section
 of
 Iron Steam Barge
 for
 Otto Pohl Esq.

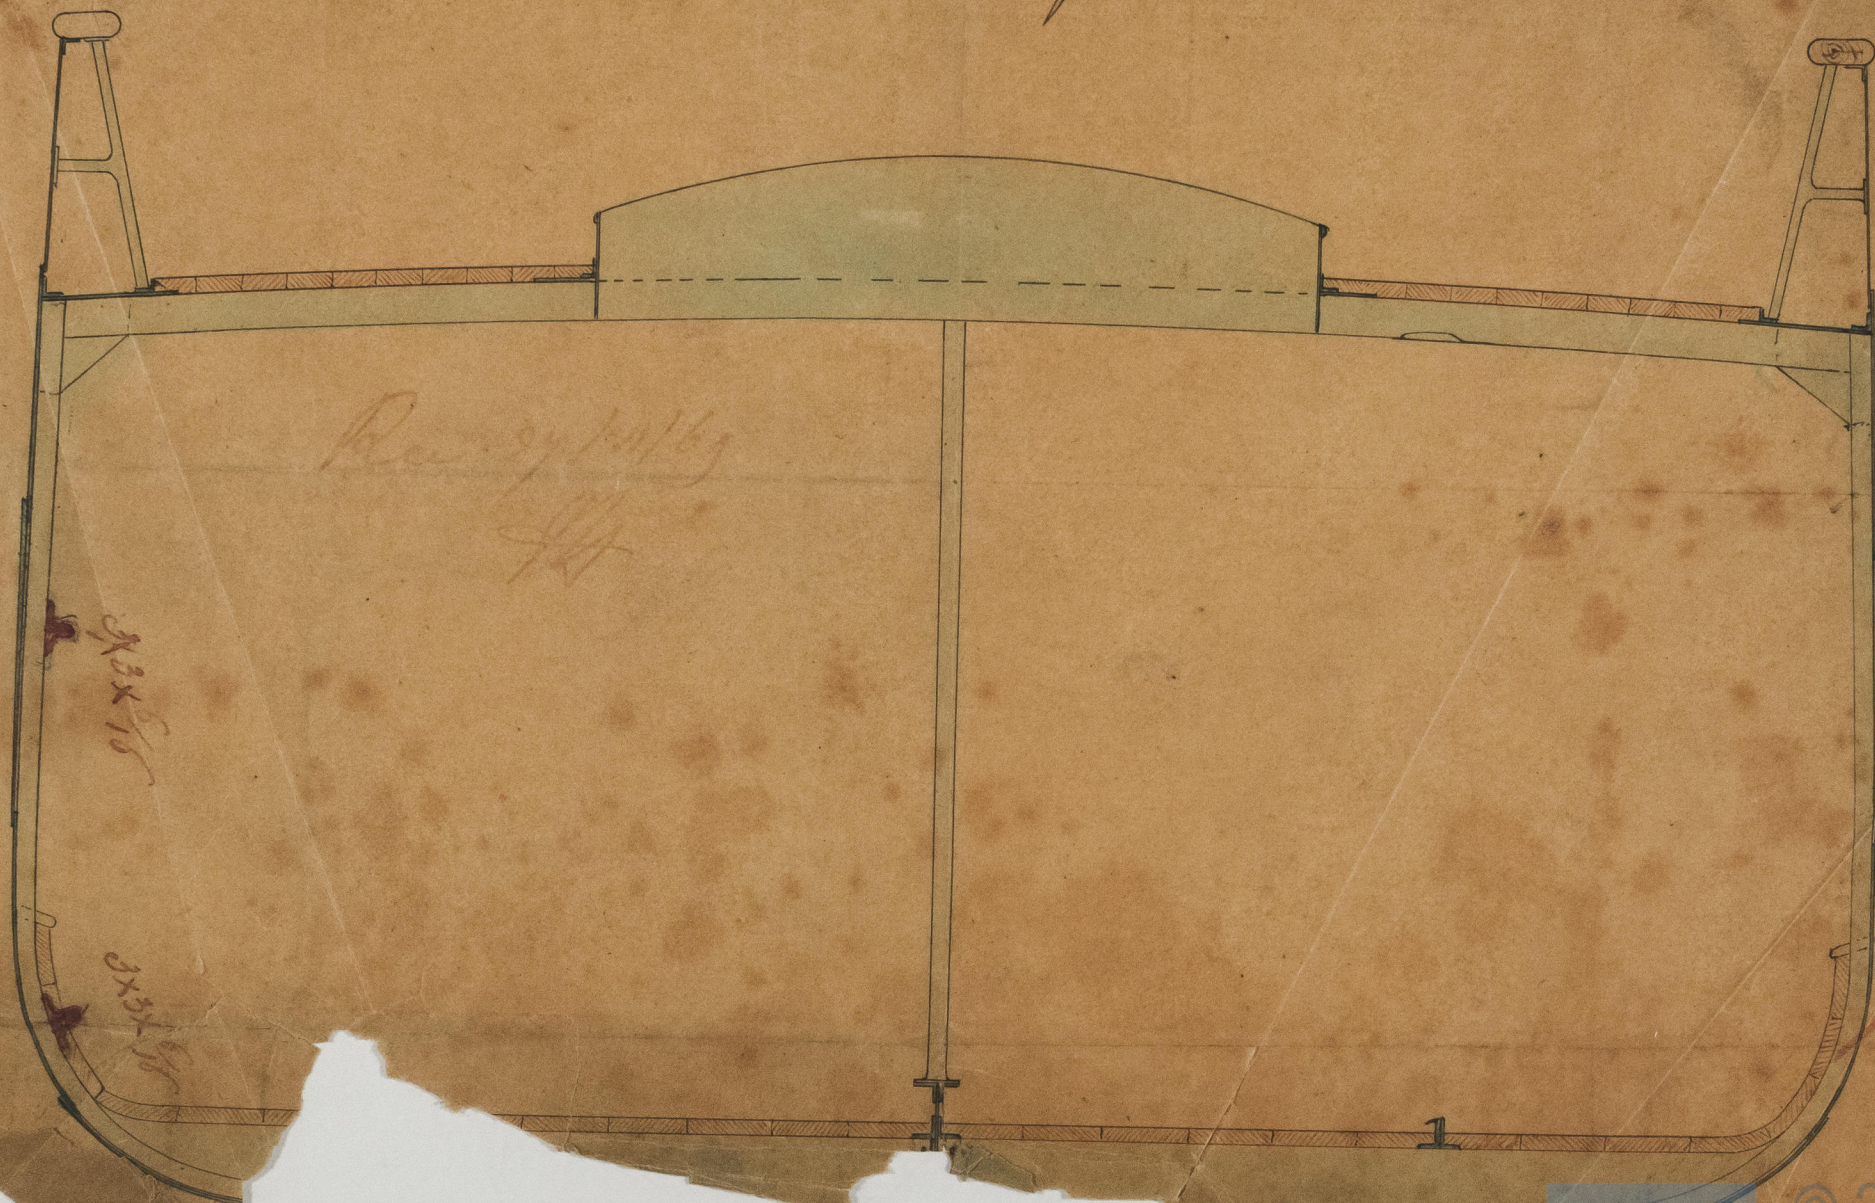

Revised 27/10/69
4/11

3x3-16

3x3-16


IRON 502 - 0254



© 2021

