


Report No. 2044

MIDSHIP SECTION
OF
No. 95.S.S.

Rec 3/11/69 & 28/4/70

No. 1267

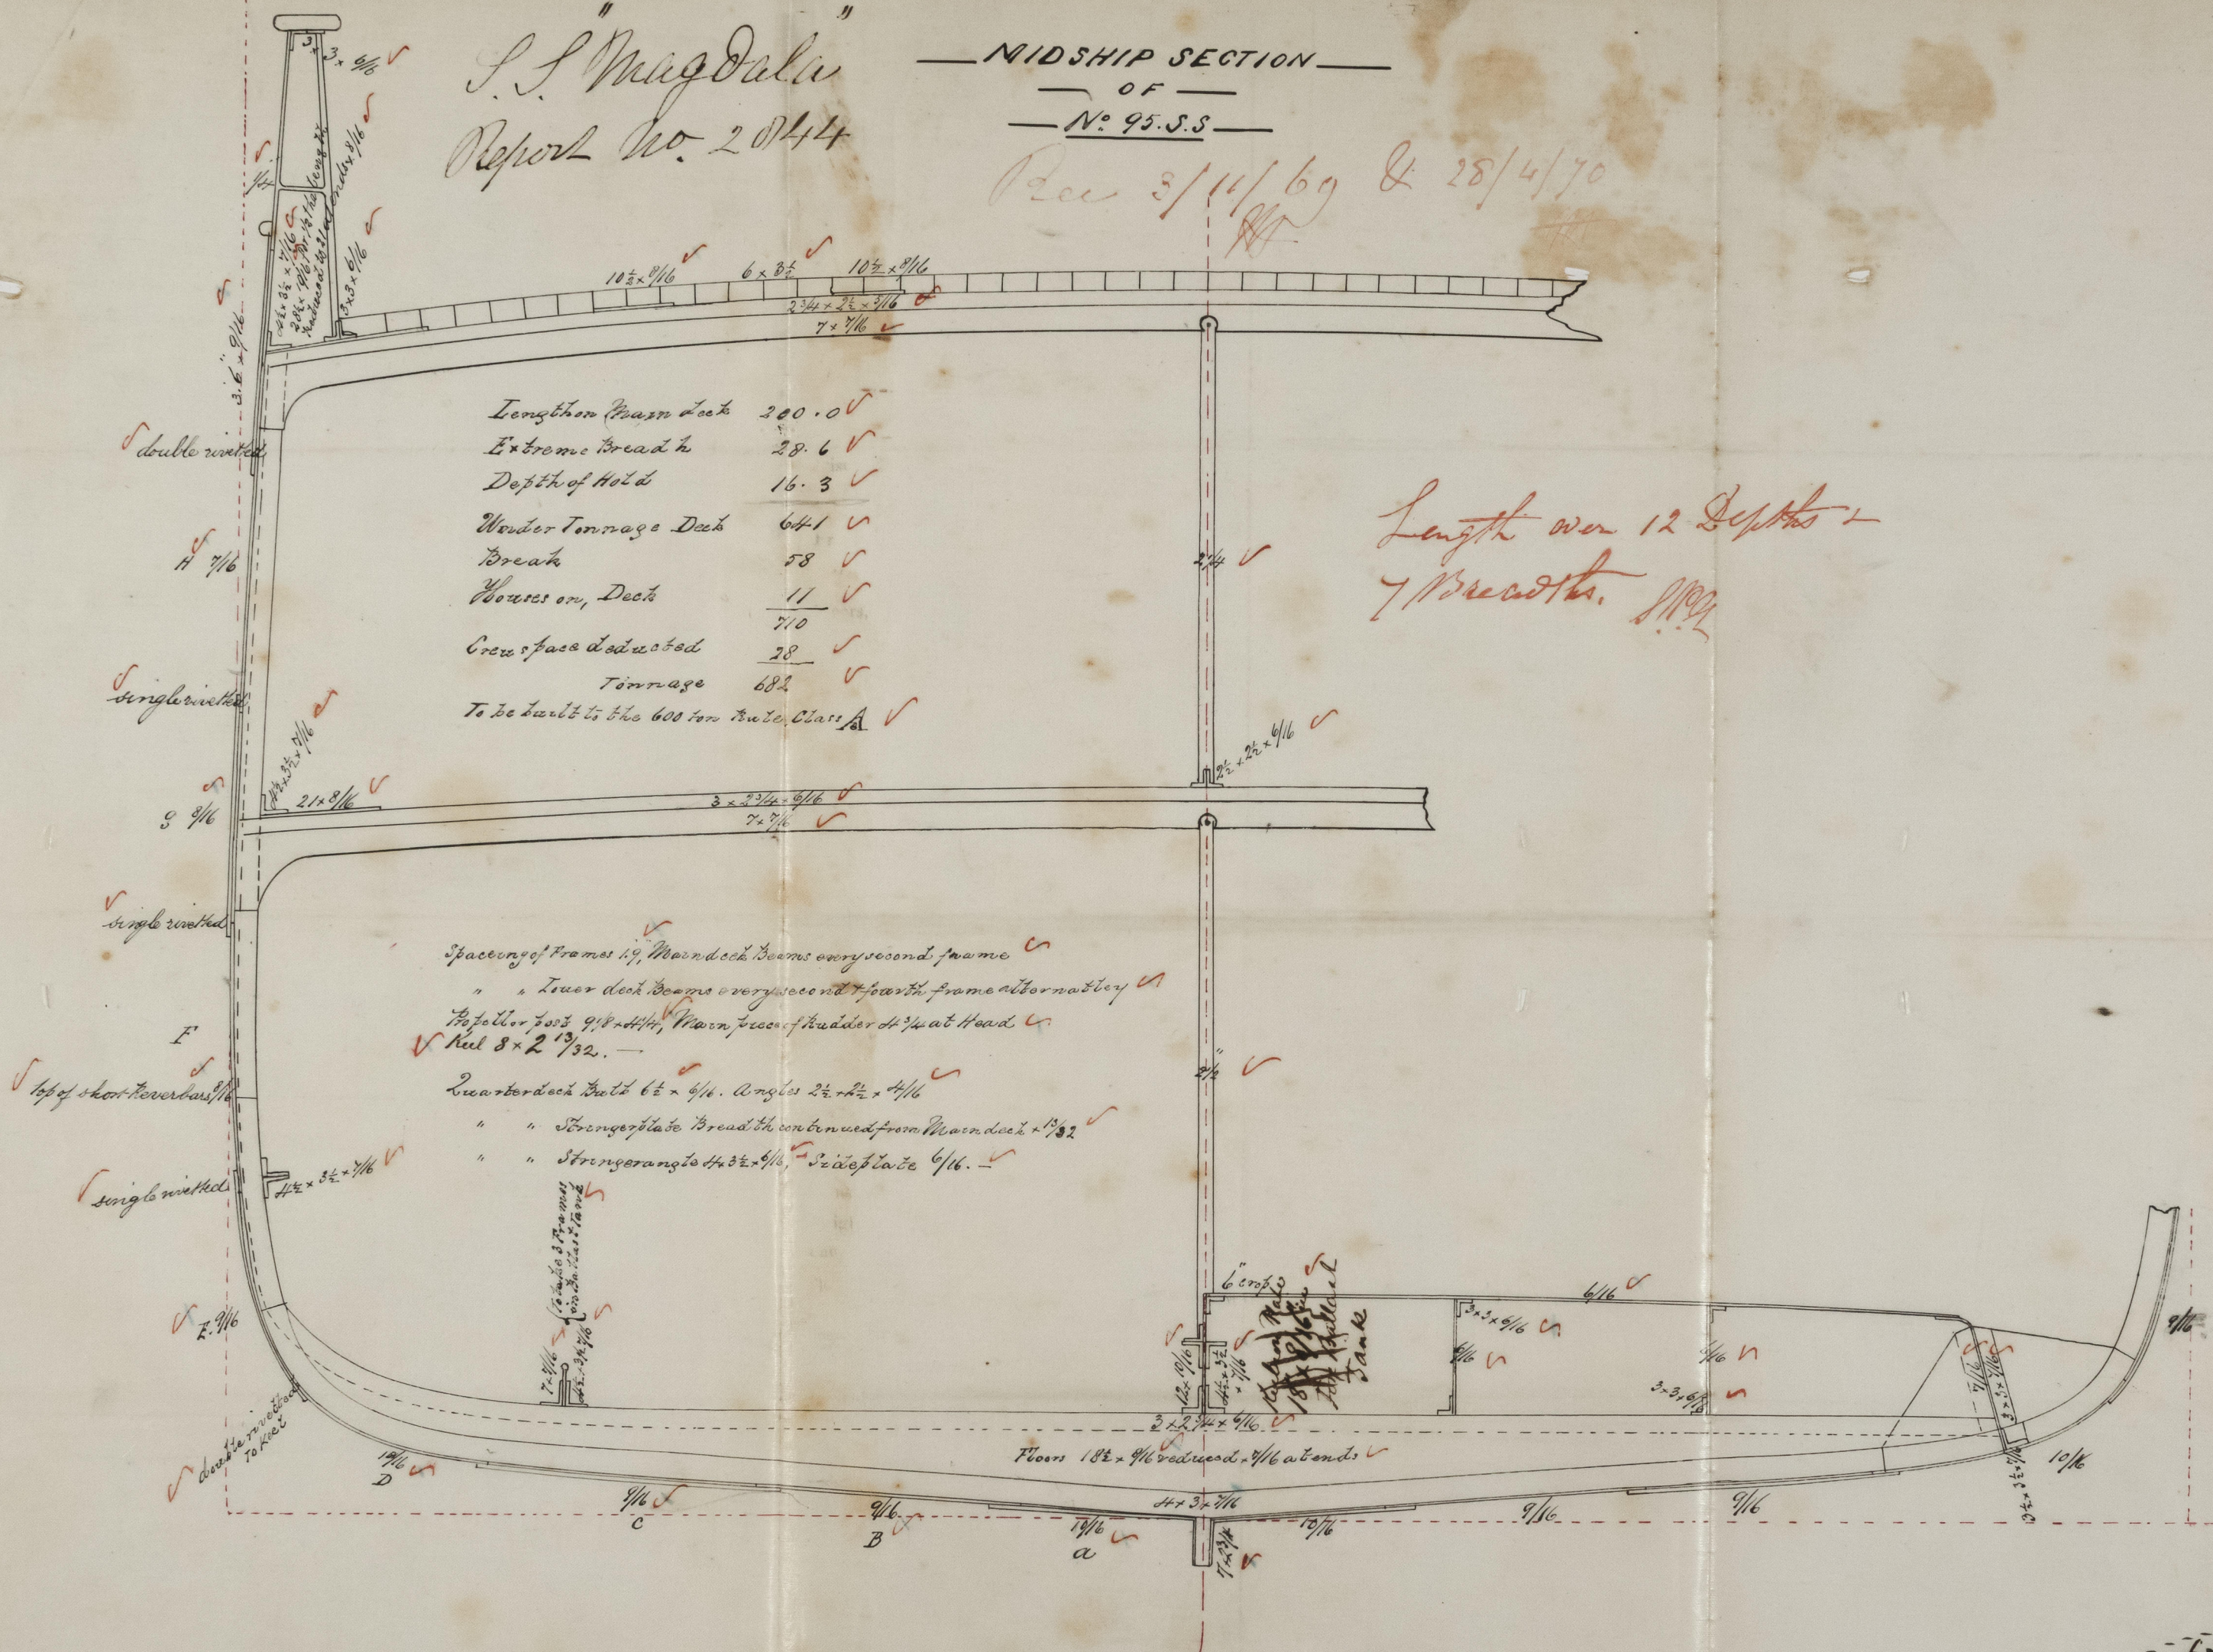




IRON 502 0256

