


Midship Section of No. 104 S.S.
 Length --- 200' 0" 200' 5"
 Breadth --- 28' 0" 28' 4"
 Depth of Hold = 14' 0" (Note this depth in ship is 13.7)
 Tonnage under tonnage deck 460 tons 499' 1/4"
 Tonnage Gross --- 770 tons 823' 5/6"
 No Class A

Rec 28/1/70

HA

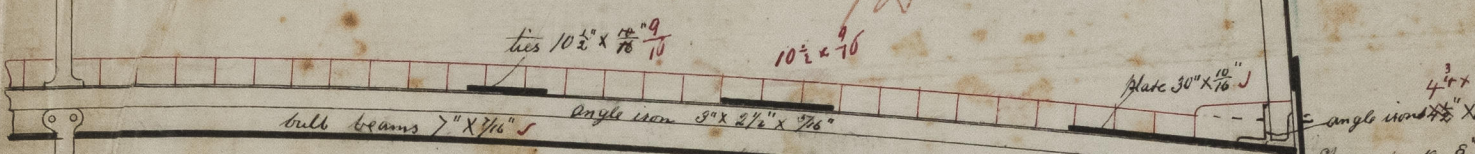

Sheer strake 8" doubled for
 three-fourths length of
 vessel and ships with 1/2" plate



Height of Transverse
 and alternate to
 main deck stringer
 Bars


height of every alternate
 Reverse bar every other
 to main deck

height of double rivetting

Blackwood & Gordon
 Castle Building Yard
 Port Glasgow
 28/1/70

29th Jan 1870
 B.C.

Hand copy made
 for the owners 19/1/01

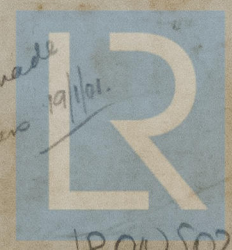

© 2021
 Lloyd's Register
 Foundation

1R0U502-0314