

25th

01



Wpt.

Dec 28/70

Main Deck

4/6/70

Lower Deck

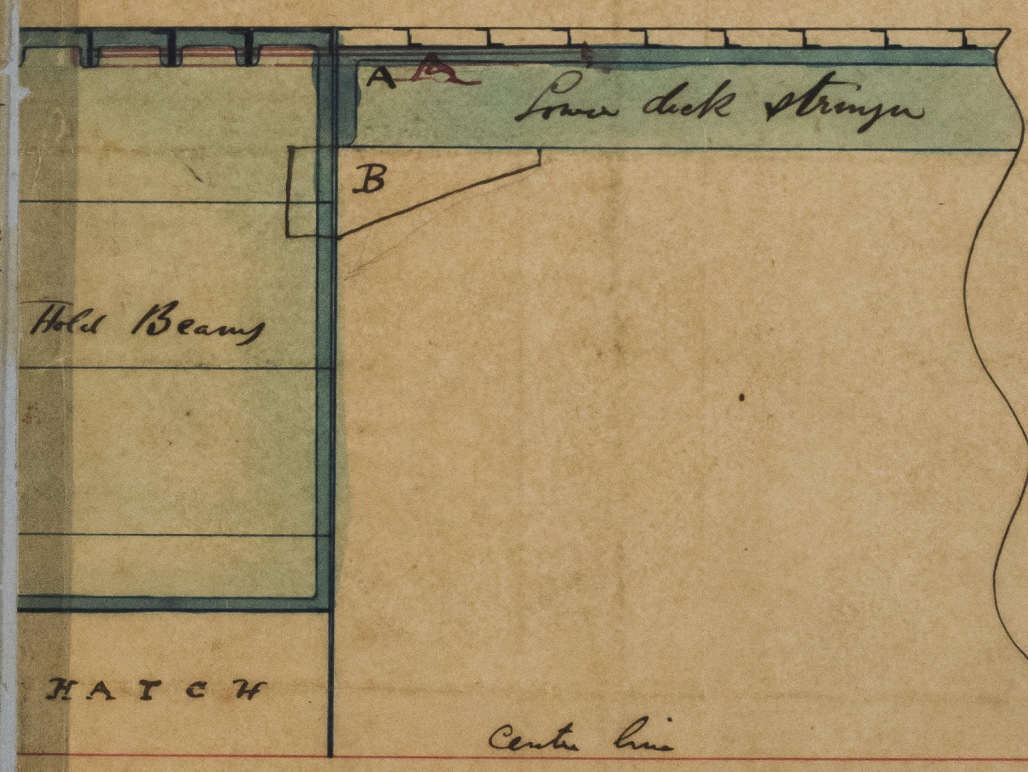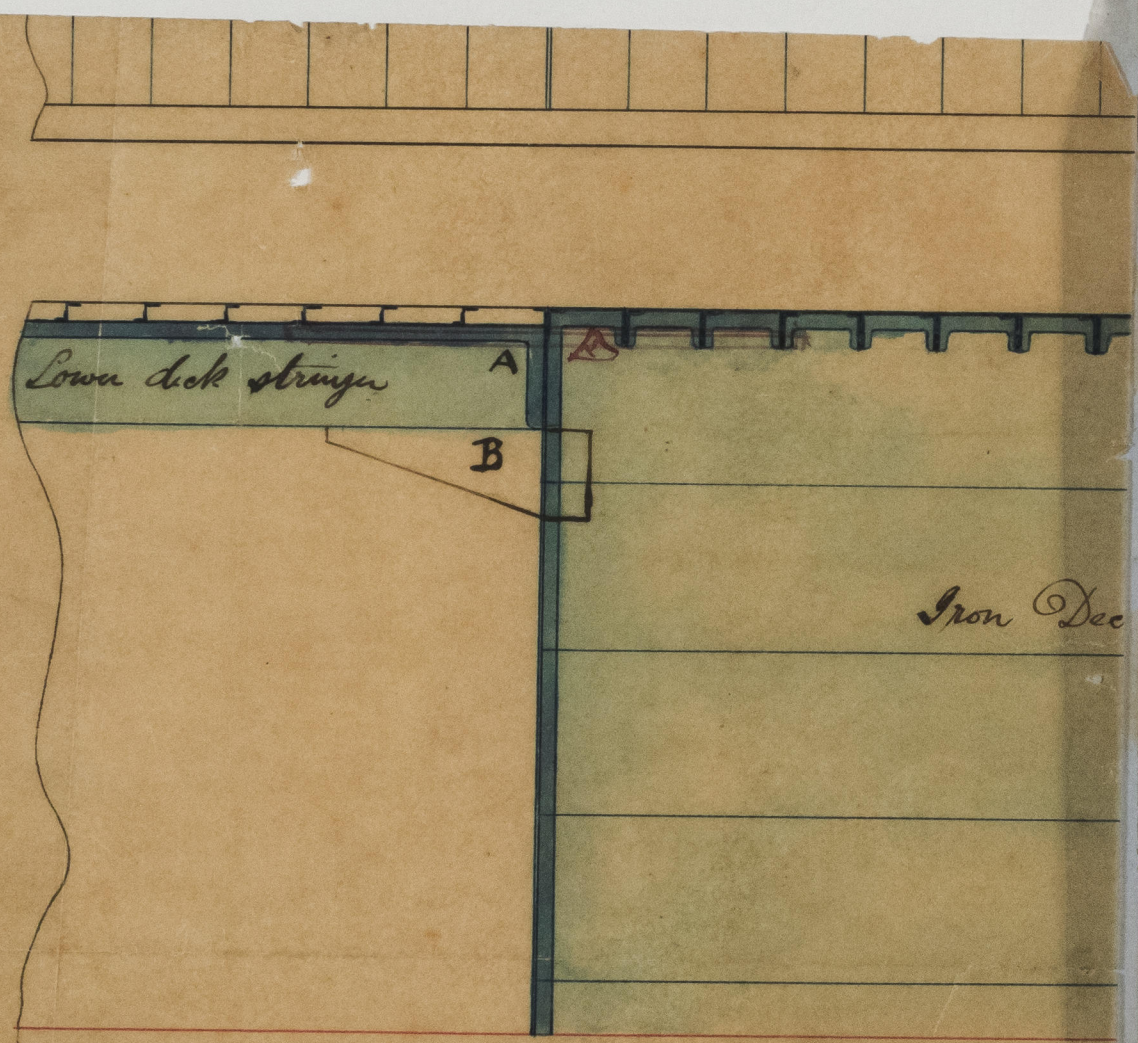

ALEX^R STEPHEN & SONS.

SHIP BUILDERS. © 2021

GLASGOW

May 20. 1870

Lloyd's Register
Foundry

IRON 502-0313 1/2

0313 1/2