


12<sup>th</sup> Jan<sup>y</sup> 1870

*Midships Section of Nos. 255 & 256.*

SCALE  $\frac{1}{2}$  INCH TO A FOOT.

Length of Poop- 82 ft. 0 in.      Length of Forecastle 34 ft. 0 in.  
Depth      "      4. 6 -      Depth      "      6. 9.

Rec. 24/2/70

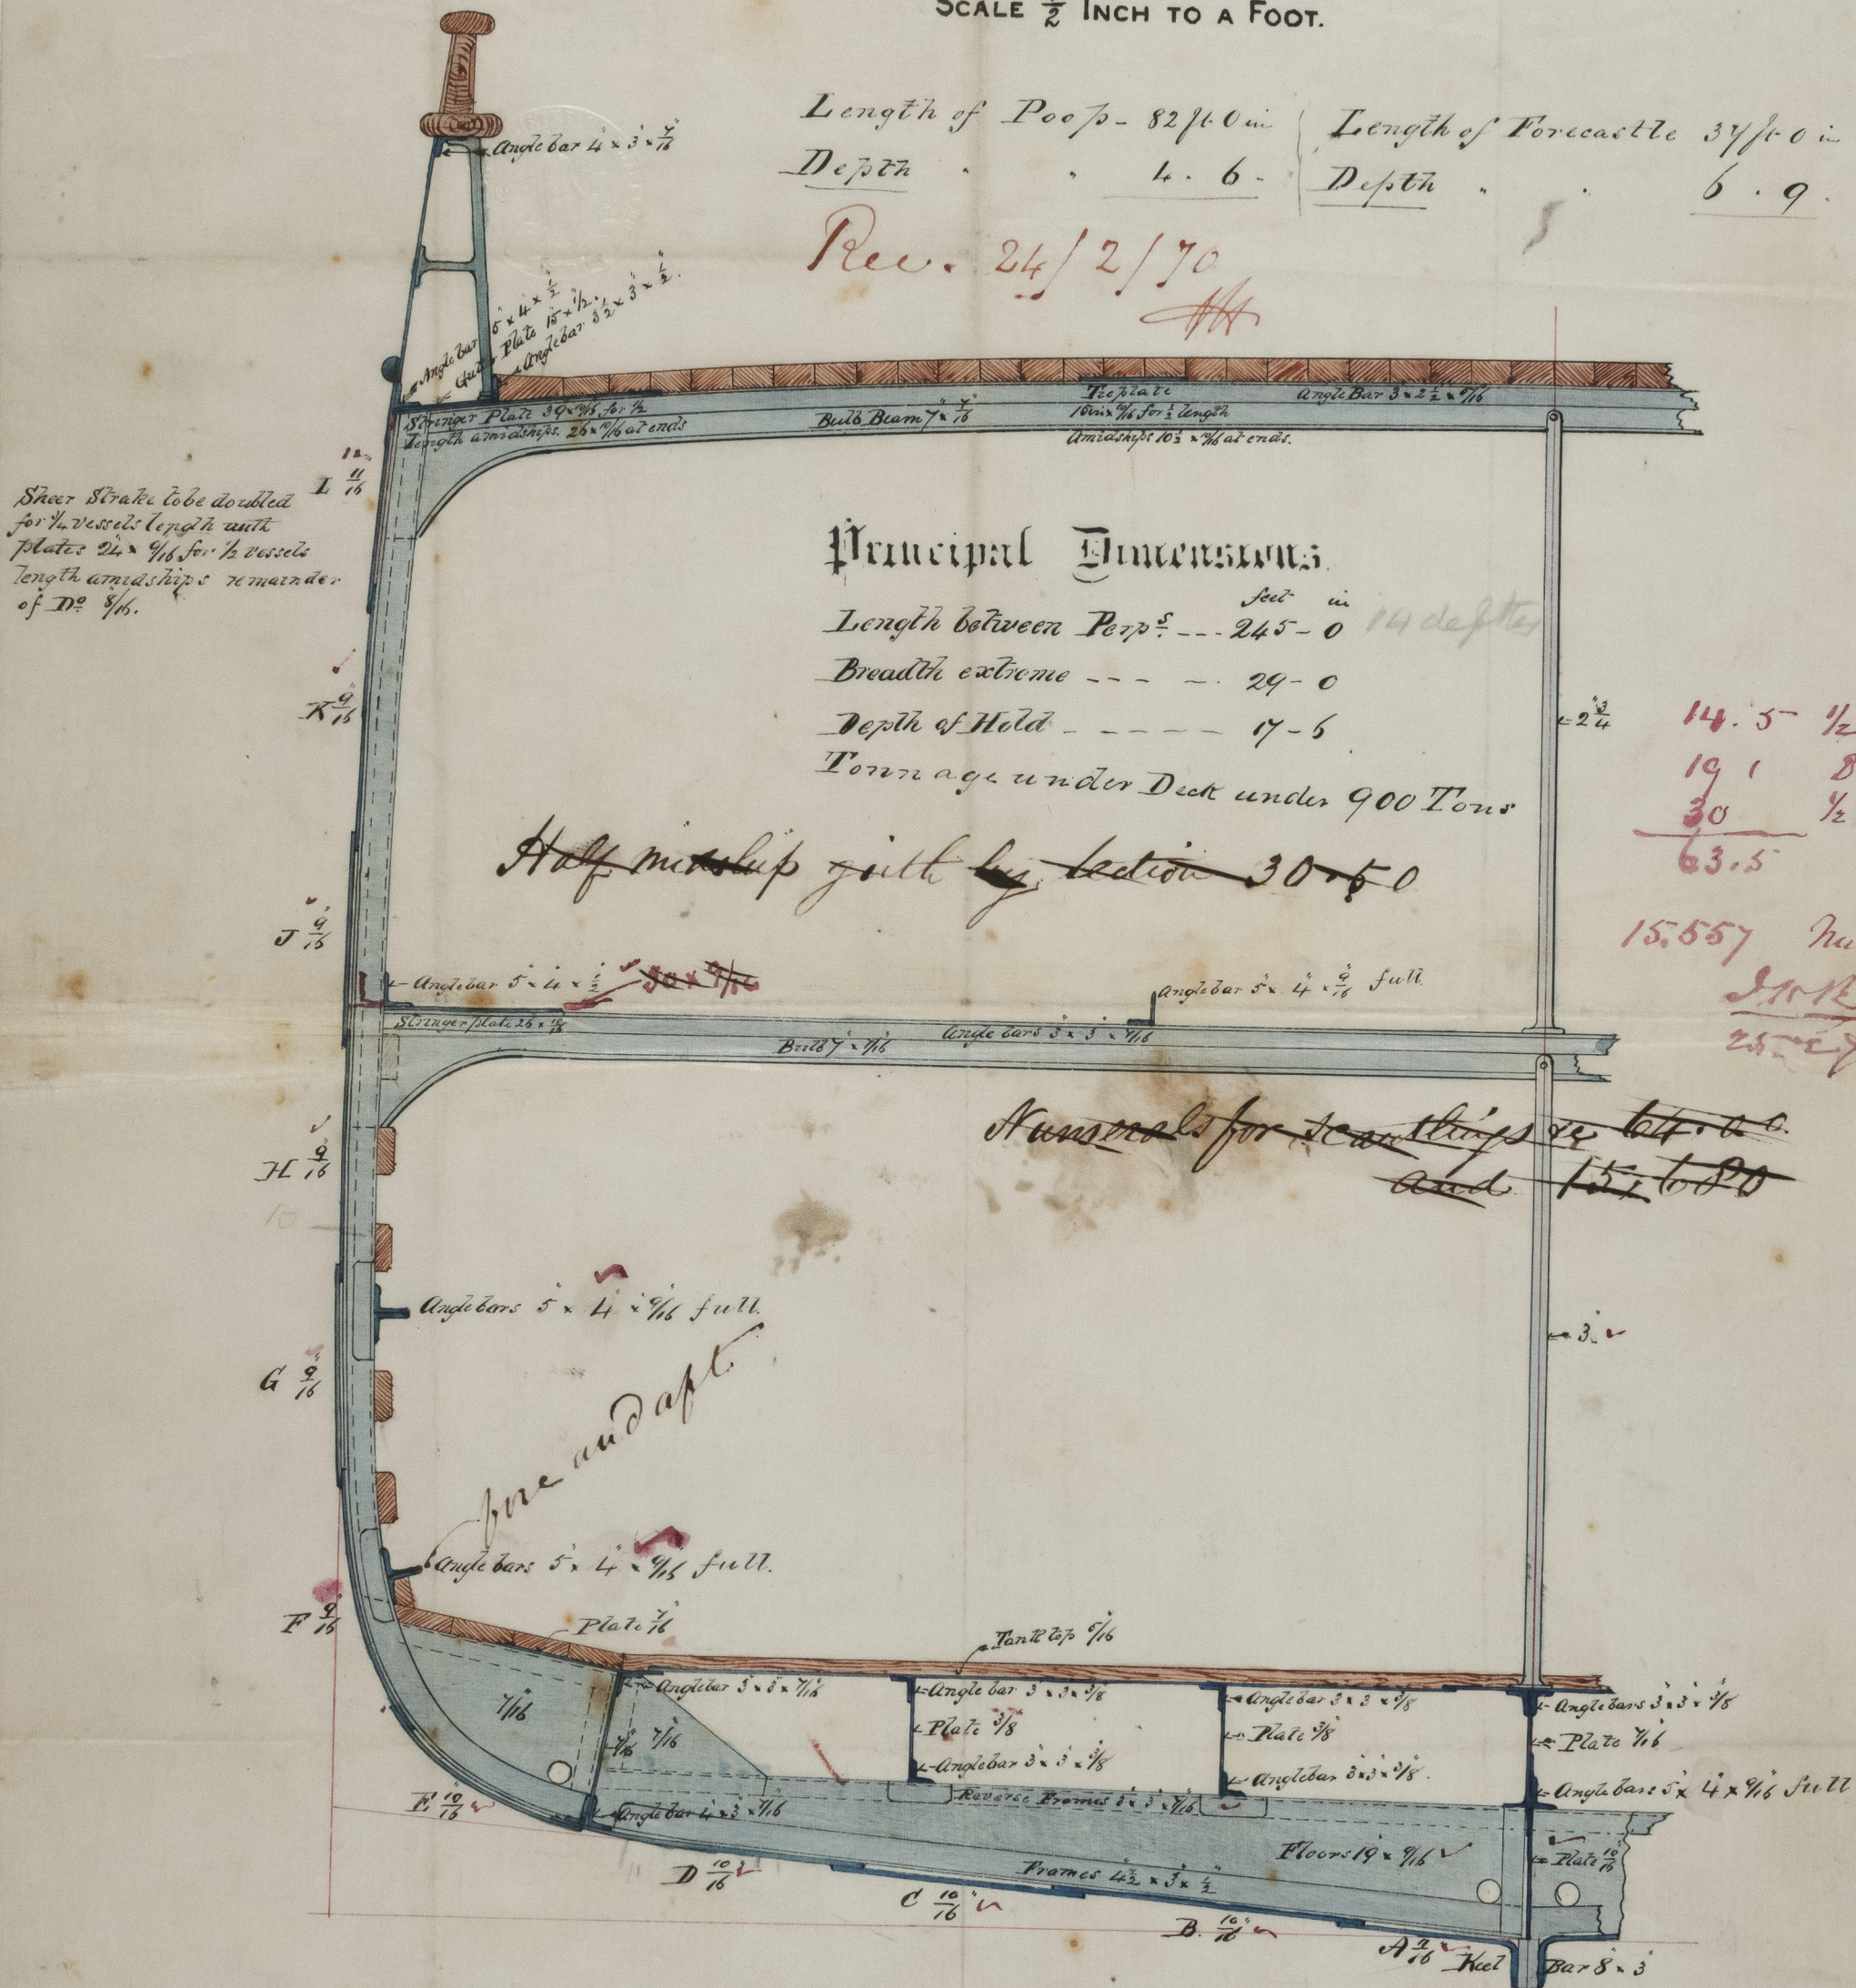

