


Nos 9.693 /
No 55

TRACING No 643

DIMENSIONS

Length BP	175.3
Breadth	25.0
Depth Moulded	15.10 $\frac{3}{4}$
Length of After Tank	31.6
Do Fore Tank	33.3

CZ25890A

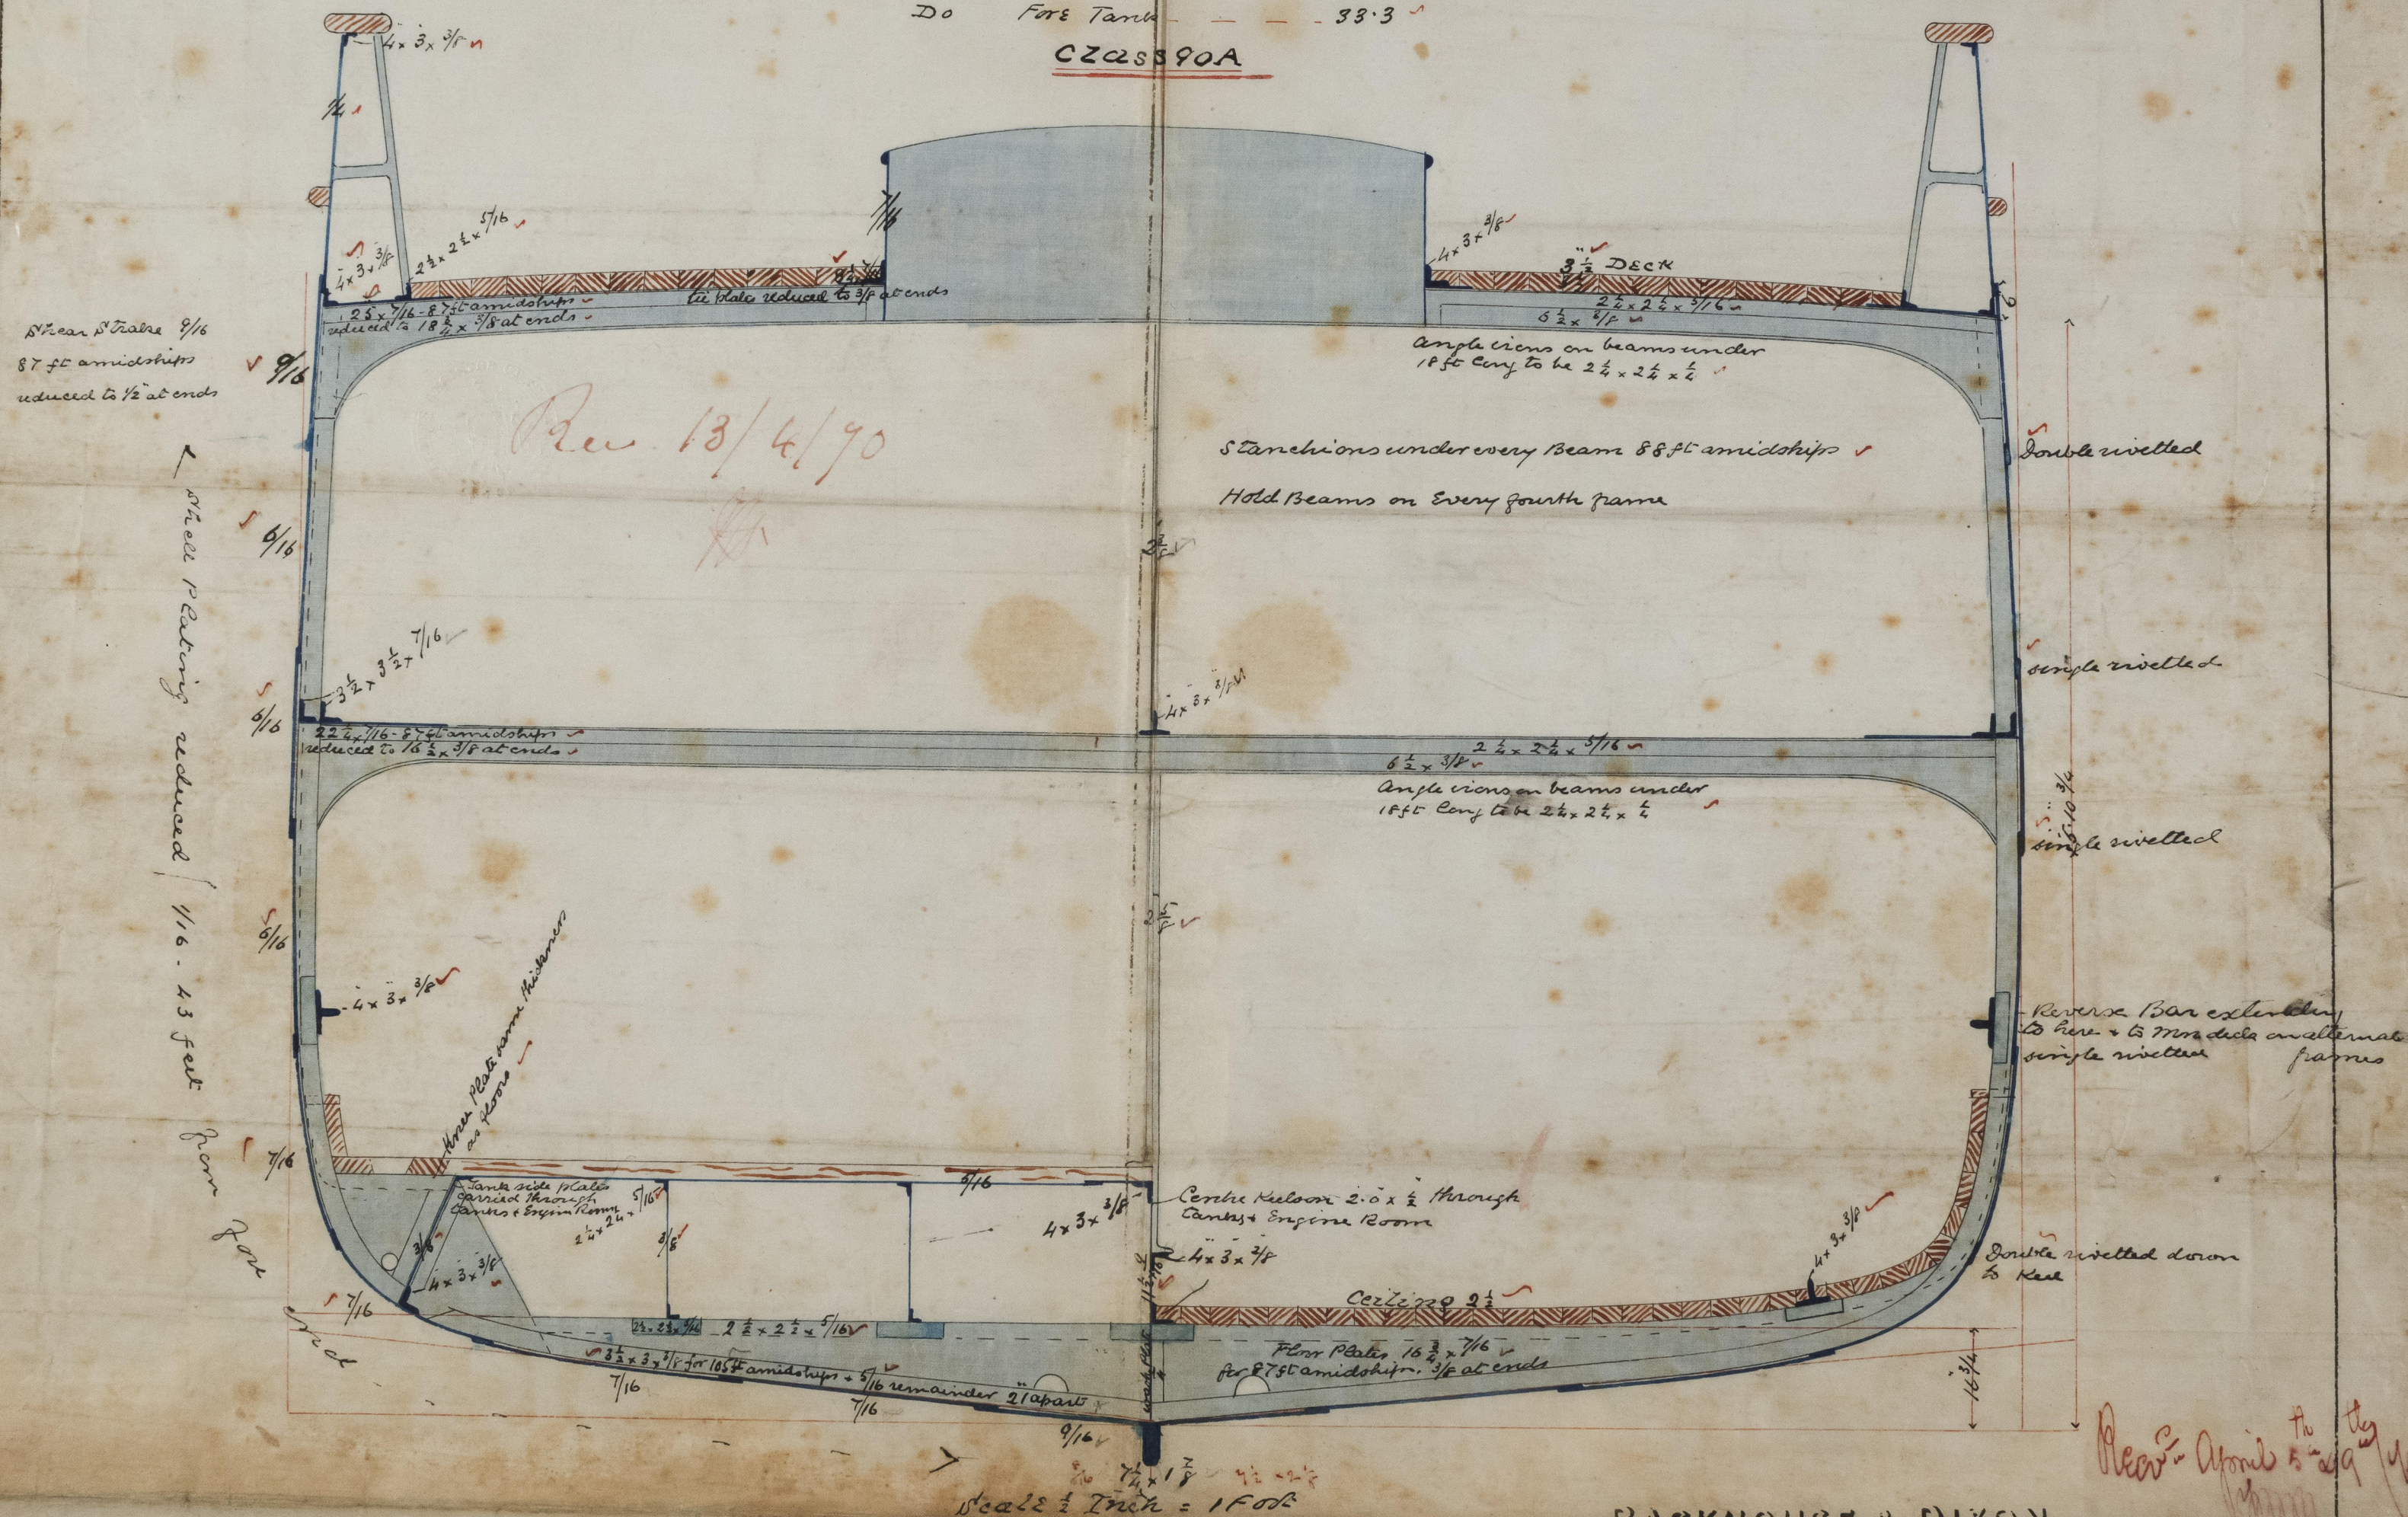

Scale $\frac{1}{2}$ Inch = 1 Foot

BACKHOUSE & DIXON,
IRON SHIP BUILDERS,
MIDDLESBROUGH-ON-TEES.

Lloyd's Register
Foundation

IRON 502-0323