

Midsction

Nov 9 1897

Scale $\frac{1}{2}$ Inch = 1 foot


Length between $\frac{1}{2}$ 206-0

Beam 28-0

Hold 17-2




2118

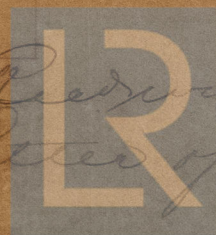

© 2021
Lloyd's Register
Foundation

IRON 502-0324

65.

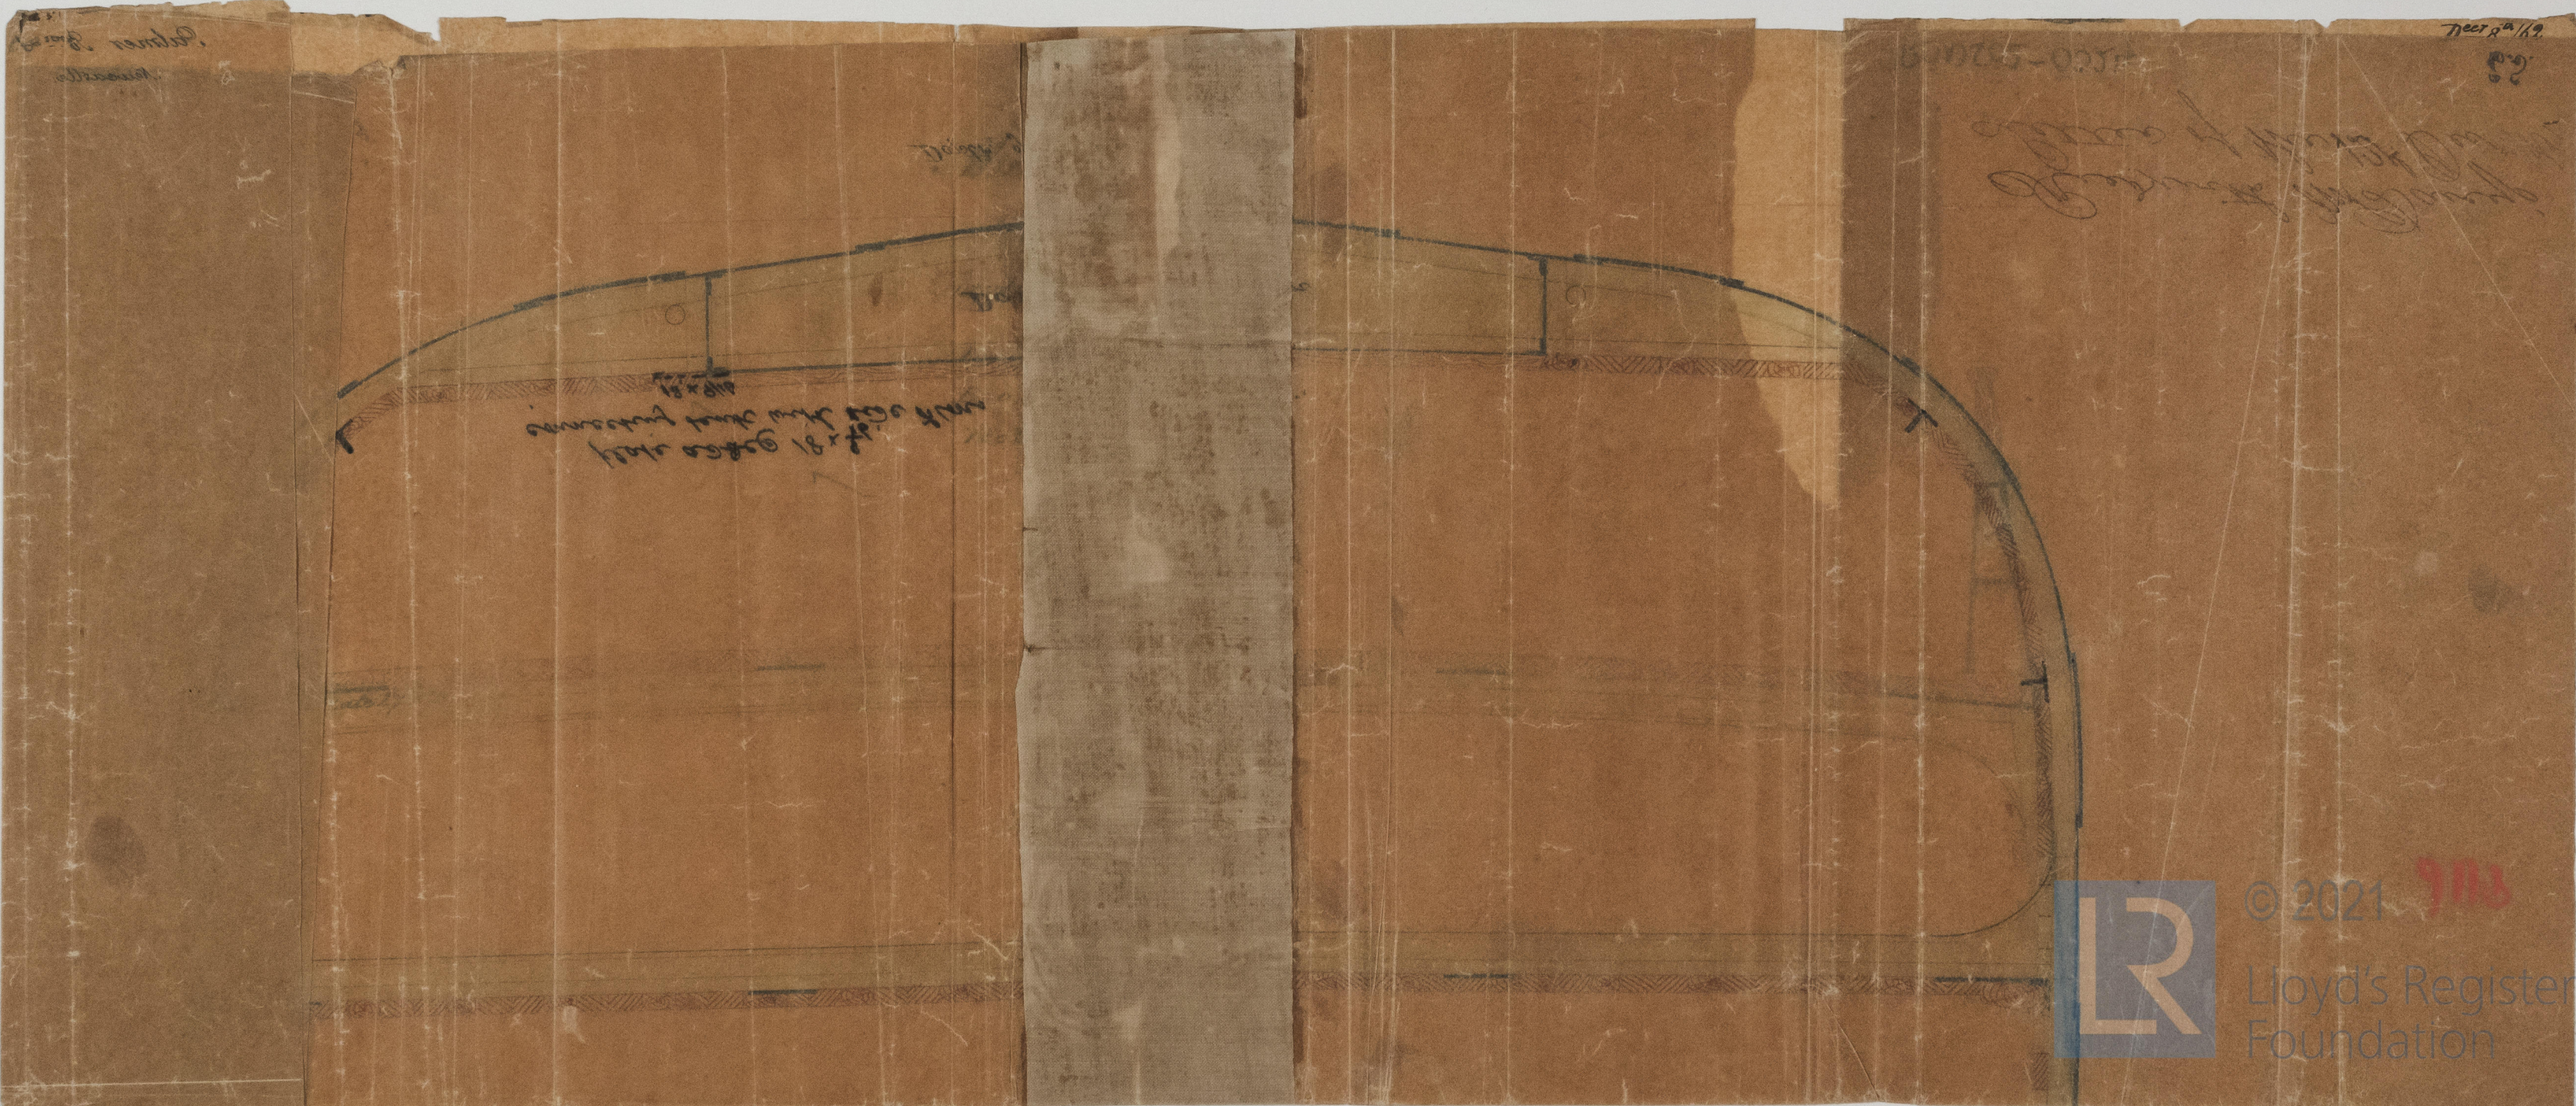









© 2021
Lloyd's Register
Foundation